
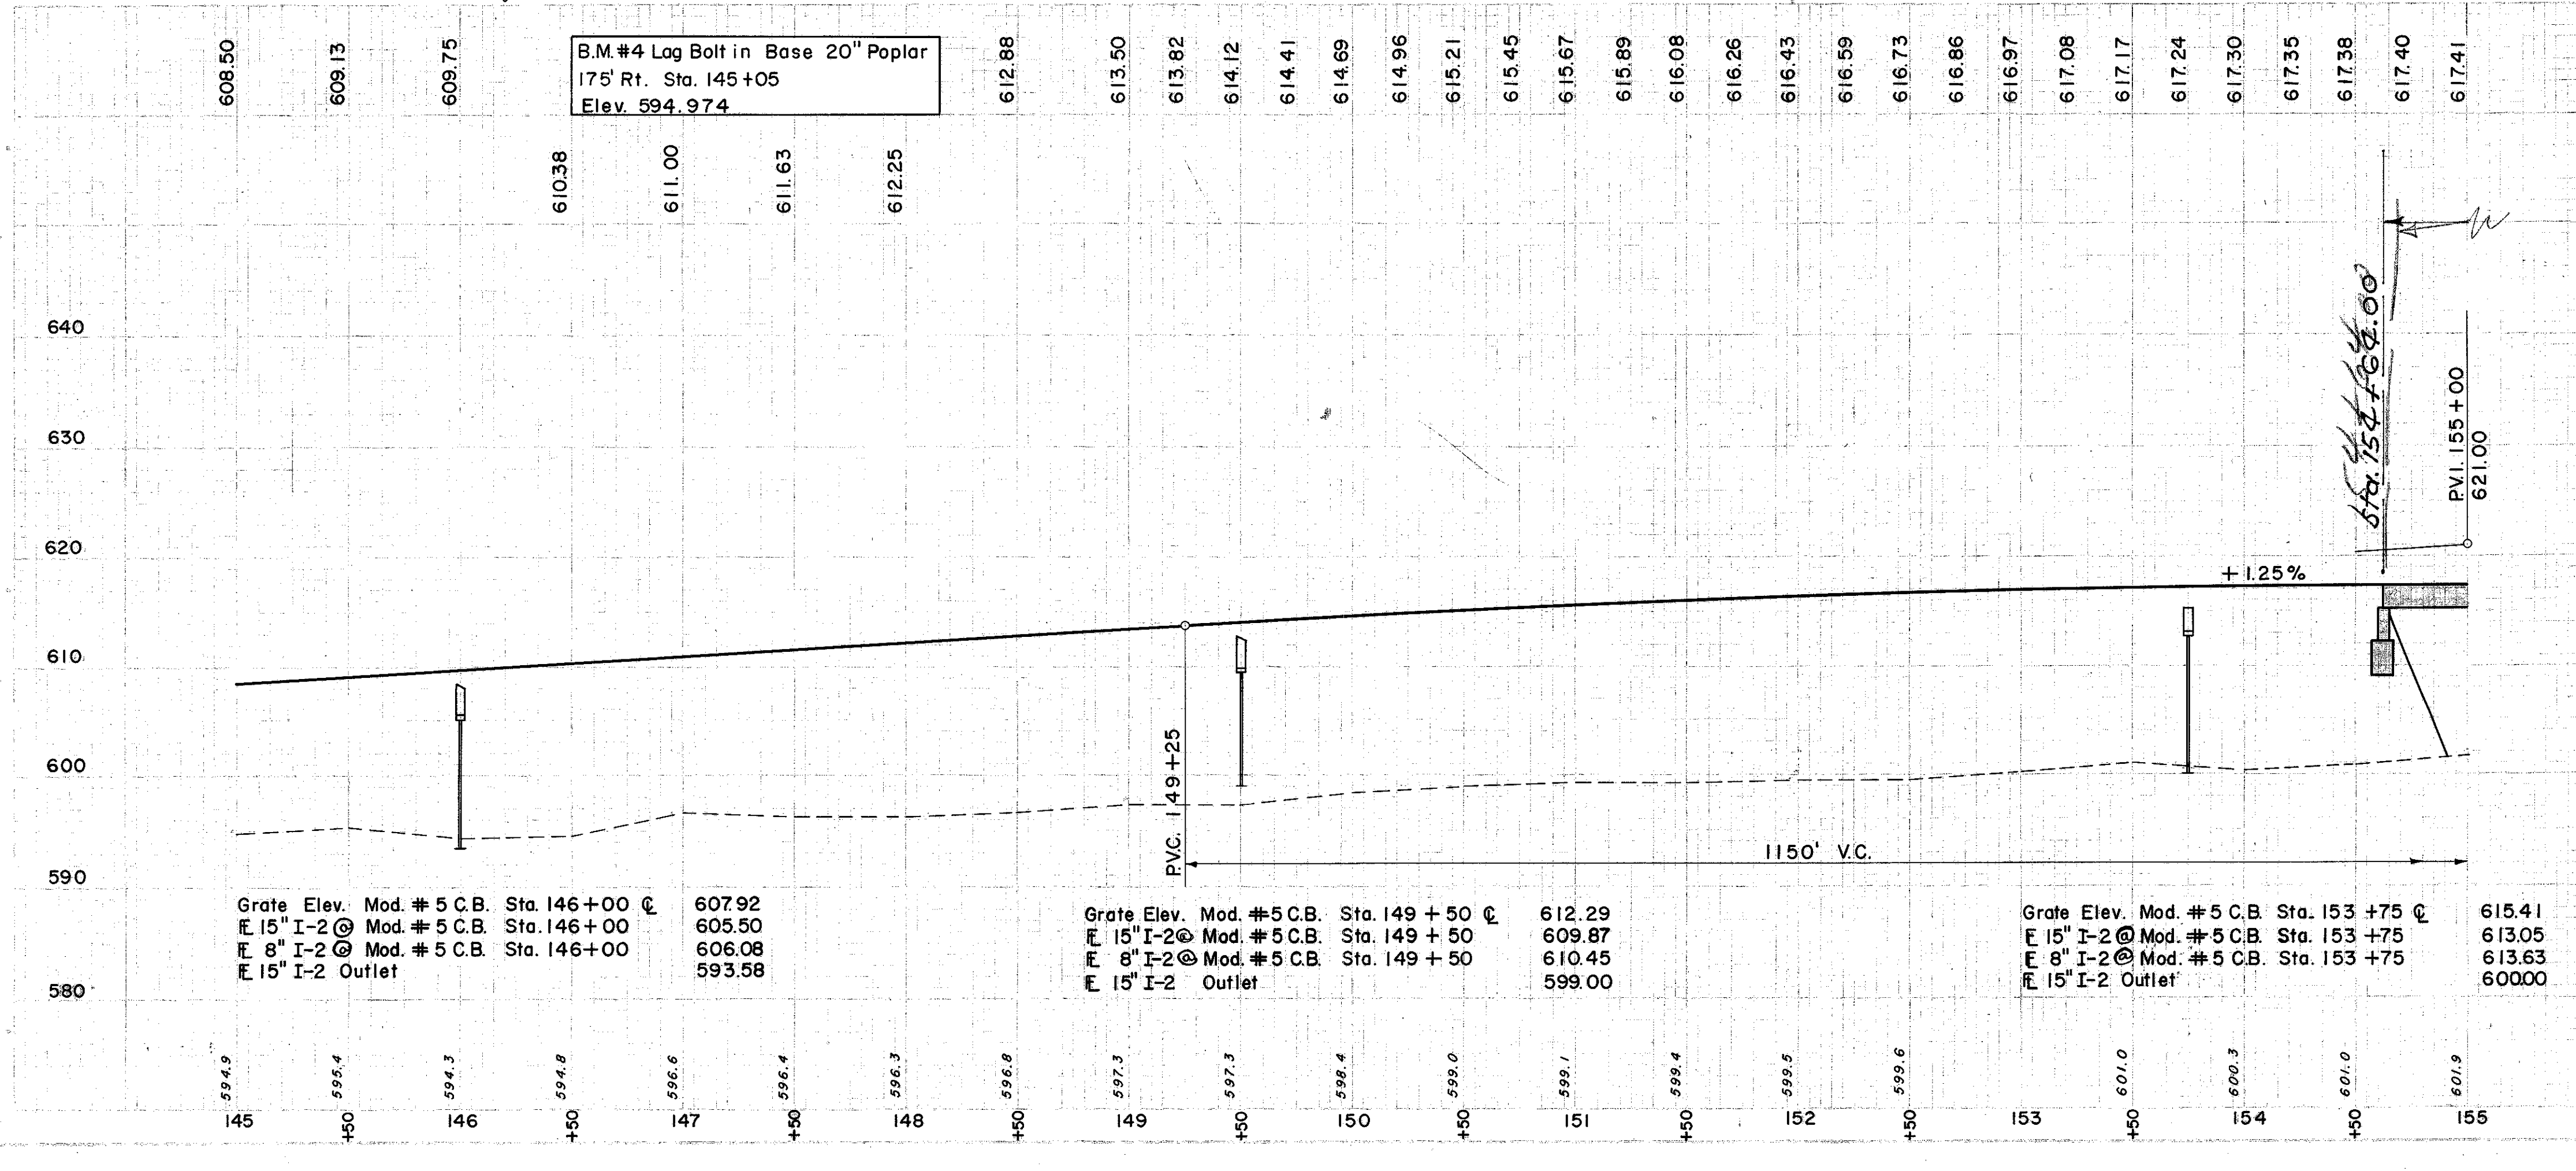


FOR DETAILS OF CELLULAR
RETAINING WALL
SEE SHEET NO. 229-A

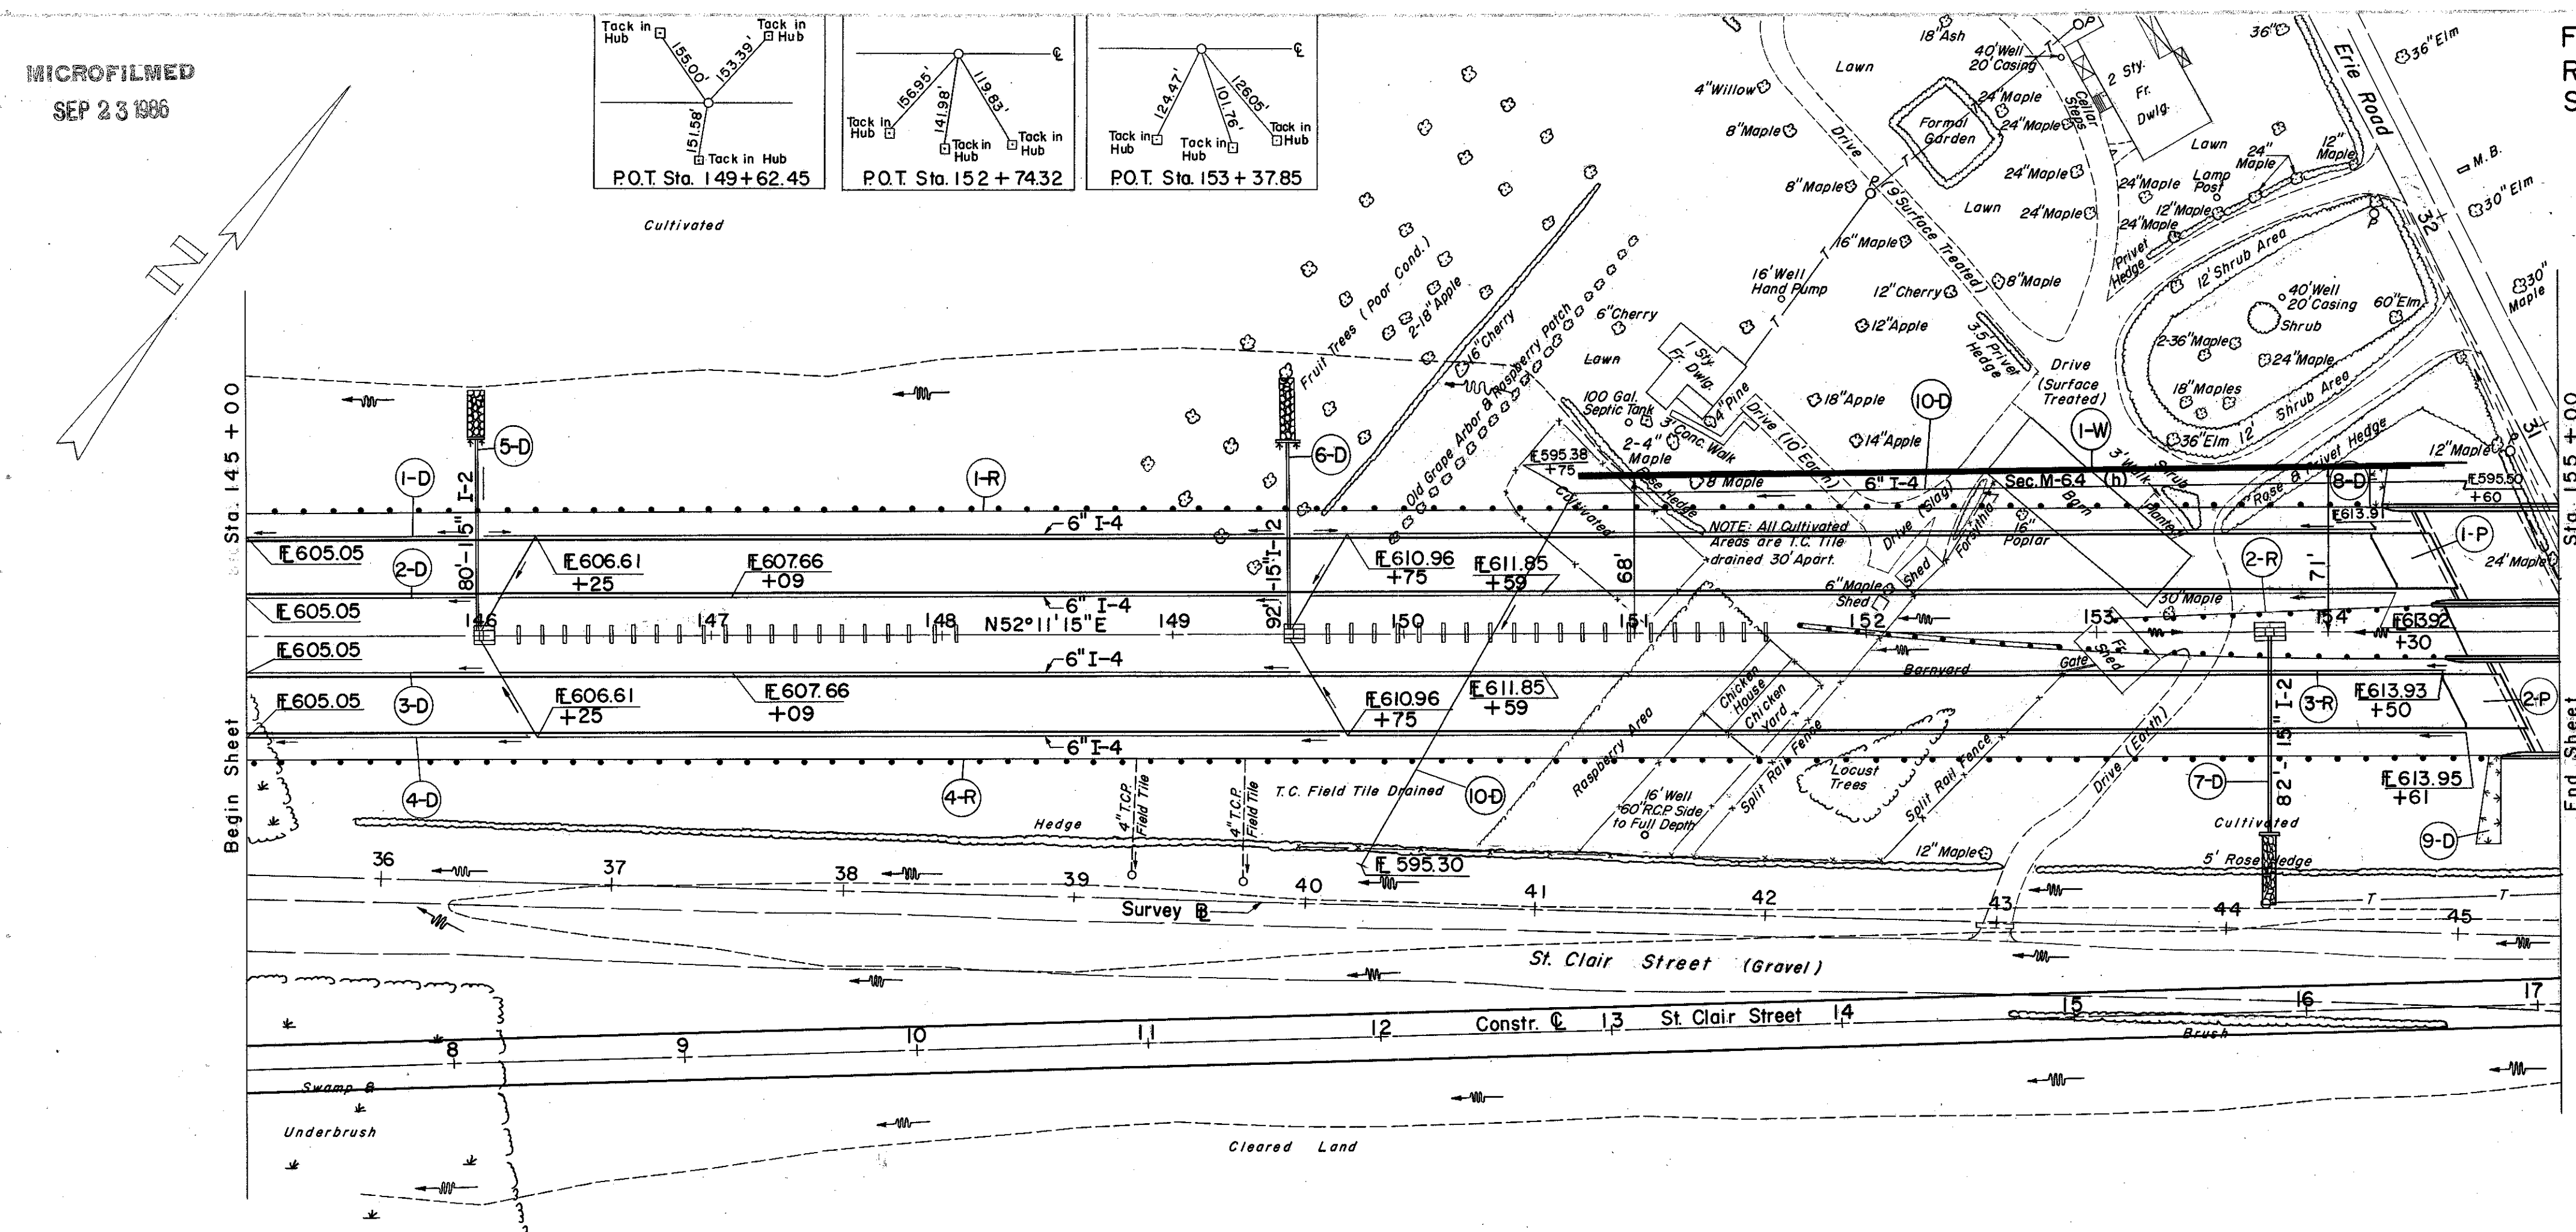

(D) DRAINAGE








EXCAVATION	2,370	C.Y.
EMBANKMENT	78,990	C.Y.
EMBANKMENT	94,788	C.Y.