


FED. RD. DIVISION	STATE	PROJECT
2	OHIO	F-U-329 (15)

LAK - 2 - 4.42
R/W PLAN
LIMITED ACCESS

S-24 REMOVAL OF STRUCTURES

PARCEL 44 LA	I	I	STY. FRAME DWELLING
PARCEL 44	I	I	FRAME GARAGE
PARCEL 45 LA	I	I	STY. FRAME DWELLING
PARCEL 46 LA	I	I	STY. FRAME DWELLING
PARCEL 47 LA	I	I	STY. FRAME DWELLING
PARCEL 48 LA	I	I	STY. FRAME DWELLING

DATE	REVISED
12-5-58	SUBMITTED FOR APPROVAL
12-12-58	ADDED S-24 ITEMS, R/W FENCE, RESIDUE AREAS, CALLS
3-17-59	R/W LINES REVISED ON S.R. 306
	PROPERTY OWNER REVISED 39 LA
4-14-59	ADDED RELOC. ST. CLAIR ST. - 60' WIDE
4-24-59	FINAL

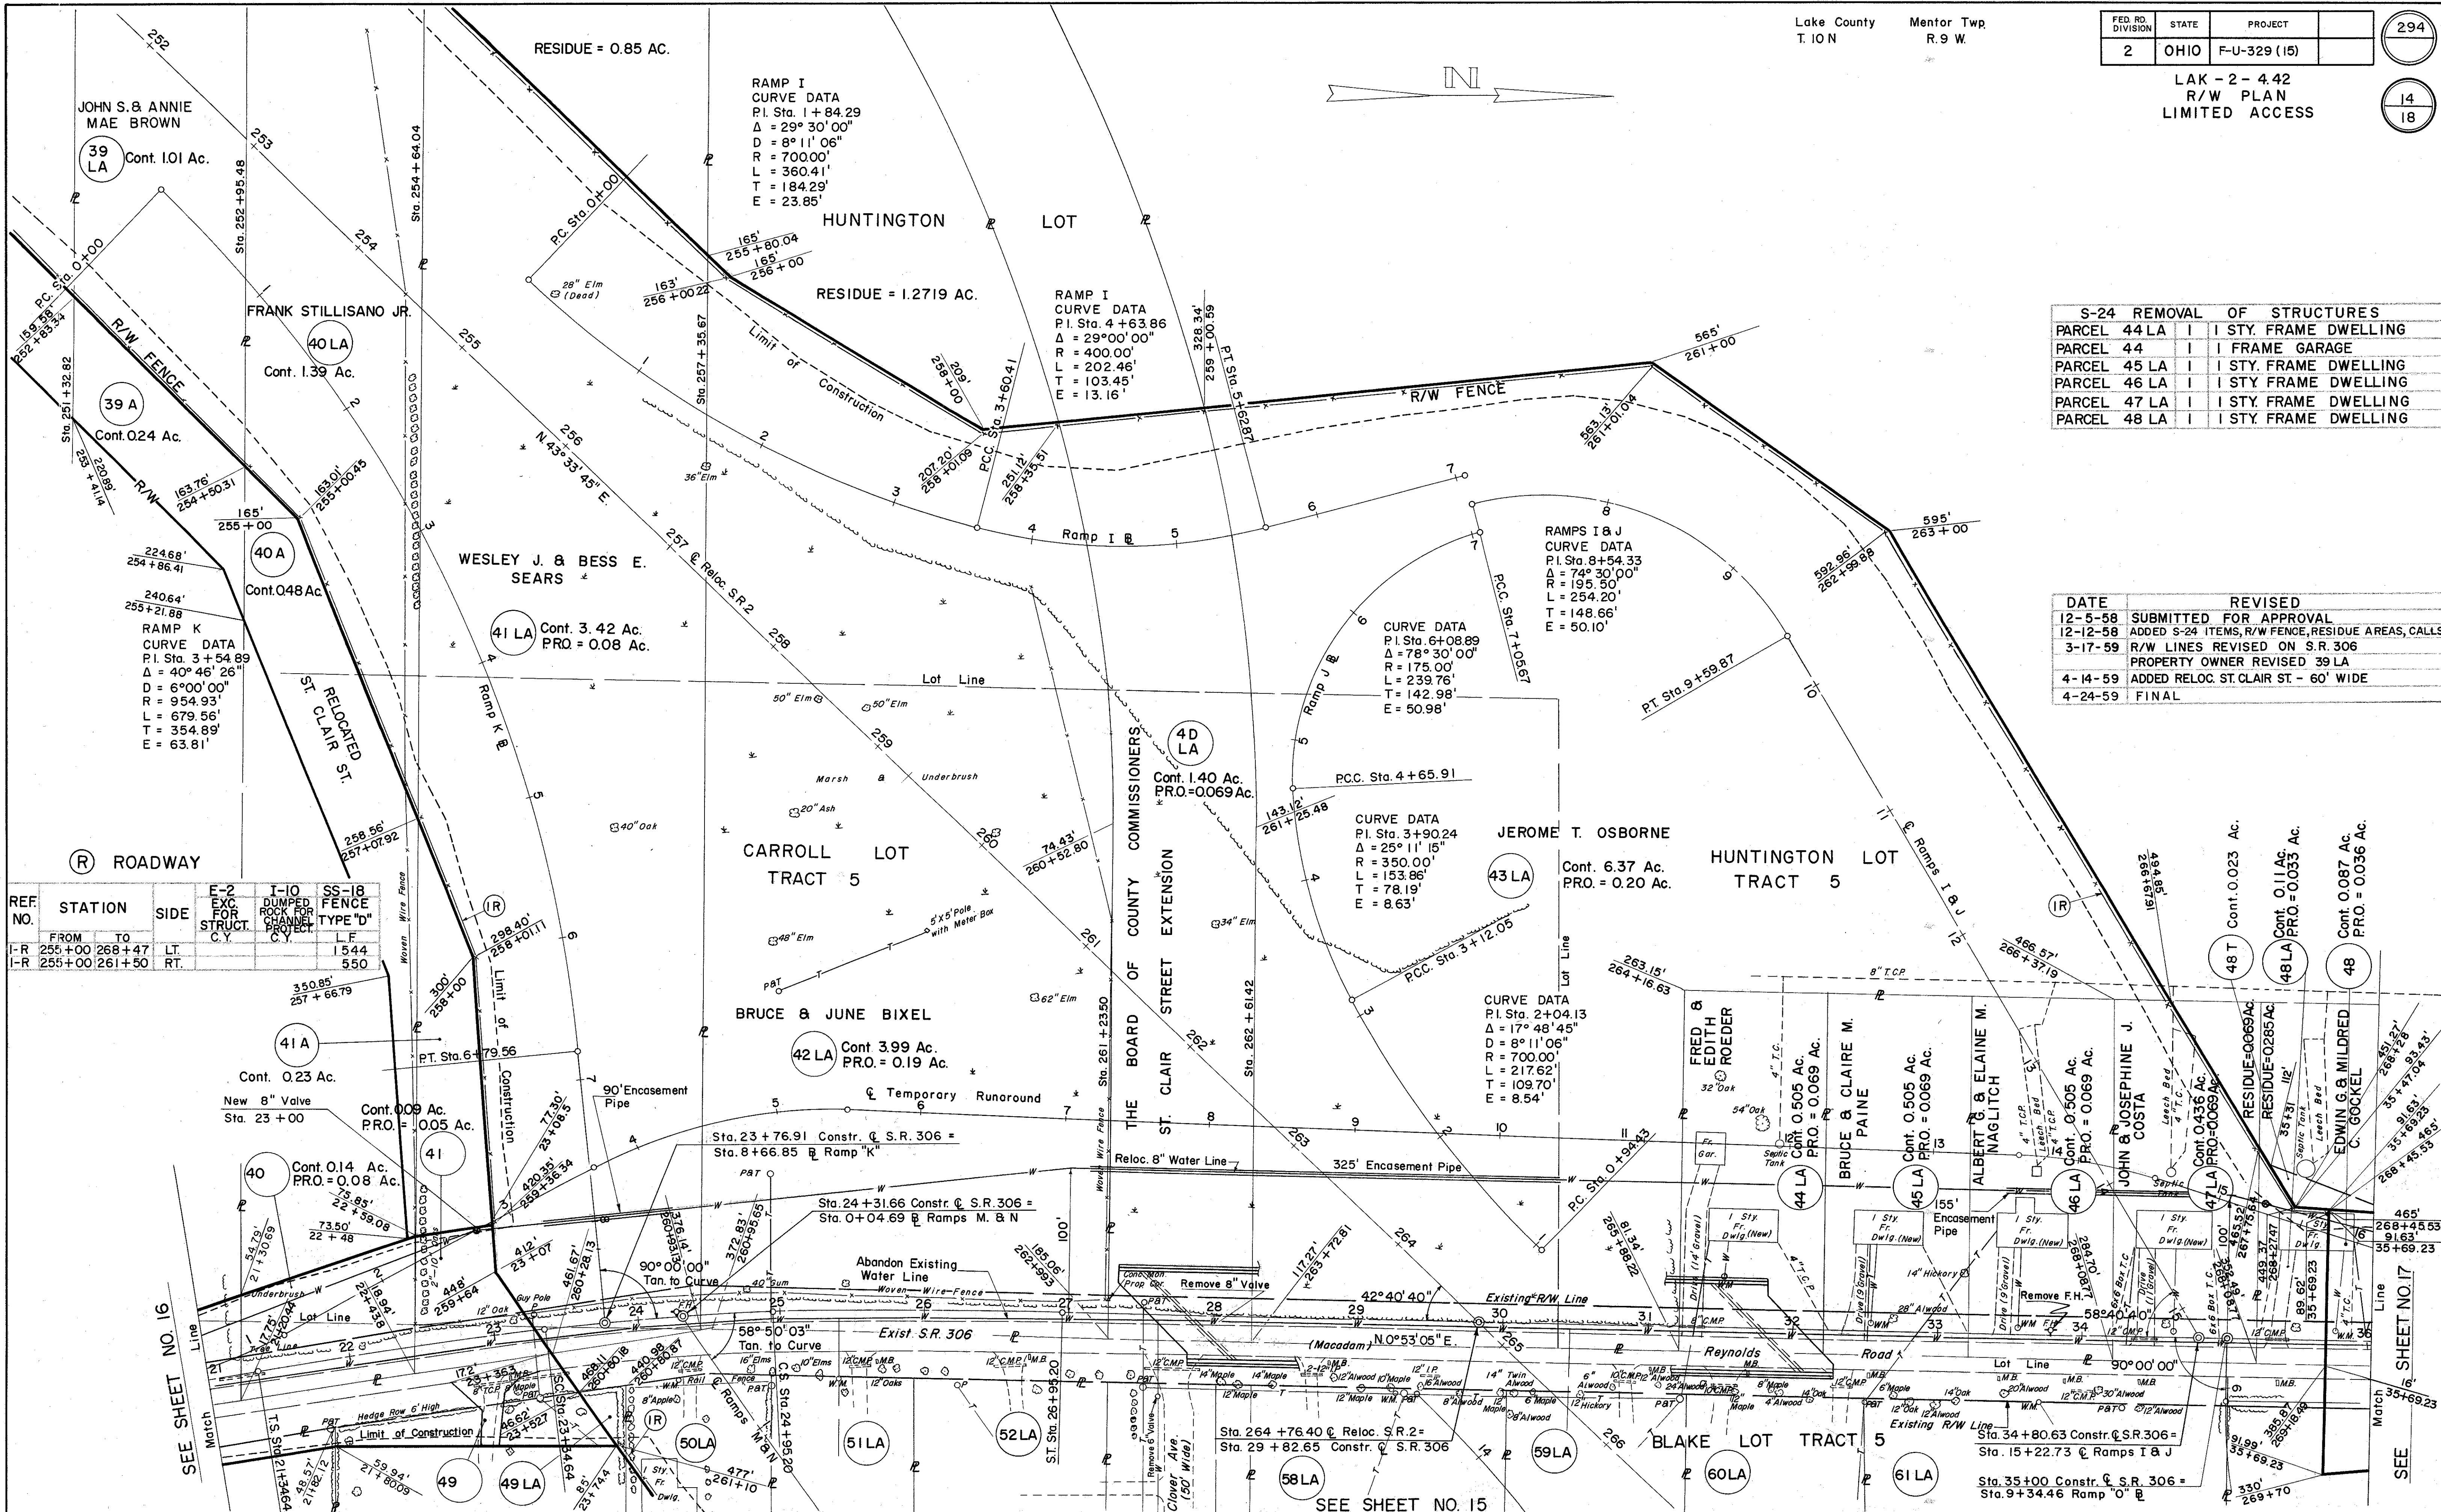

REF. NO.	STATION	SIDE	E-2 EXC. FOR STRUCT. C.Y.	I-10 DUMPED ROCK FOR CHANNEL C.Y.	SS-18 FENCE TYPE "D" L.F.
I-R	255+00 TO 268+47	LT.			1544
I-R	255+00 TO 261+50	RT.			550

SEE SHEET NO. 16

SEE SHEET NO. 15

SHEET NO. 17