


Lane OBE - JN

100 101 102 103 104 105 106 107 108 109 110 111 112 113 114 115 116 117 118 119 120 121 122 123 124 125 126 0 1 2 3 4 5 6

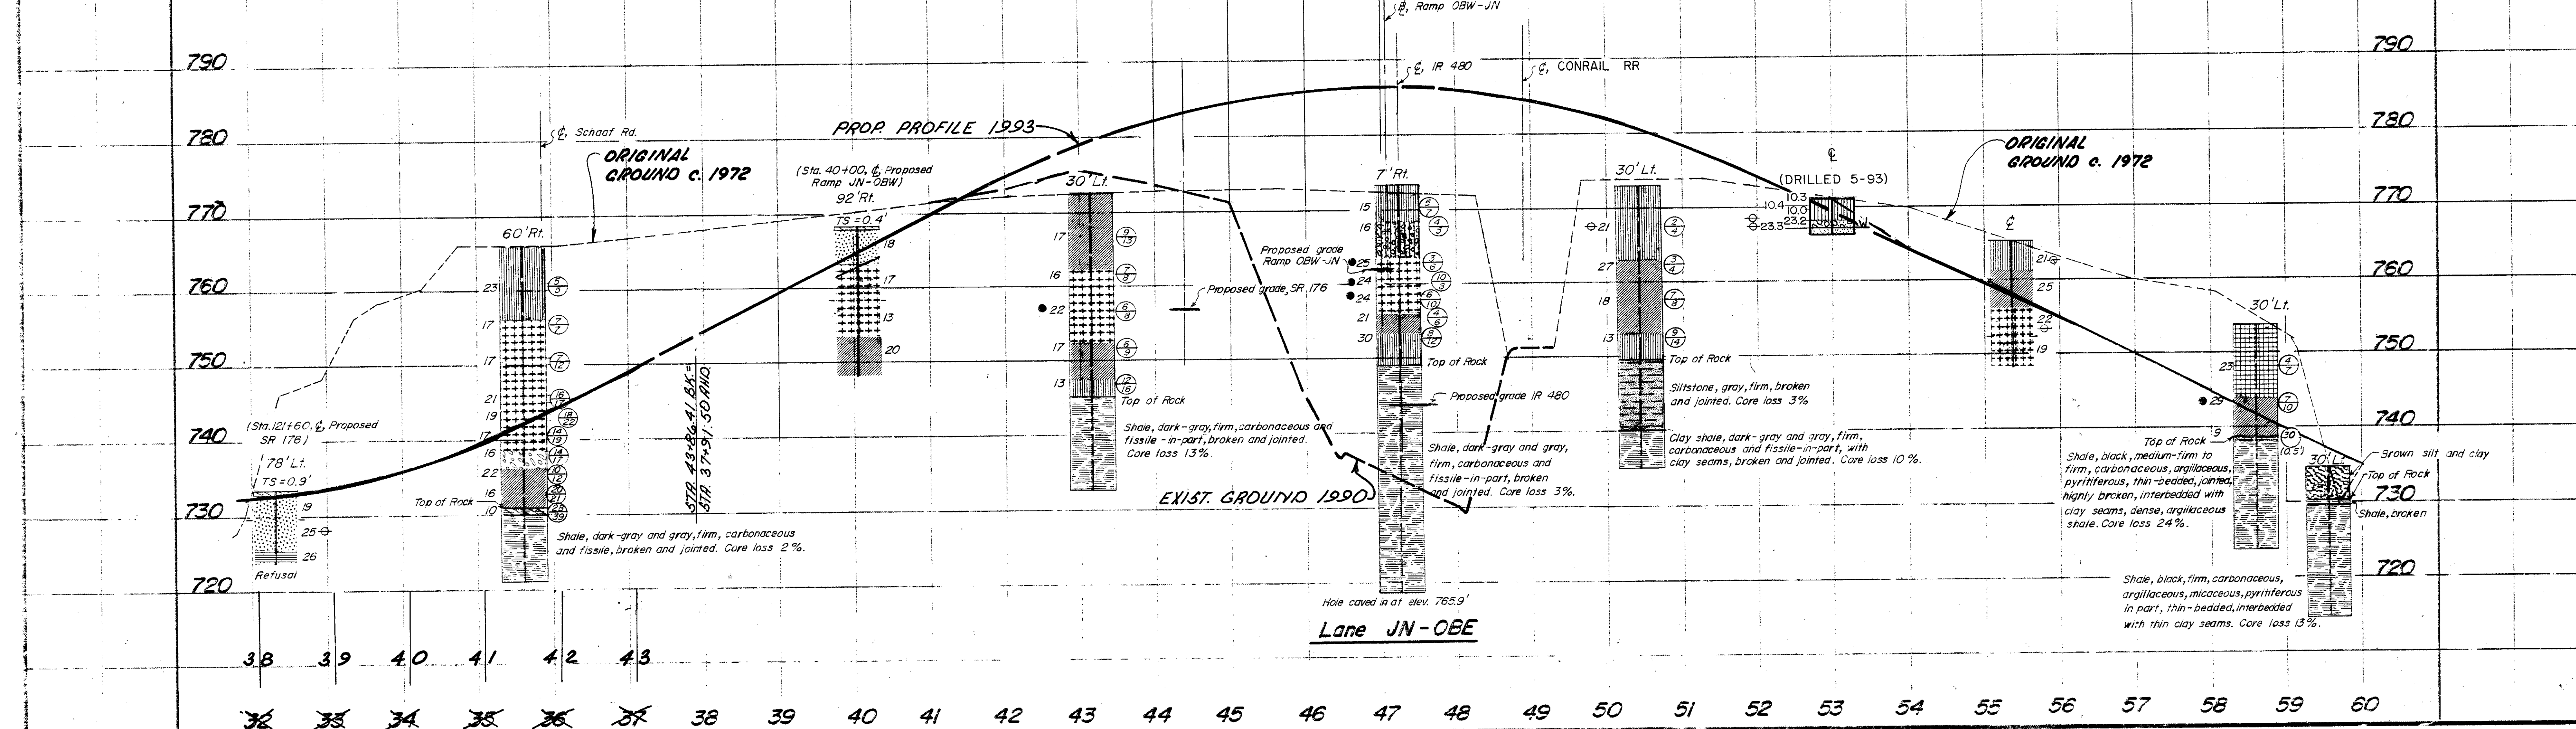

Lane JN - OBE

38 39 40 41 42 43

~~32~~ ~~33~~ ~~34~~ ~~35~~ ~~36~~ ~~37~~ 38 39 40 41 42 43 44 45 46 47 48 49 50 51 52 53 54 55 56 57 58 59 60