
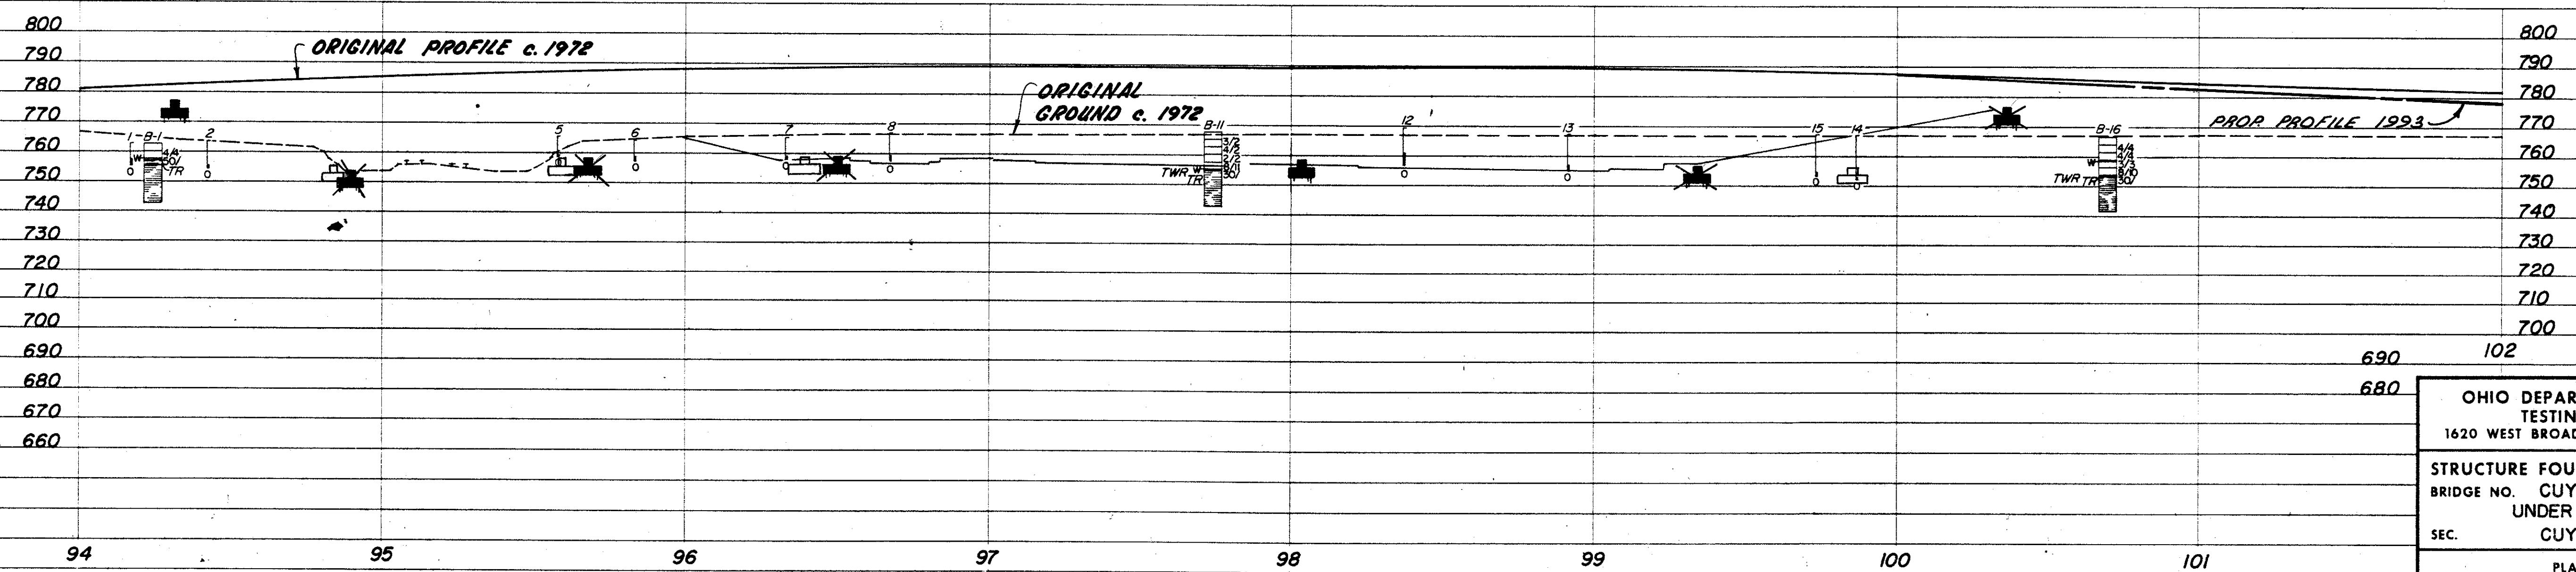


CUY - 480 - 15.22
CUY - 176 - 10.14

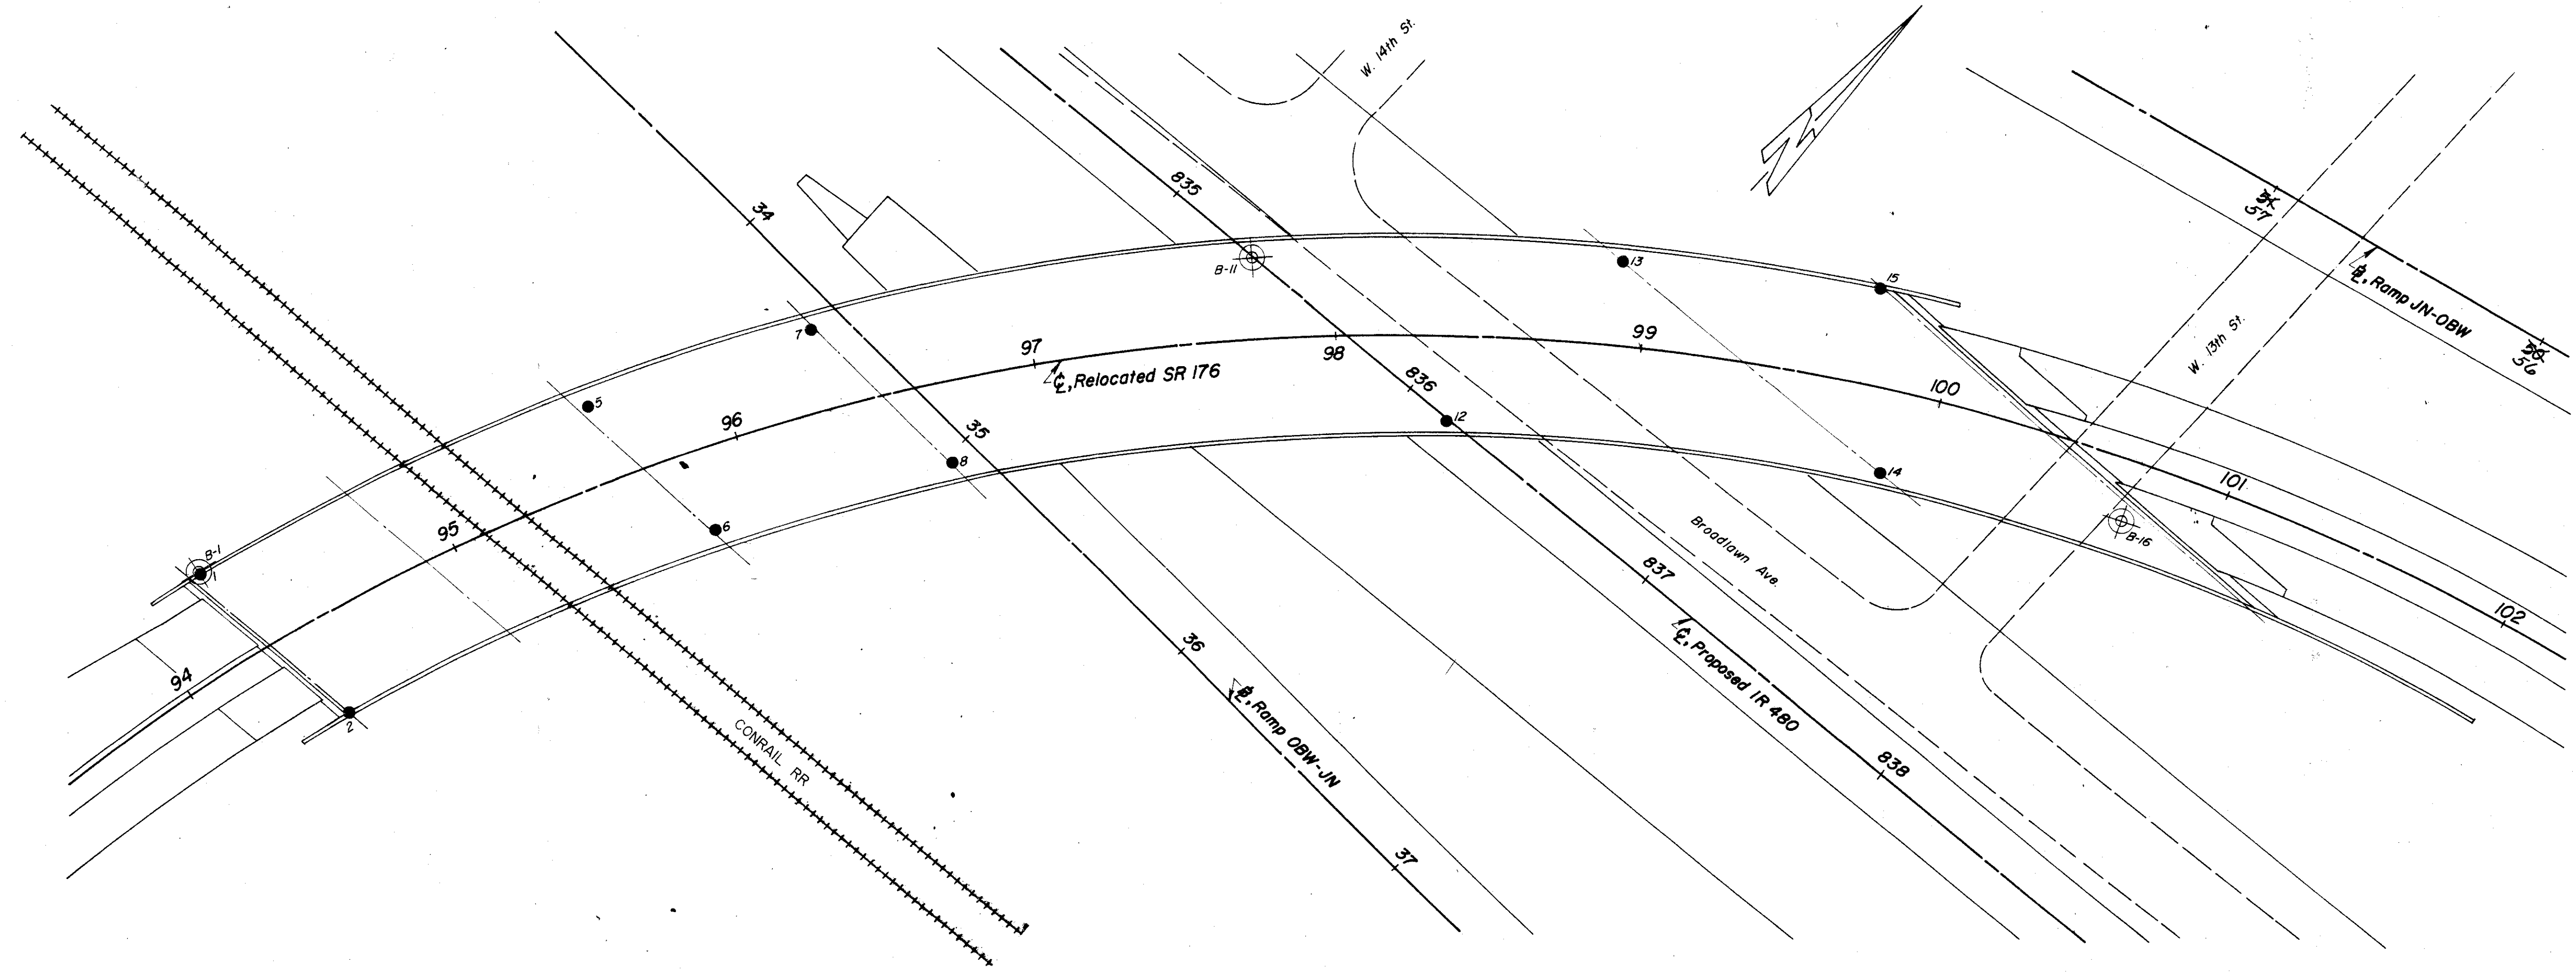

OHIO DEPARTMENT OF HIGHWAYS TESTING LABORATORY 1620 WEST BROAD STREET, COLUMBUS 23, OHIO			
STRUCTURE FOUNDATION INVESTIGATION			
BRIDGE NO.	CUY - 480 - 1536		
SEC.	UNDER RELOCATED SR 176		
CUY - 480 - 15.22			
PLAN AND PROFILE			
DRAWN BY	CHECKED BY	REVIEWED BY	DATE
D.E.N.	R. D. R.	G. P. H.	3/7/72

SCALE: 1" = 30'

REV. JAN. 1993