
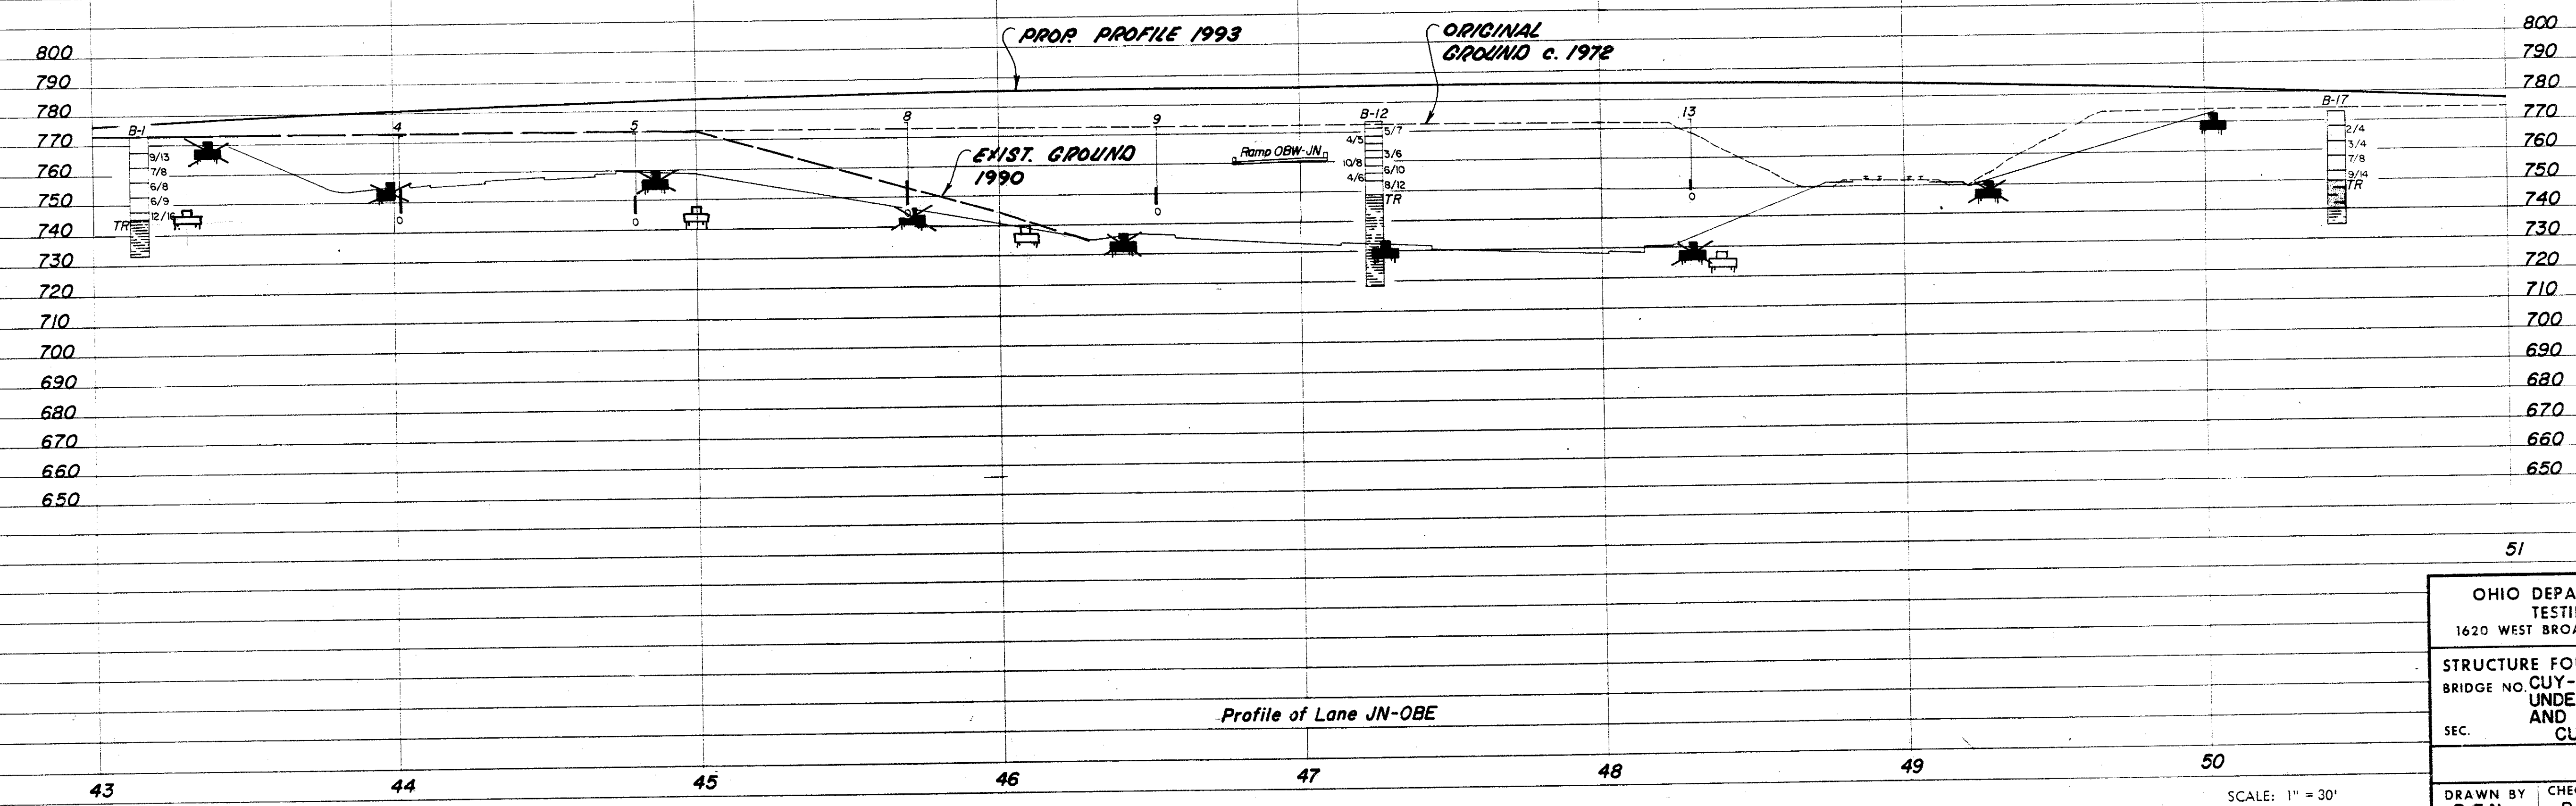


CUY-480-15.22  
CUY-176-10.14

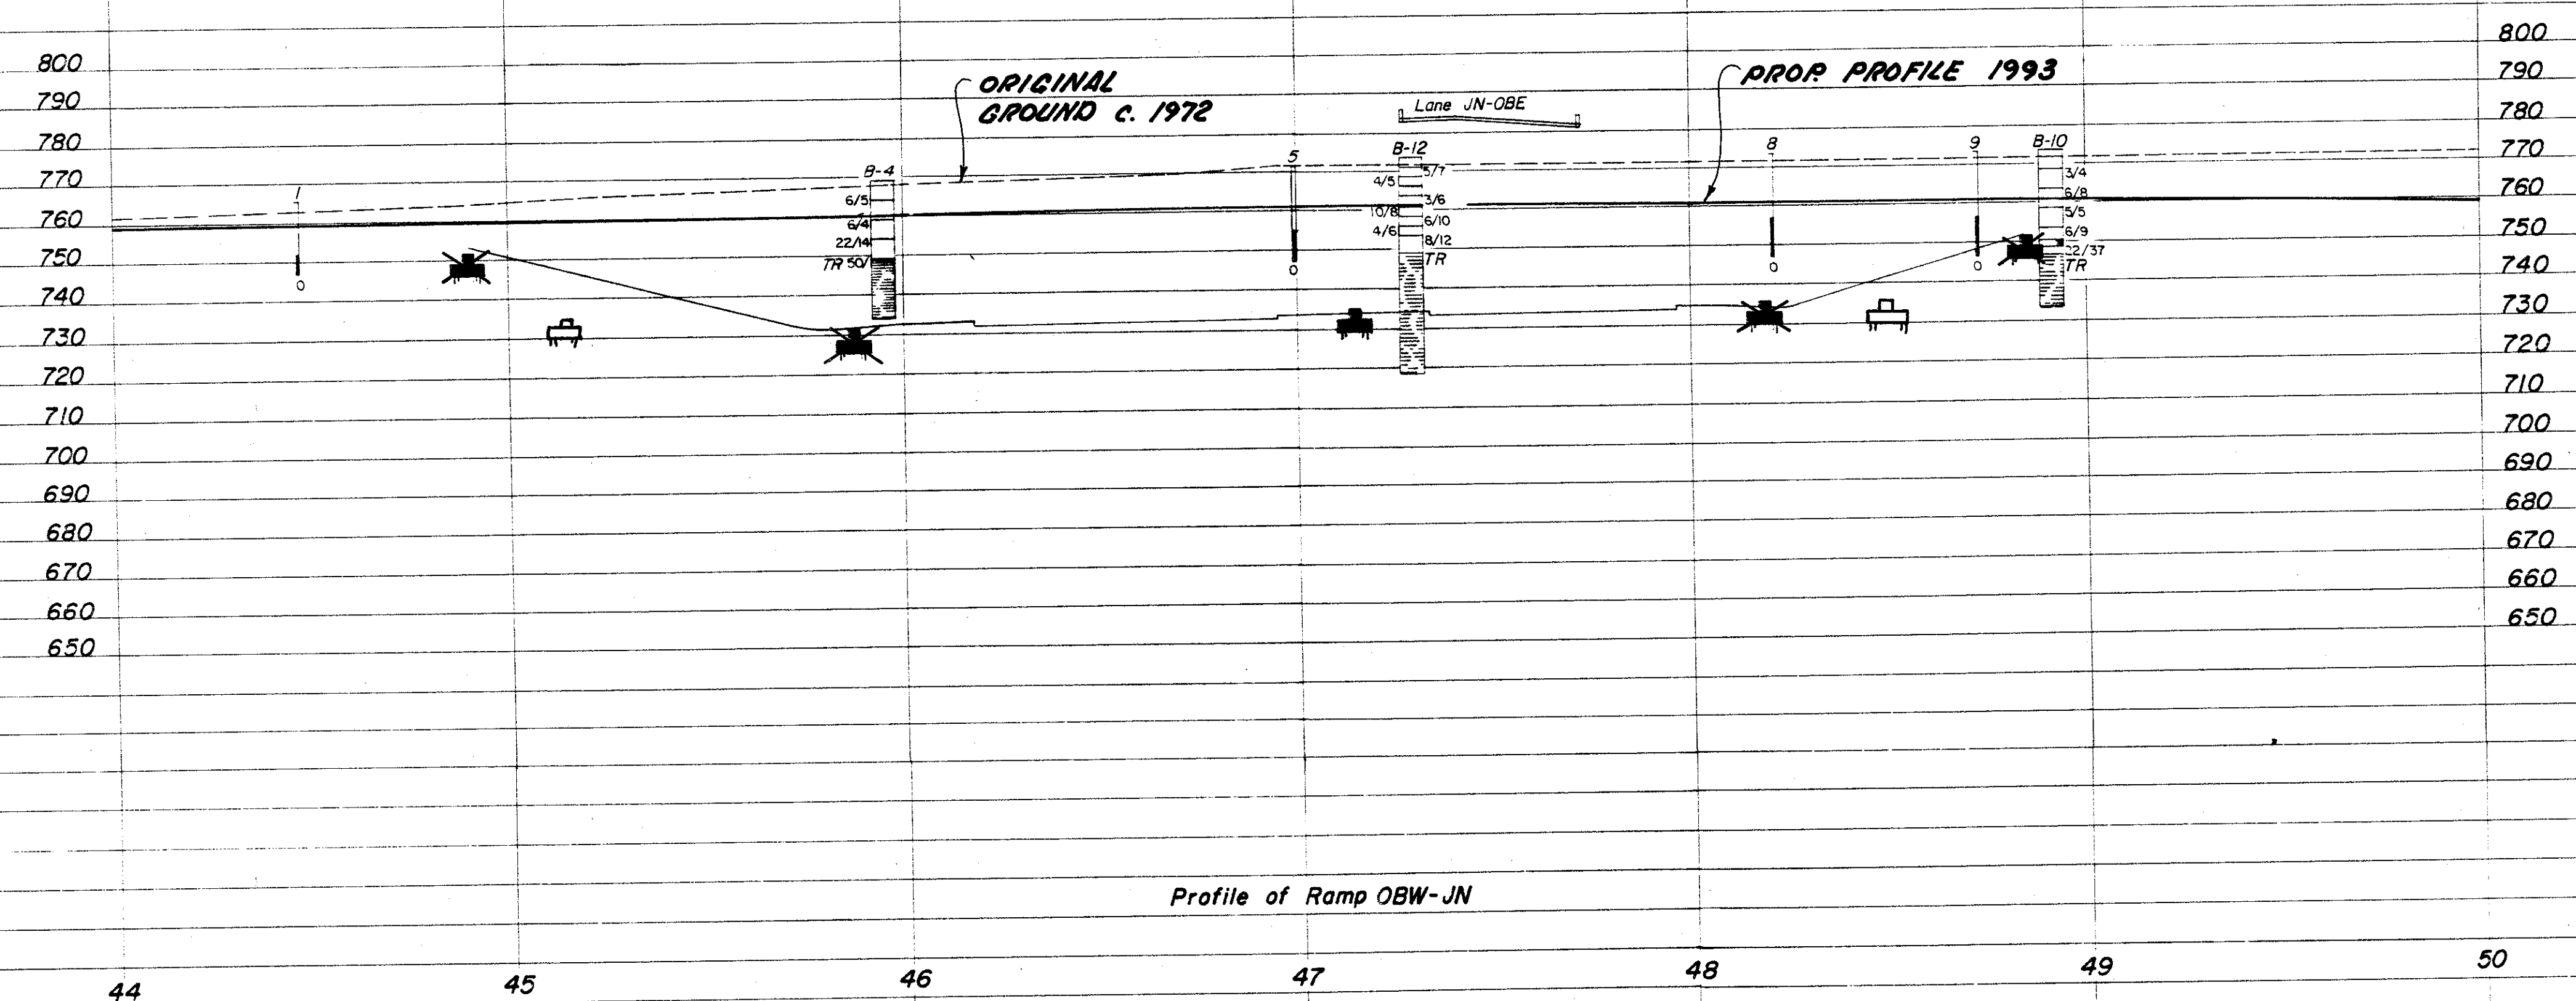

OHIO DEPARTMENT OF HIGHWAYS  
TESTING LABORATORY  
1620 WEST BROAD STREET, COLUMBUS 23, OHIO

STRUCTURE FOUNDATION INVESTIGATION  
BRIDGE NO. CUY-480-1557 & 1559  
UNDER RAMP OBW-JN  
AND LANE JN-OBE  
SEC. CUY-480-15.22

PROFILES

DRAWN BY D.E.N.	CHECKED BY R.D.R.	REVIEWED BY G.P.H.	DATE 4/17/72
--------------------	----------------------	-----------------------	-----------------

SCALE: 1" = 30'

REV. JAN. 1993