
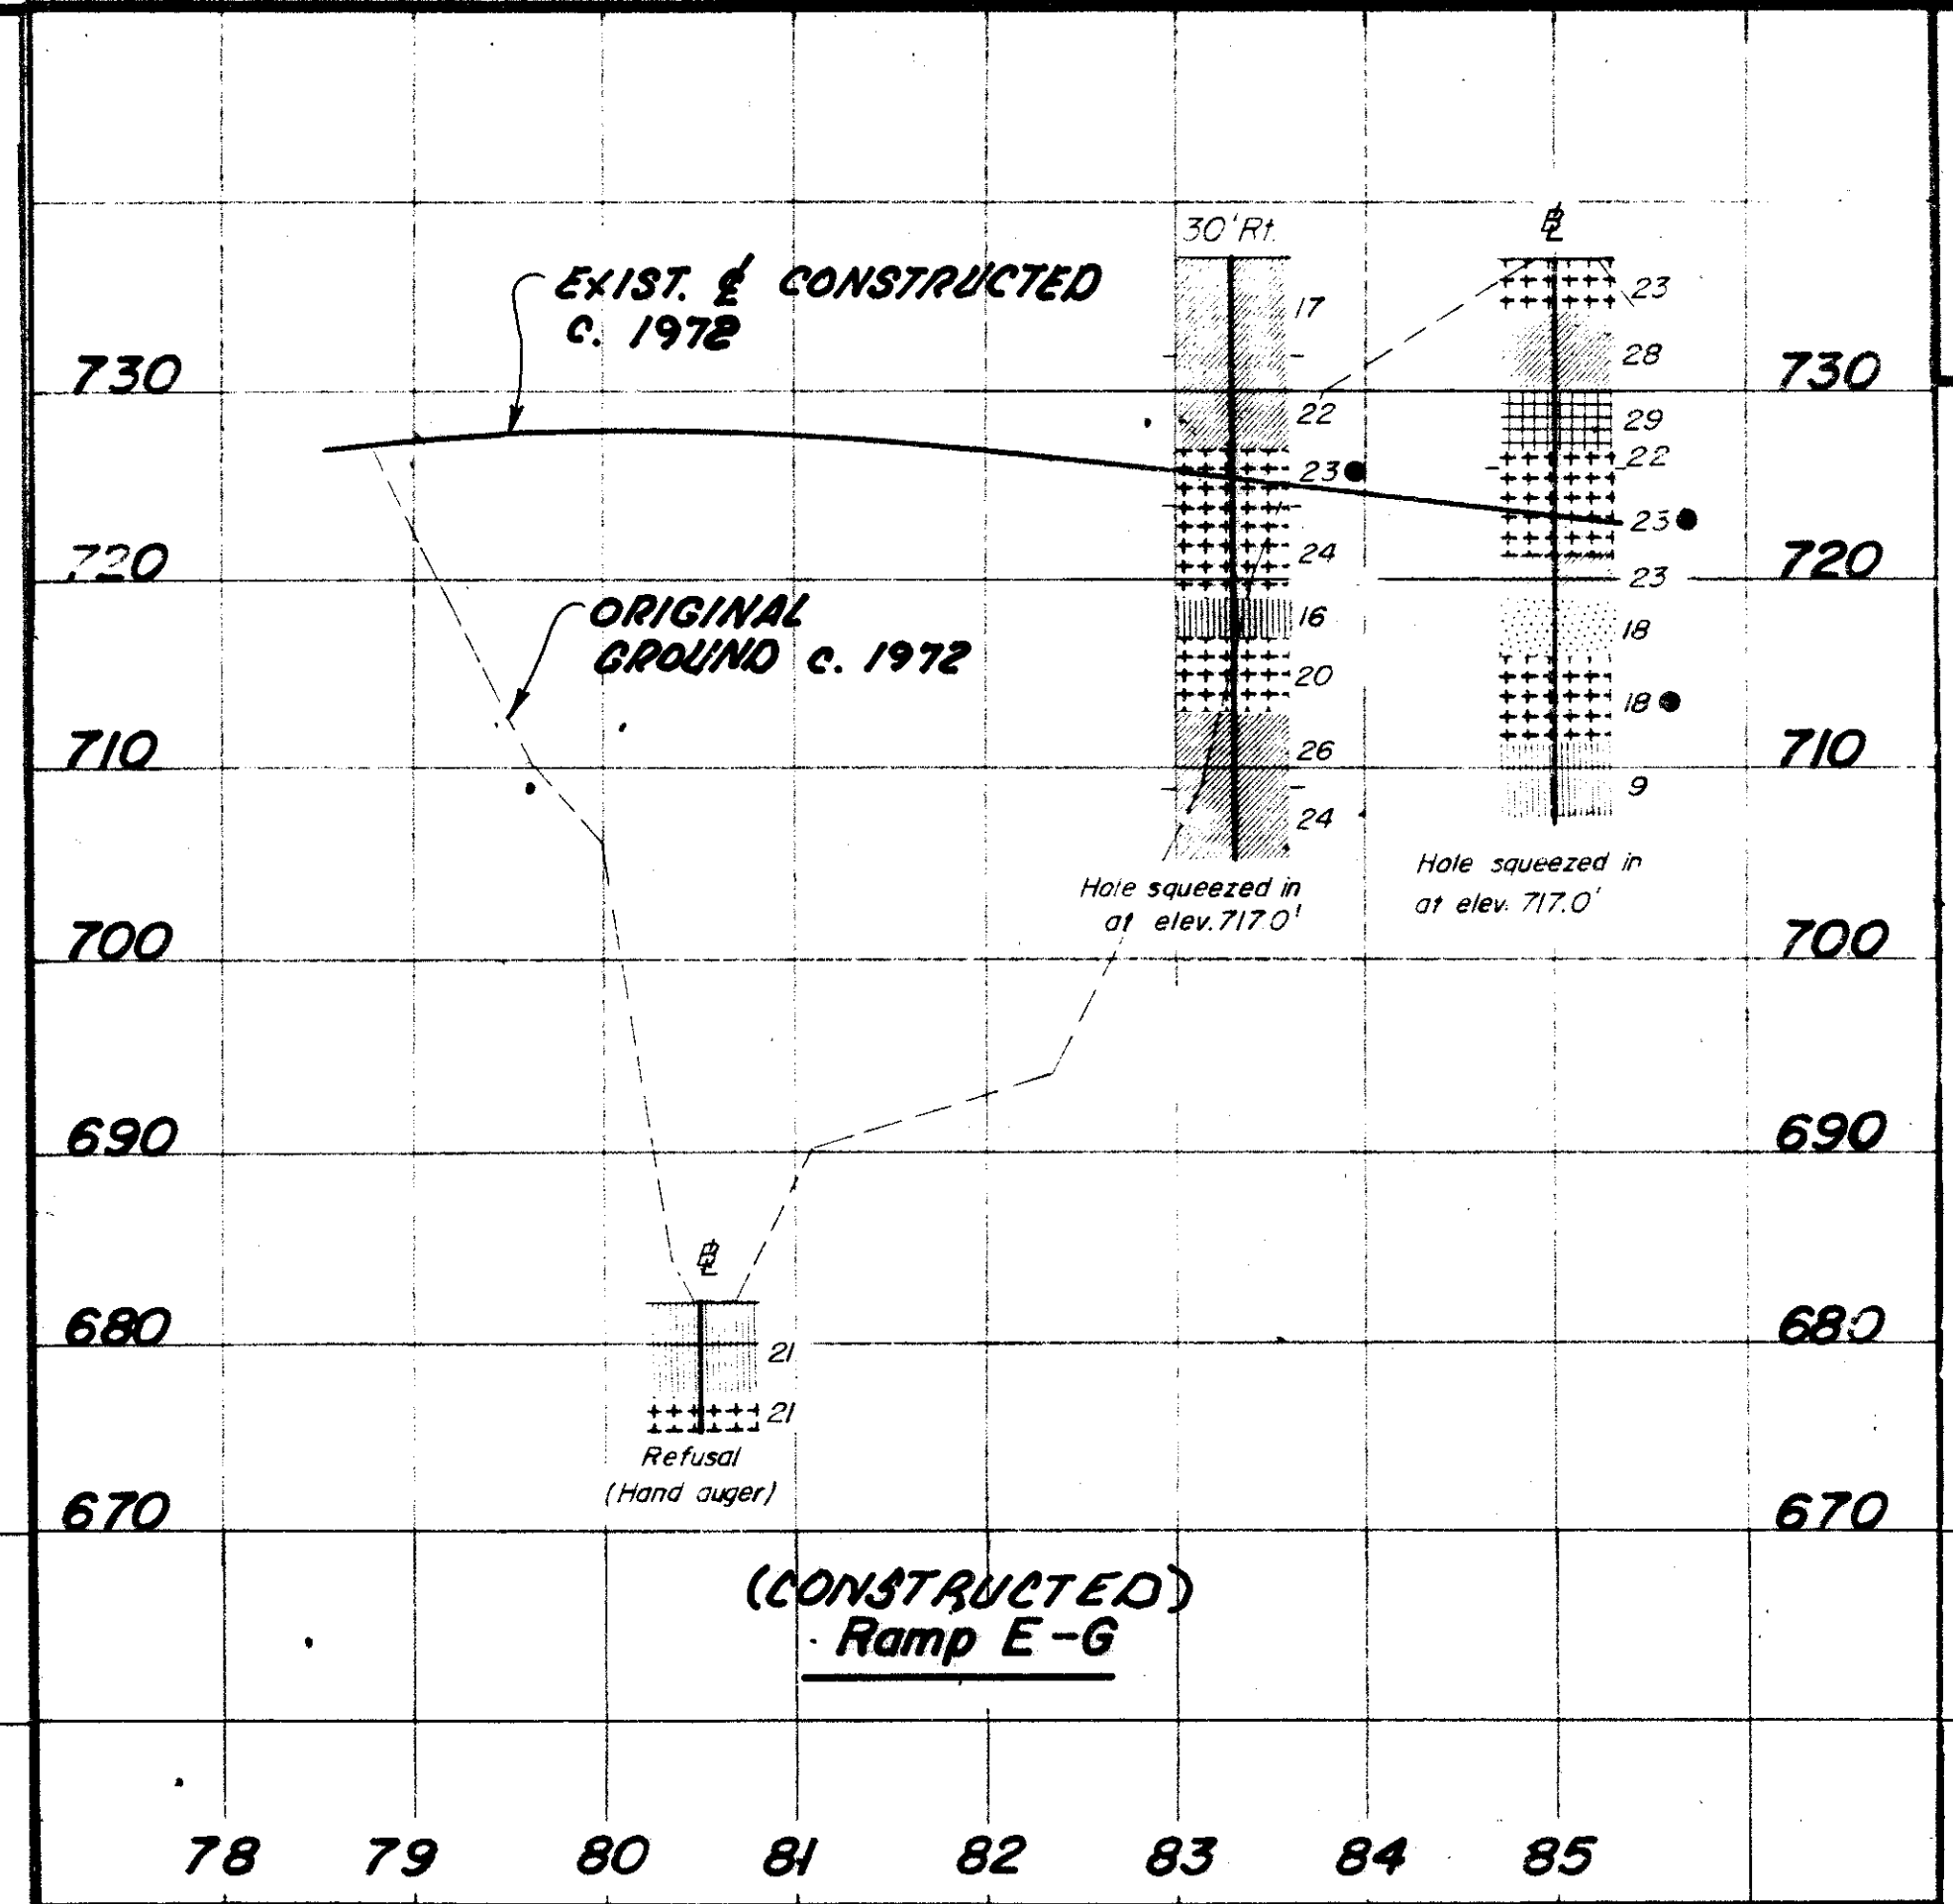


CROSS SECTION INDEX	
Station	Sheet
927+00	11
934+00	12

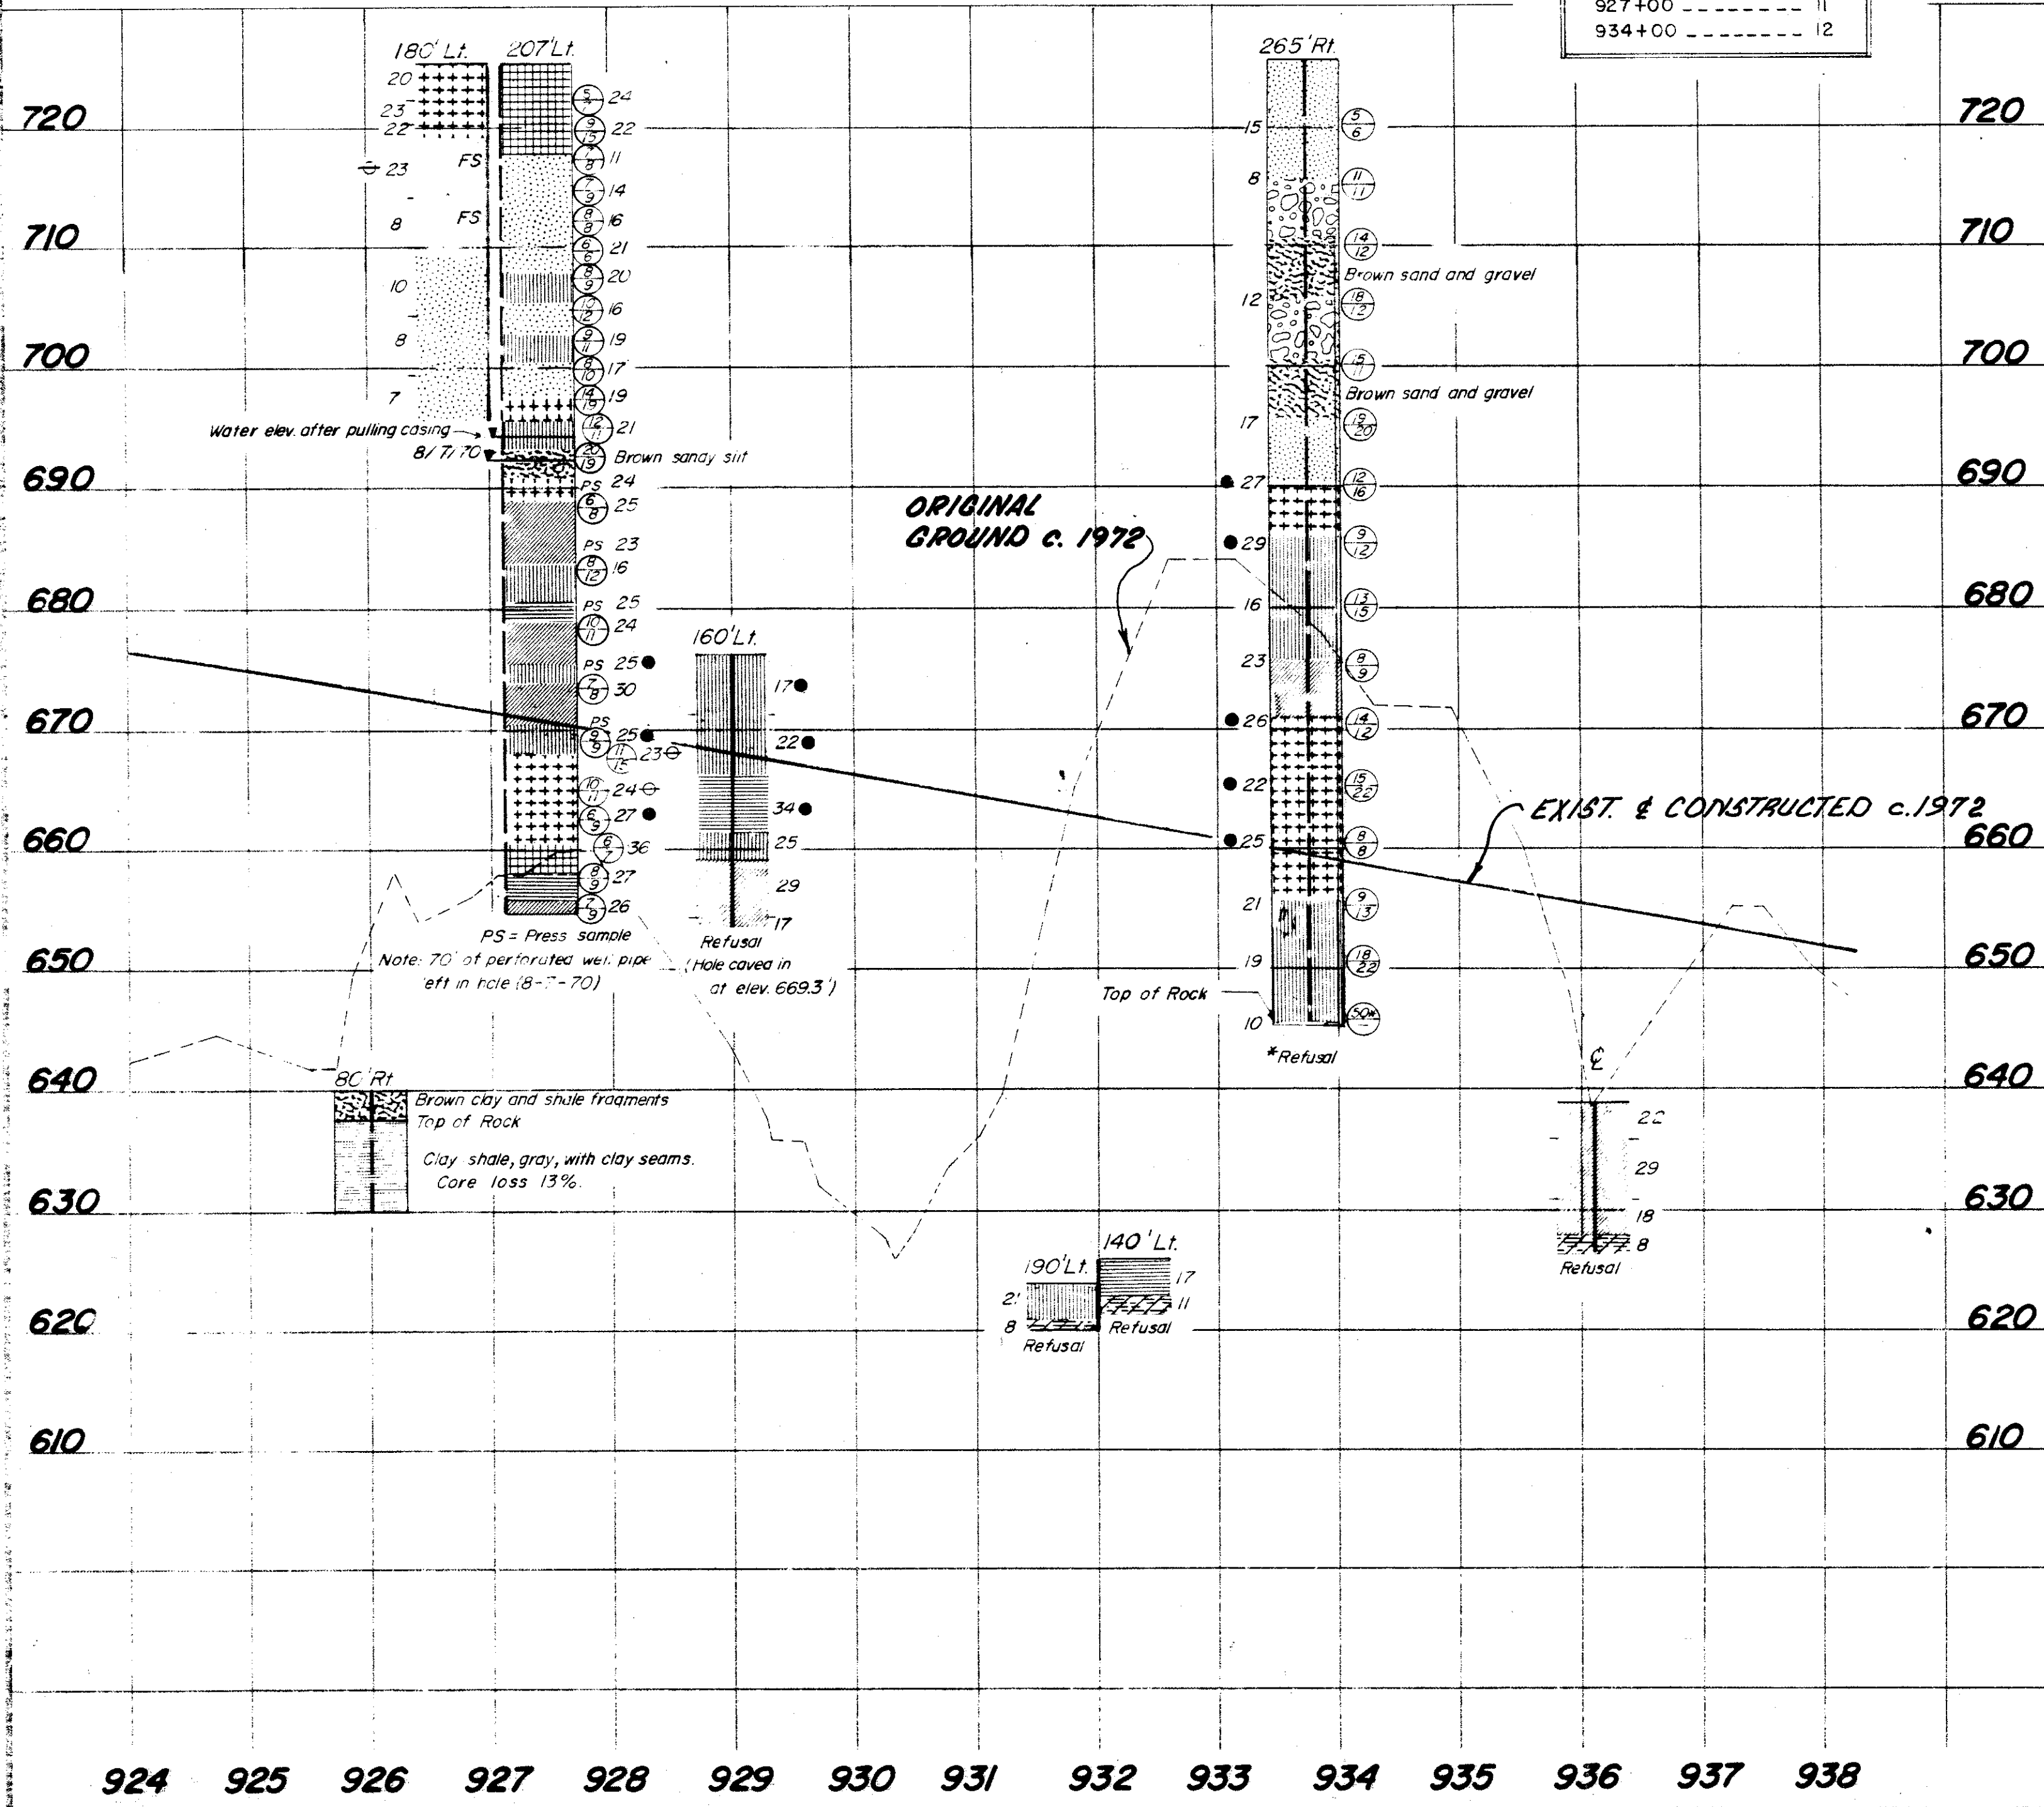

SOIL PROFILE  
 CUYAHOGA COUNTY  
 CUY-480-15.81  
 OHIO STATE HIGHWAY TESTING  
 LABORATORY  
 1620 W. BROAD ST. COLUMBUS, OHIO 43223

32  
 50  
 6  
 12

CUY-176-10.14