


CUY-176-10.14

(CONSTRUCTED)  
 Sta. 905+00

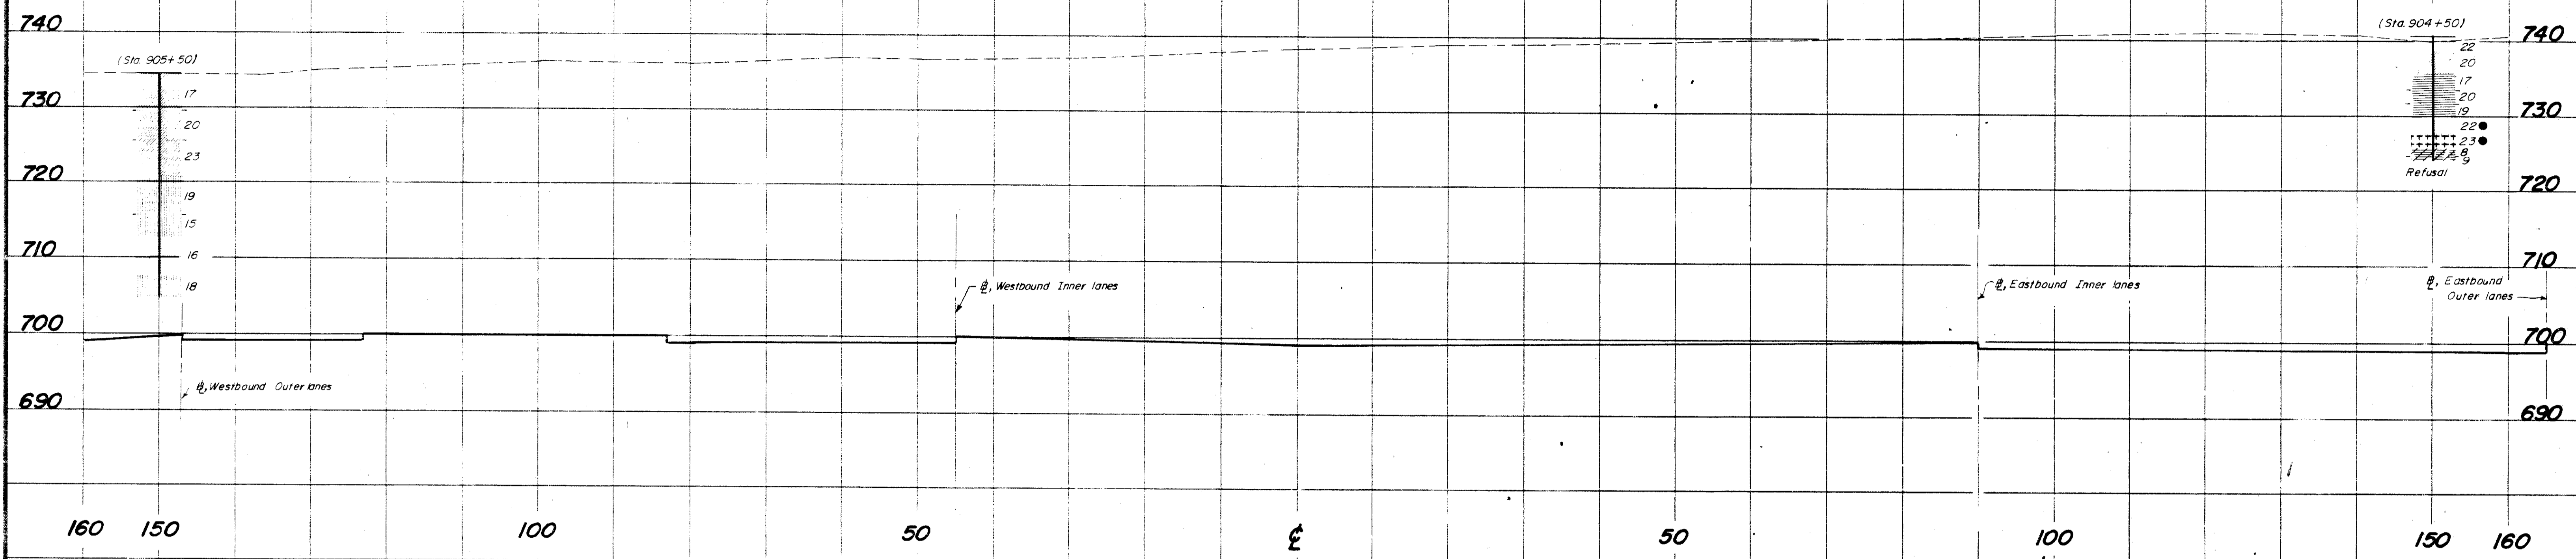

(CONSTRUCTED)  
 Sta. 893+00

