


CURVE DATA  
 $\Delta = 1^\circ 57' 49''$   
 $R = 10,000'$   
 $L = 342.71'$

FOR SEWER DETAILS  
 SEE SHEET NO. 216

RAMP Q  
 CURVE DATA  
 P.I. Sta. 6+22.42  
 $\Delta = 27^\circ 40' 31''$   
 $R = 700.00'$   
 $L = 338.12'$   
 $T = 172.42'$

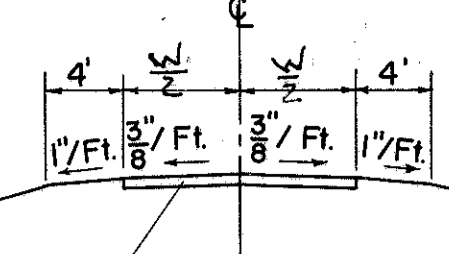


Turnaround North  
 $W = 12'$   
 Turnaround South  
 $W = \text{As shown on sheet \# 31}$

LAKE COUNTY  
 LAK-2-739

TYPICAL SECTION  
 TURNAROUND

(L.I. Sta. 390+75)  
 (R.I. Sta. 396+00)

FOR RAMP Q DETAILS  
 SEE SHEETS NO. 147 & 173

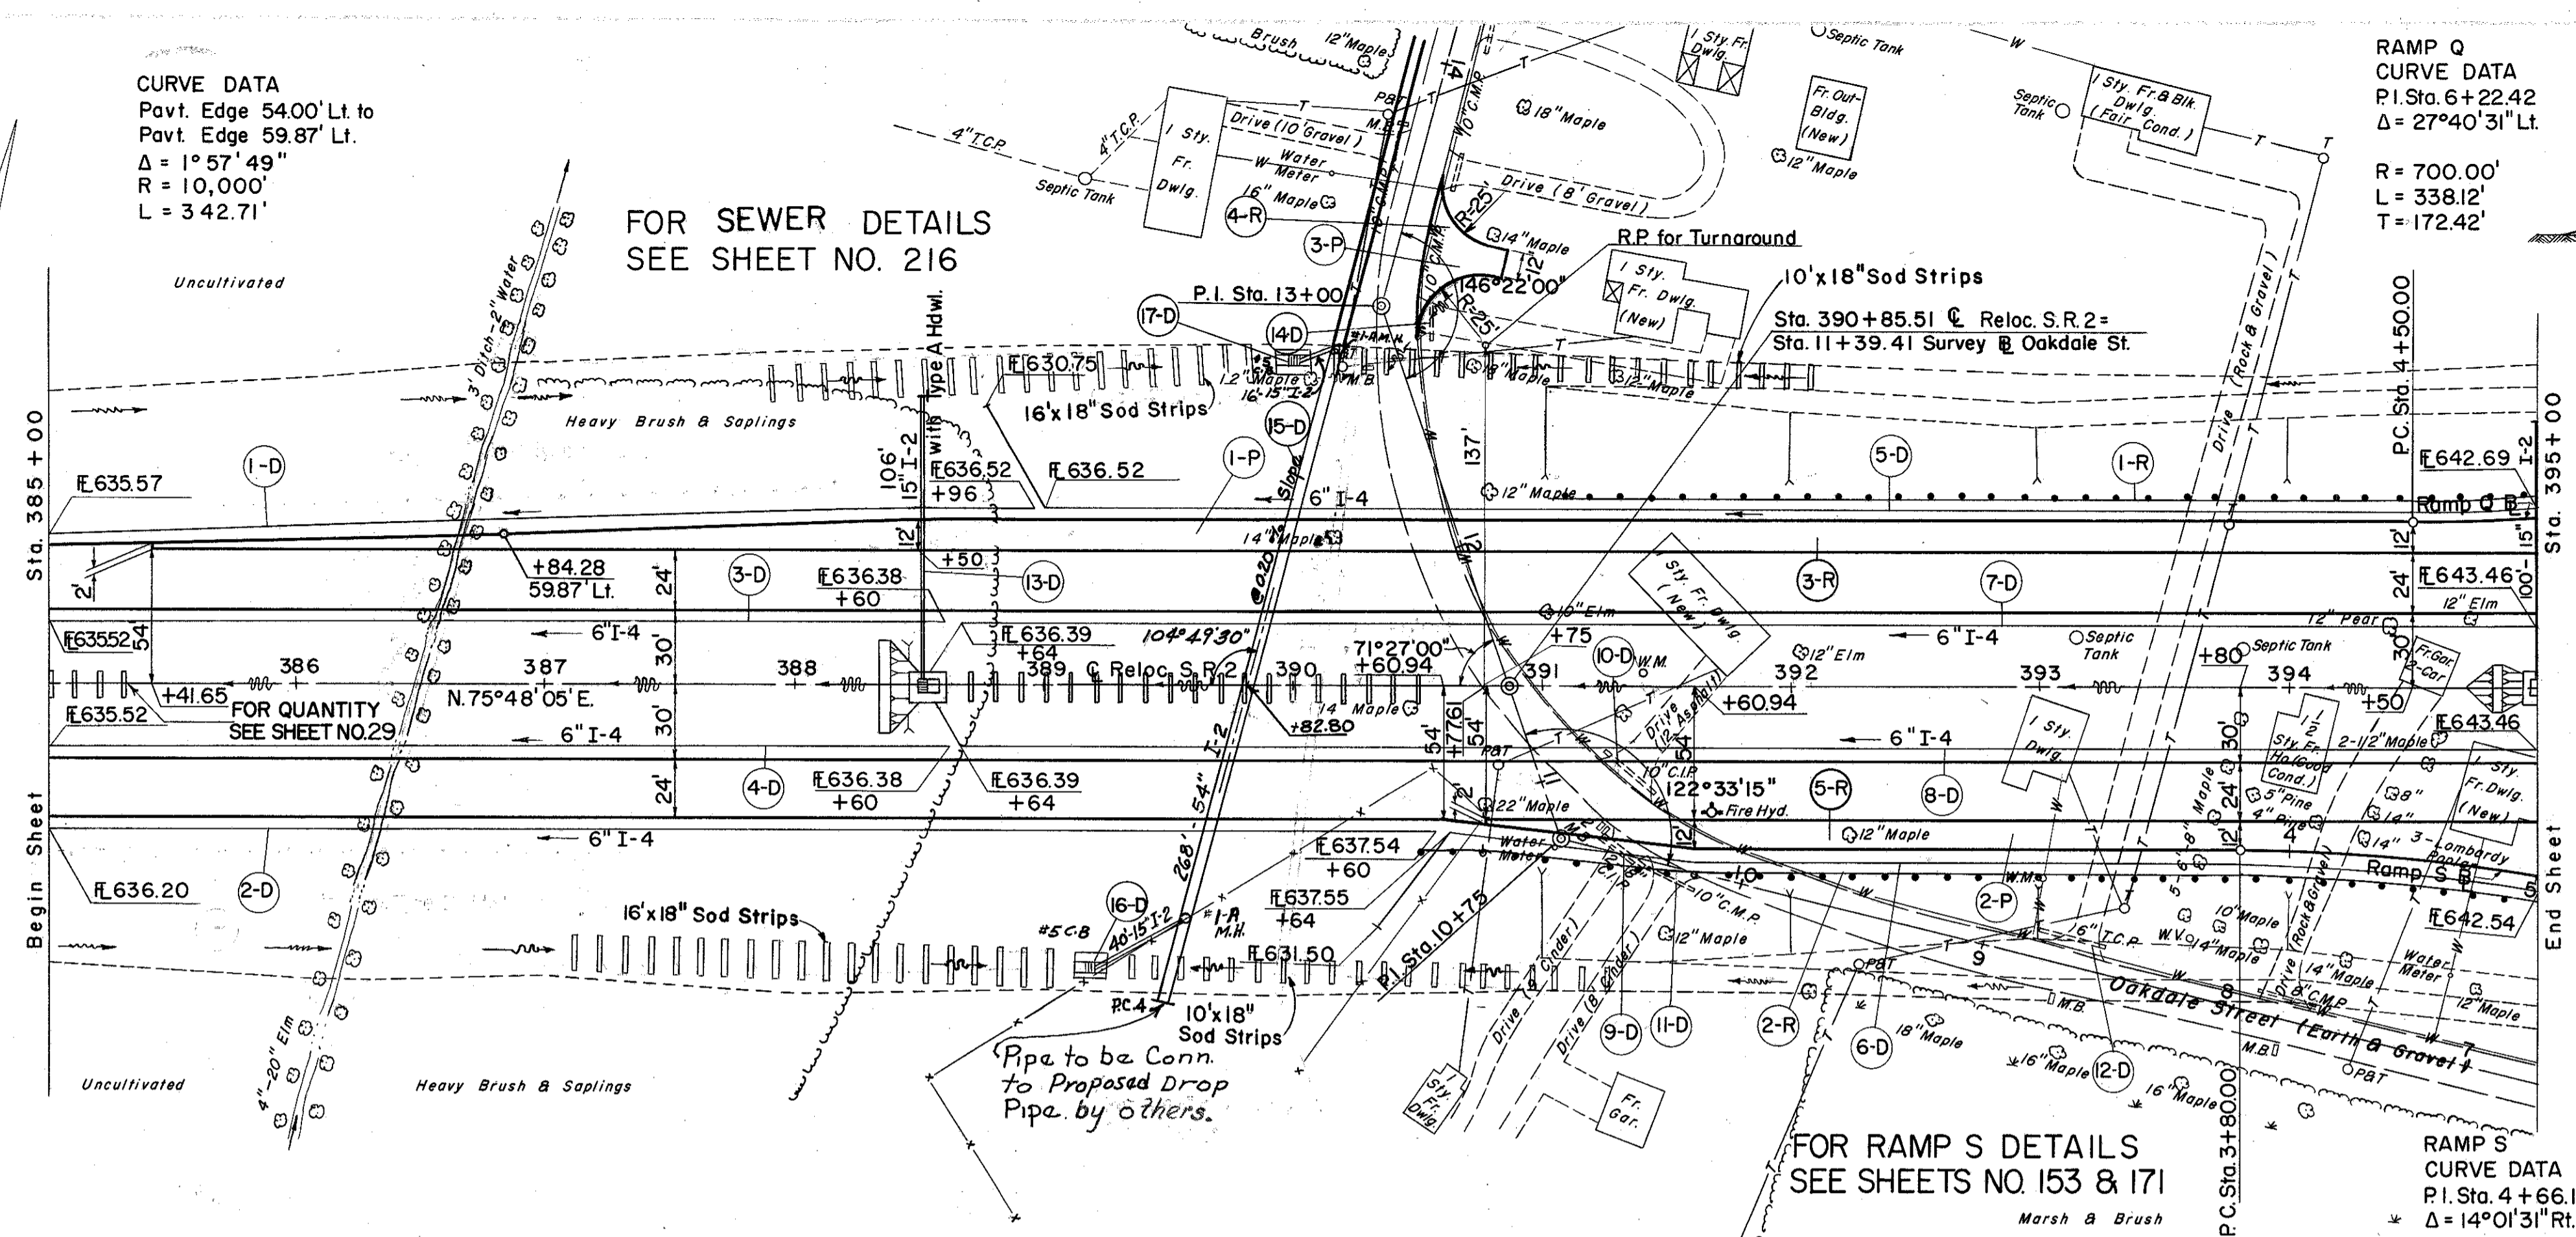


FOR RAMP S DETAILS  
 SEE SHEETS NO. 153 & 171

RAMP S  
 CURVE DATA  
 P.I. Sta. 4+66.11  
 $\Delta = 14^\circ 01' 31''$   
 $R = 700.00'$   
 $L = 171.35'$   
 $T = 86.11'$

B.M. #30 Lag Bolt in 16" Elm  
 175' Rt. Sta. 385+75  
 Elev. 633.110

B.M. #31 Lag Bolt in PP #380025  
 120' Rt. Sta. 391+90  
 Elev. 632.293

B.M. #31A Lag Bolt in 20" Maple  
 150' Rt. Sta. 392+15  
 Elev. 632.853

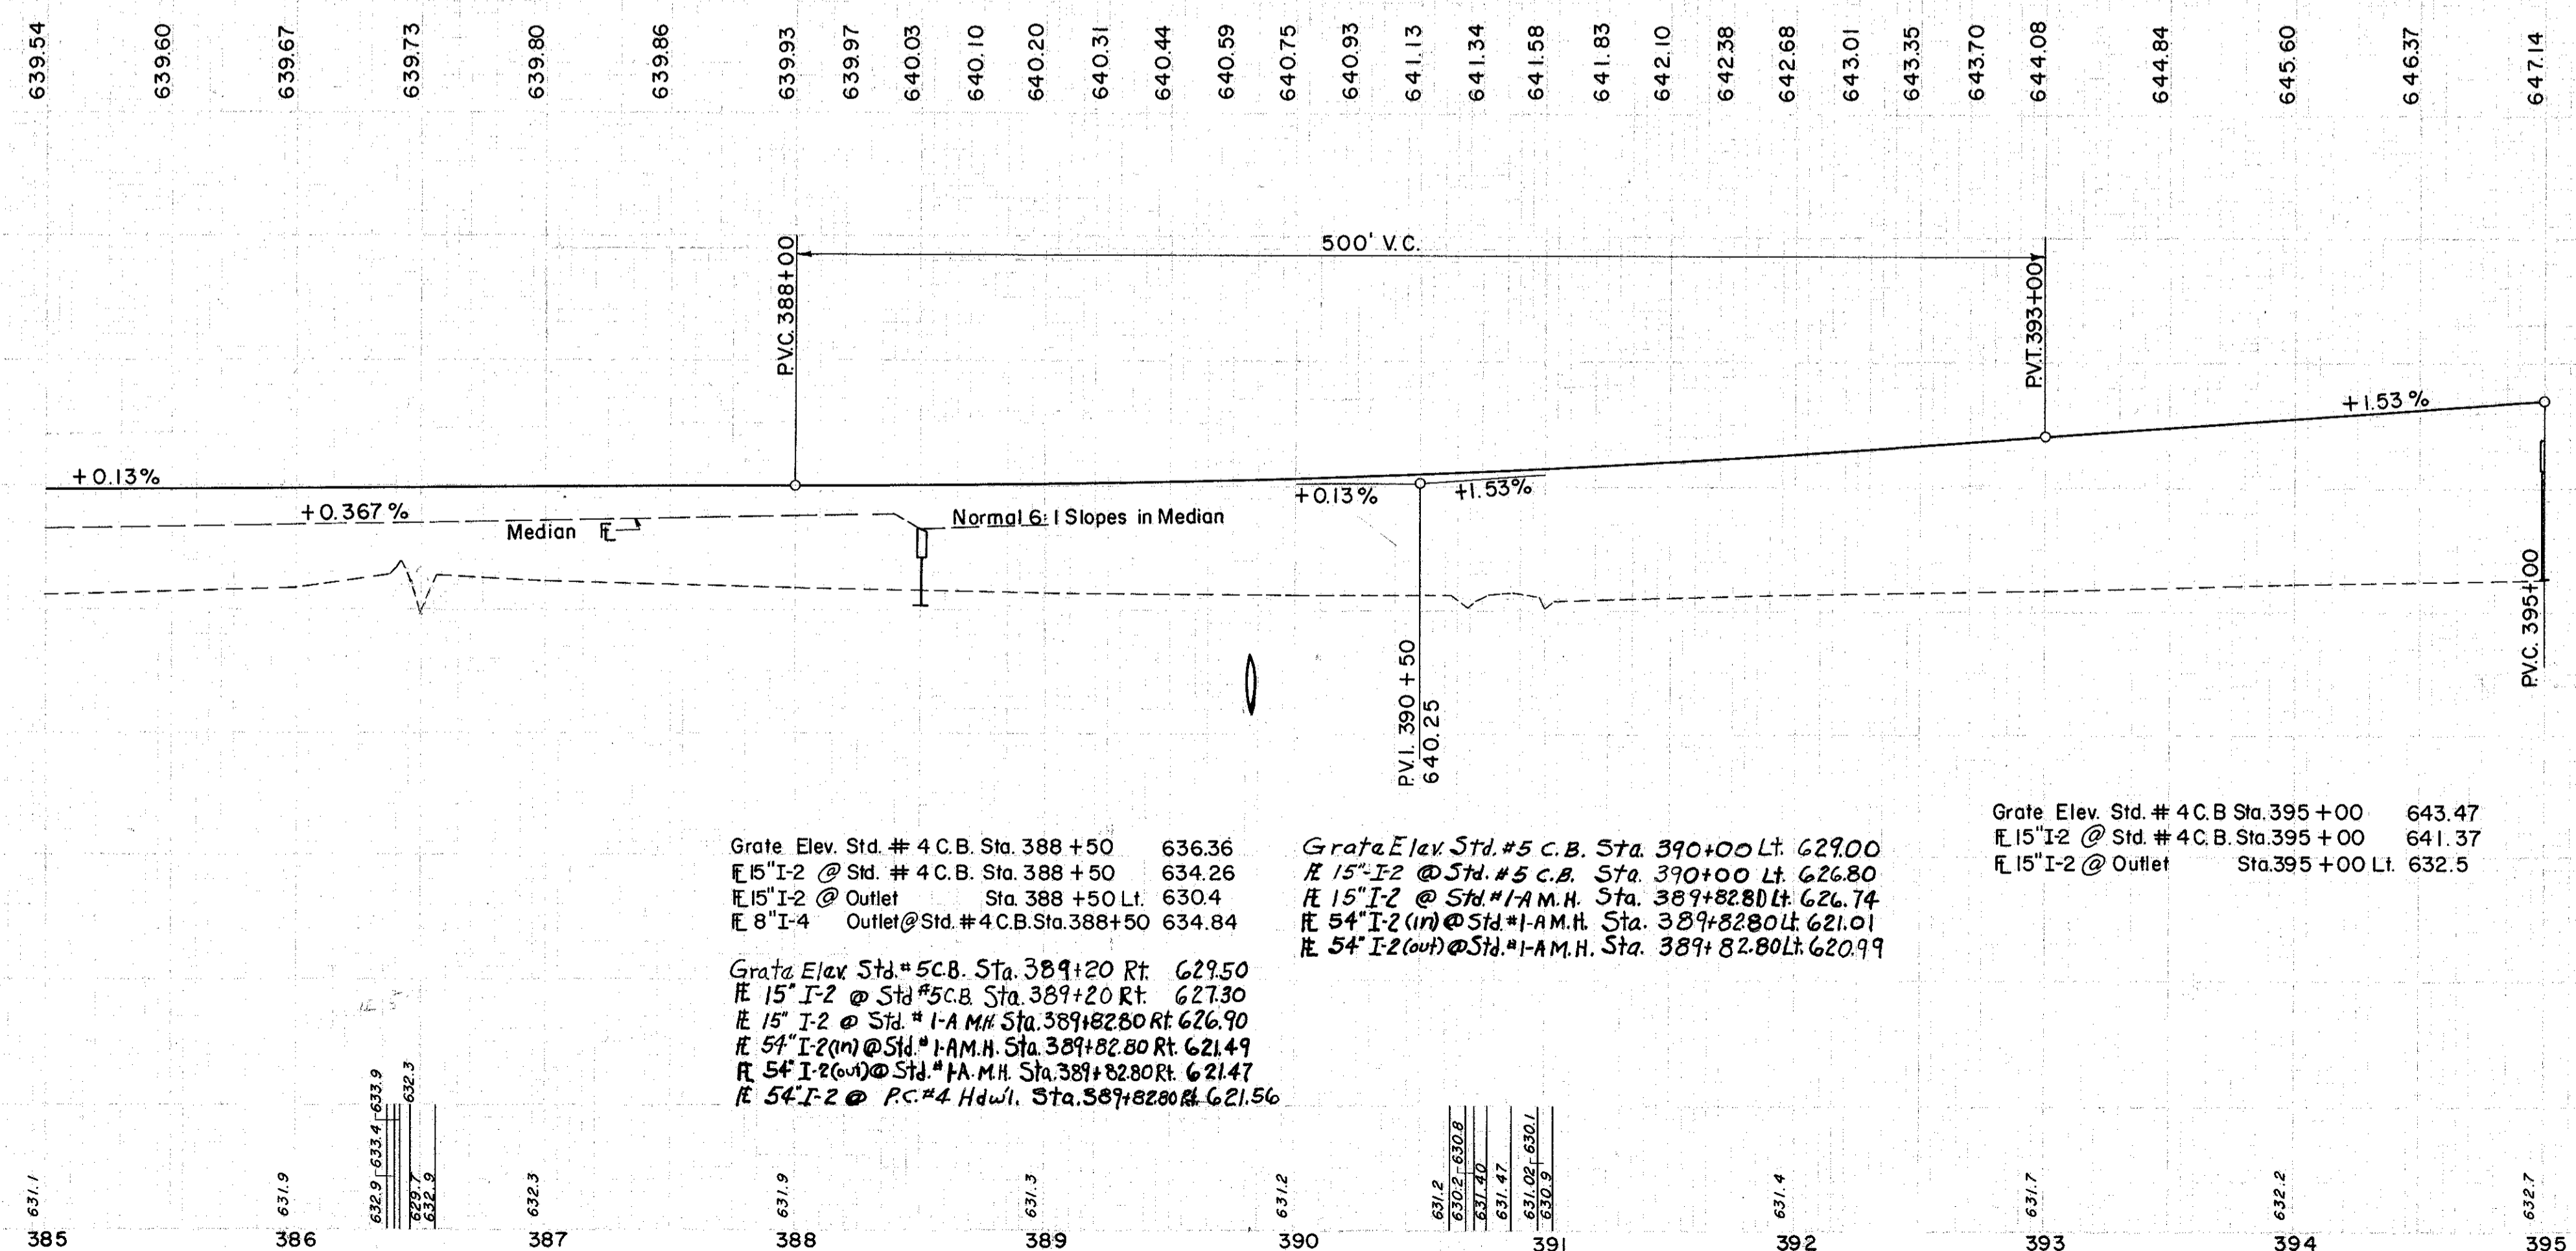




Revised 17 Oct. 58

STA. 385+00 TO STA. 395+00

1,185 C.Y.  
 58,190 C.Y.  
 69,828 C.Y.