


SEEDING
 END STA. 388
 178.0

LAKE COUNTY
 LAK-2-7.39

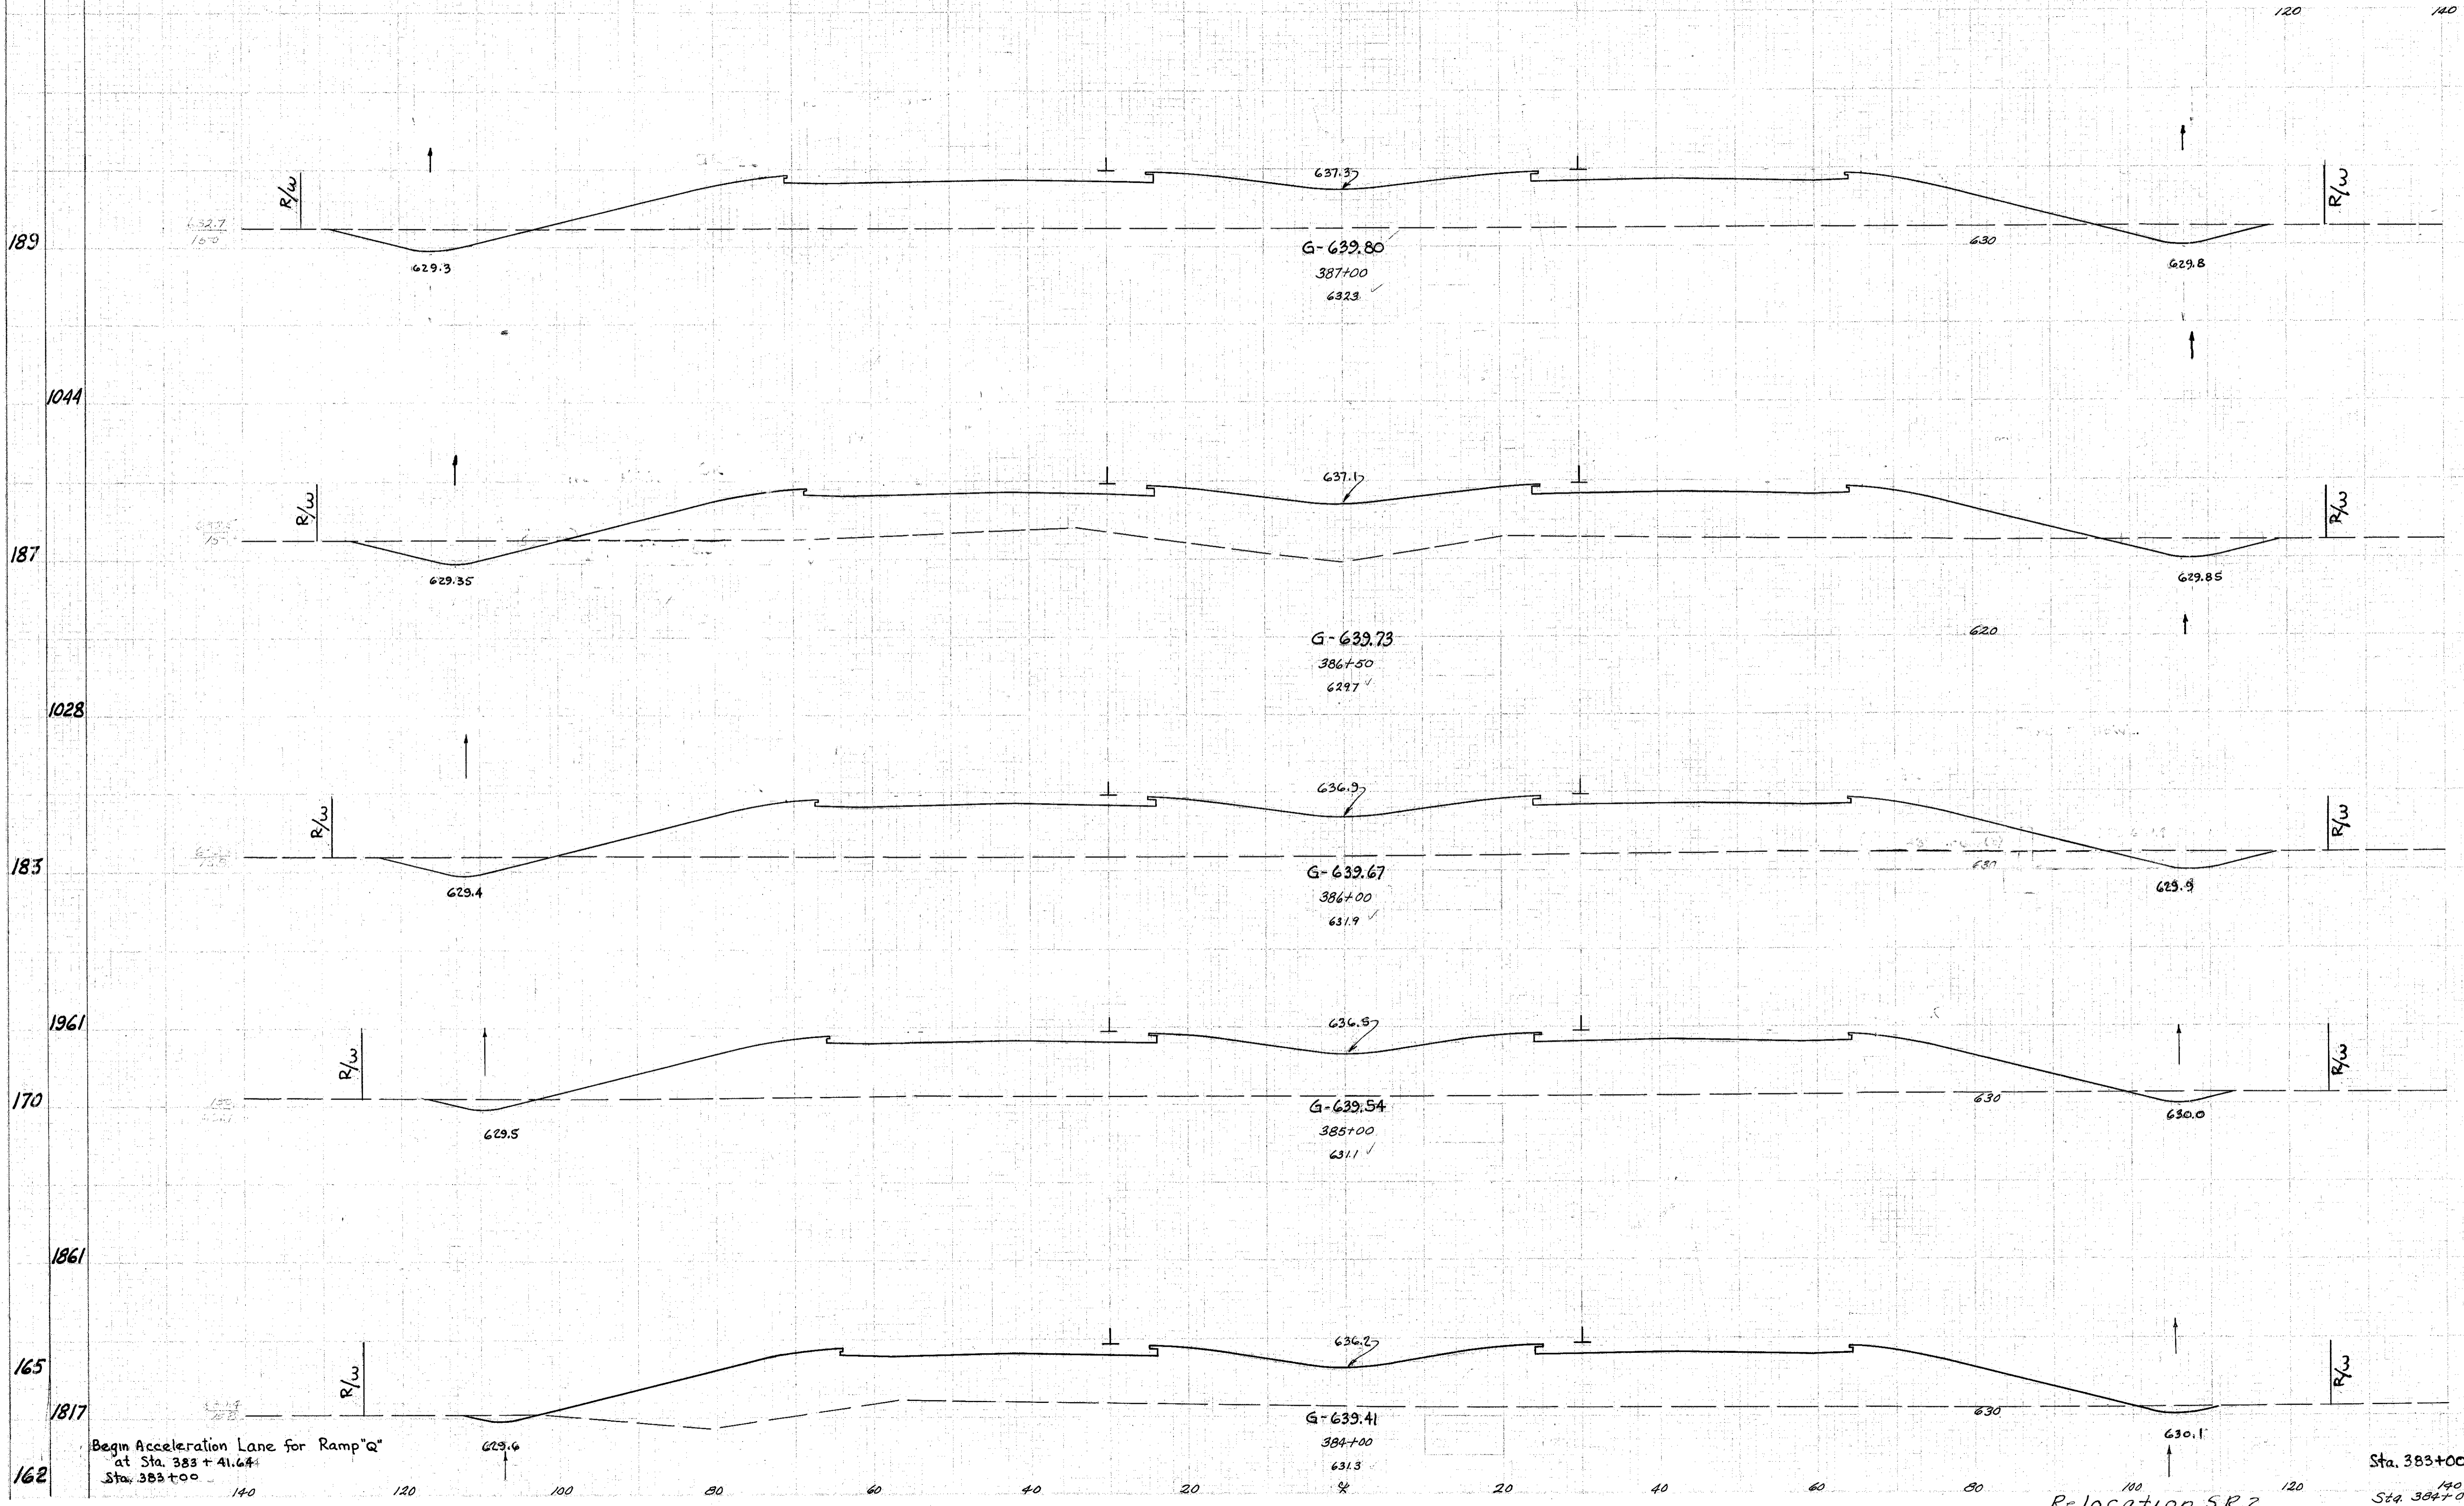

END AREA		CU. YDS.	
Cut	Fill	Cut	Fill
65	1061		130
75	1019		125
60	1108		159
26	1226		70
12	1210		41
10	1231		

Revised 11-11-58
 1/17/58
 Temp. 5-10-58 M.S.
 5-26-58 mmw

Begin Acceleration Lane for Ramp "Q"
 at Sta. 383+41.64
 Sta. 383+00

Relocation S.R.2
 Sta. 383+00
 Sta. 384+00 to 387+00