

SEEDING
END WIDTH SQ. YDS.

2 0410 F-329 (16)

60
268

LAKE COUNTY
LAK-2-7.39

STA. 397+00 BEGIN SEPARATION
OF MEDIAN SLOPE TO LT & RT OF
BARRIER RAILMOUND. FULL WIDTH
MOUND TO BE ATTAINED AT STA. 397+54 ±

98

822

50

556

50Ah
115B


1267

113Ah
117BK

1955

175

Sta. 393+00

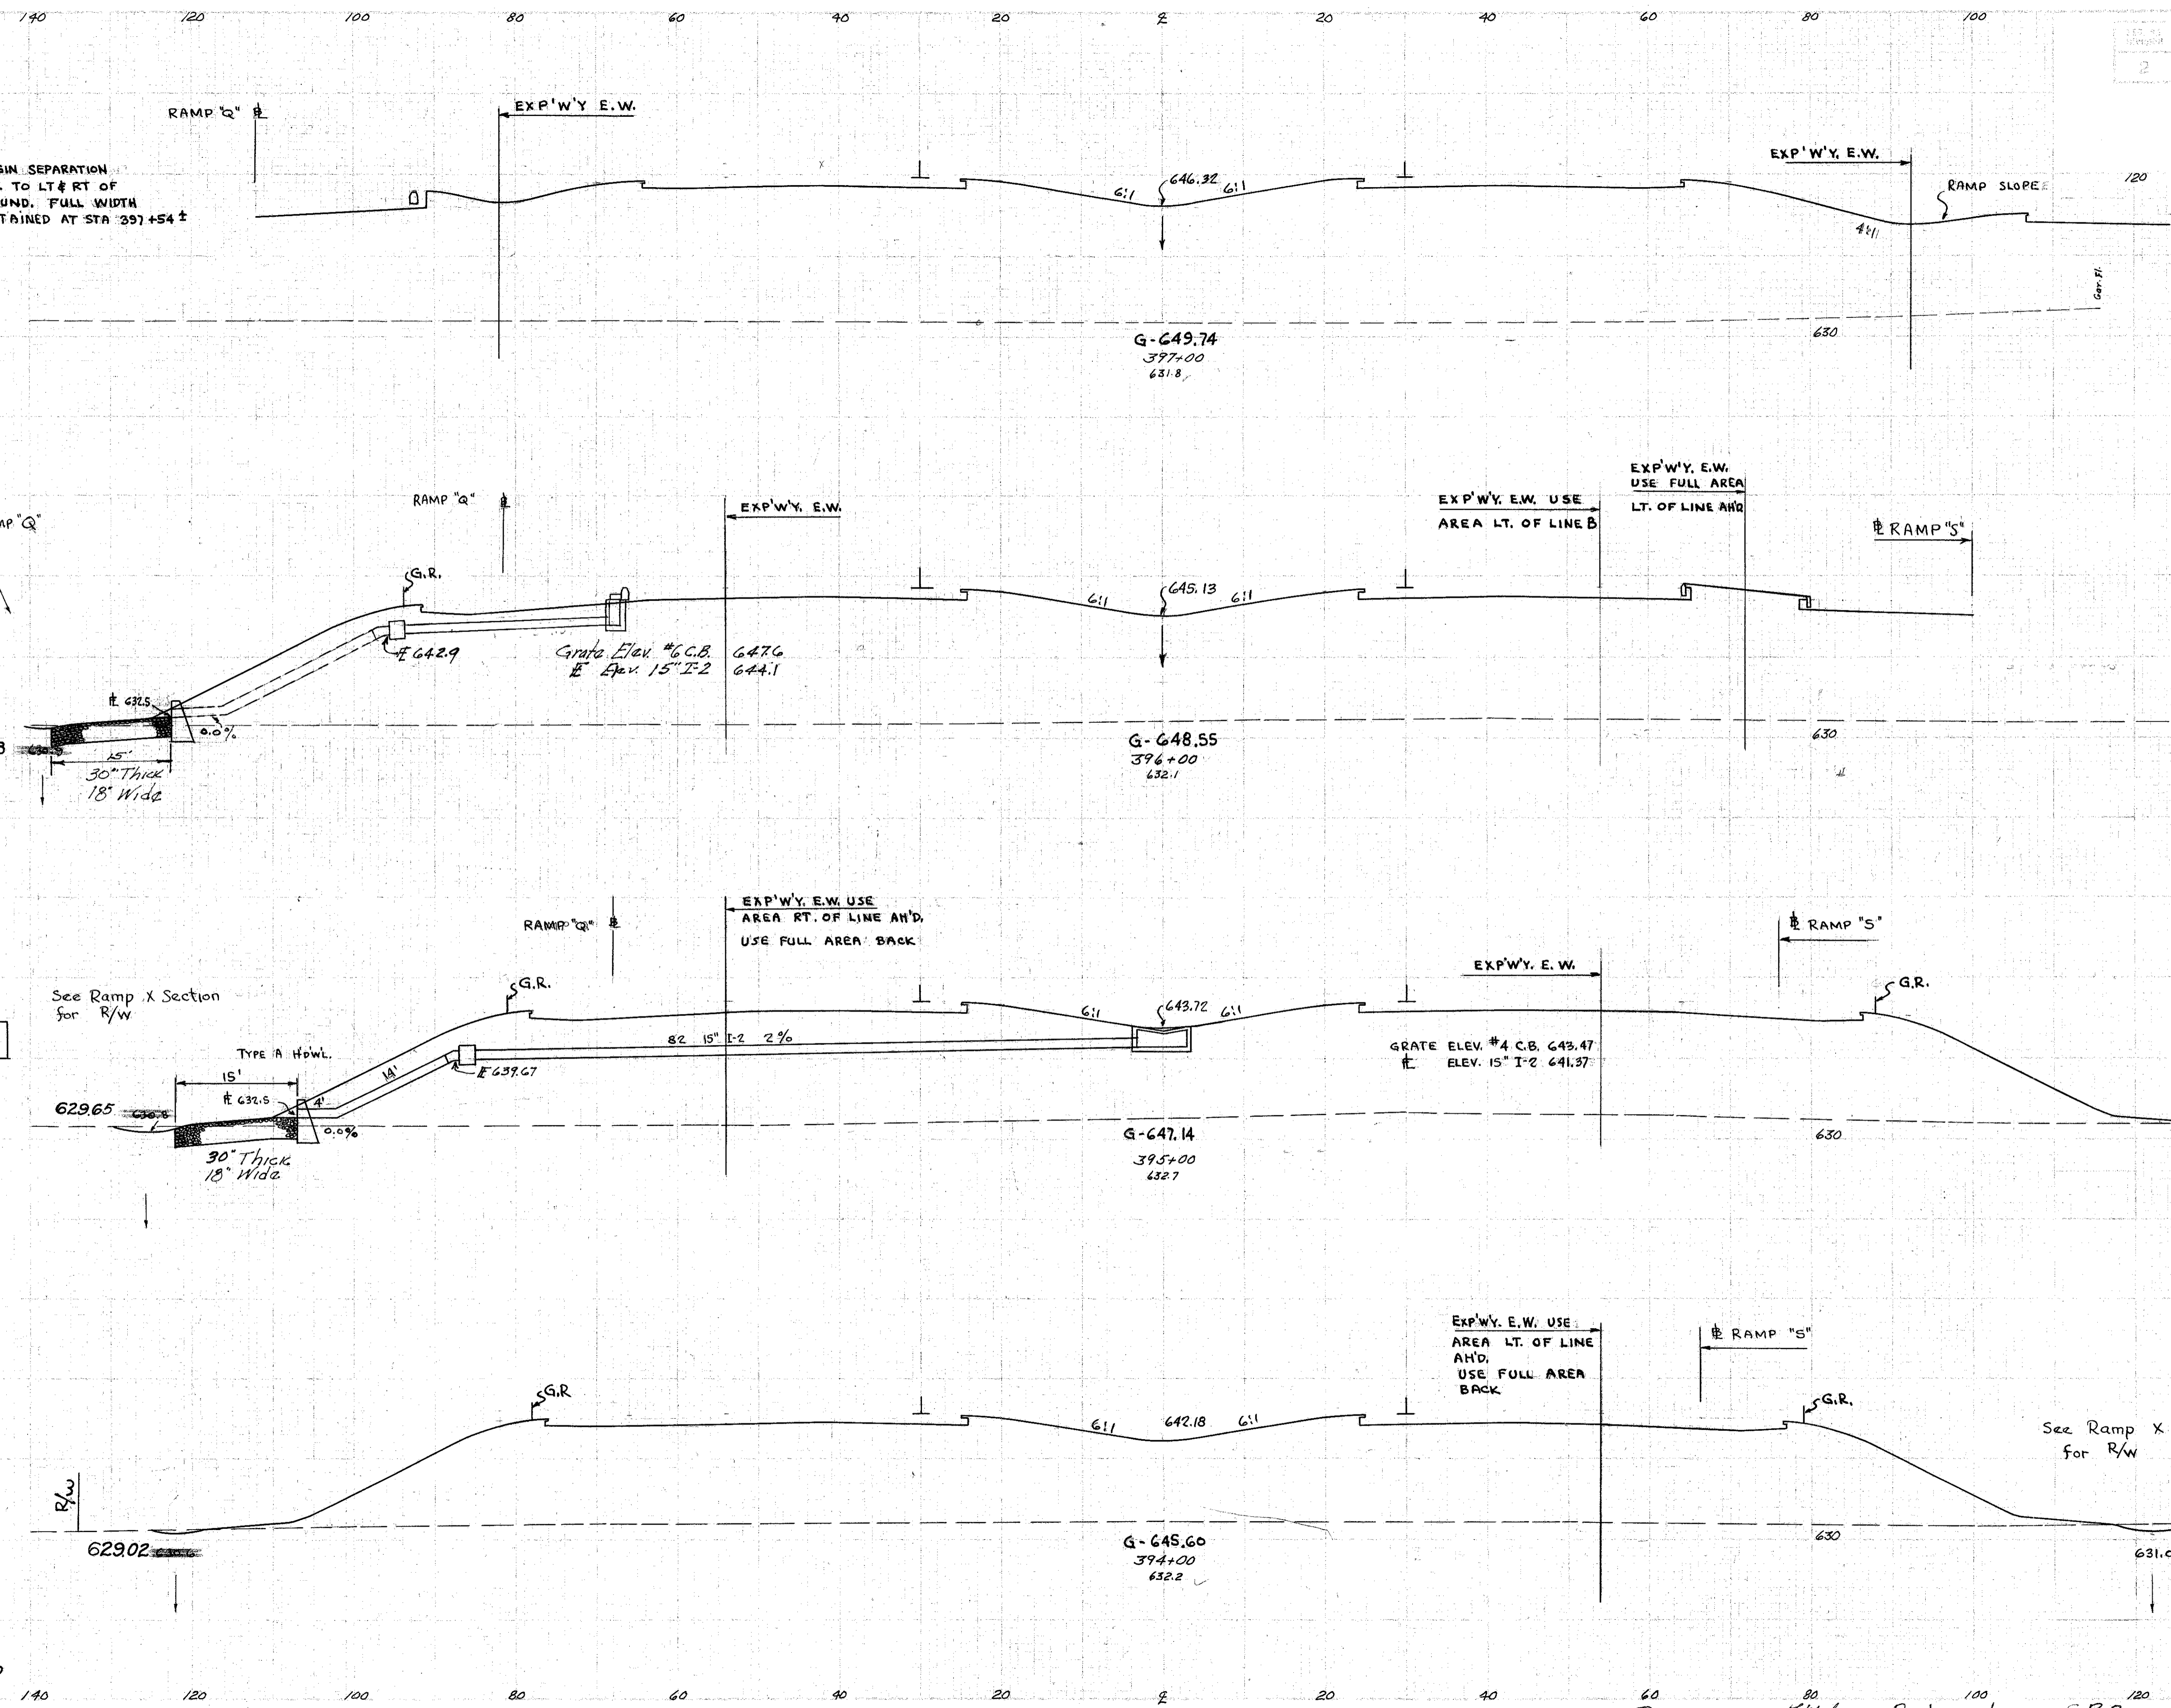

END AREA CU. YDS.
Cut Fill Cut Fill

2822

8154

1905Ah
1622BK

5398

1401Ah
2015BK

7072

2Ah 1804Ah
8BK 2304BK

31 8083

Sta. 393+00 9 2061

Sta. 394+00 to 397+00

Rev. 11-14-58 Relocation S.R.2

Checked by 9-16-58
D.M. 9-14-58