


Seeding
End Width
G.S.
Yds.

REV. CLASS.	STATE	PROJECT
2	OHIO	F-329 (16)

74-R
268

LAKE COUNTY
LAK-2-7.39
REV. 3-17-59

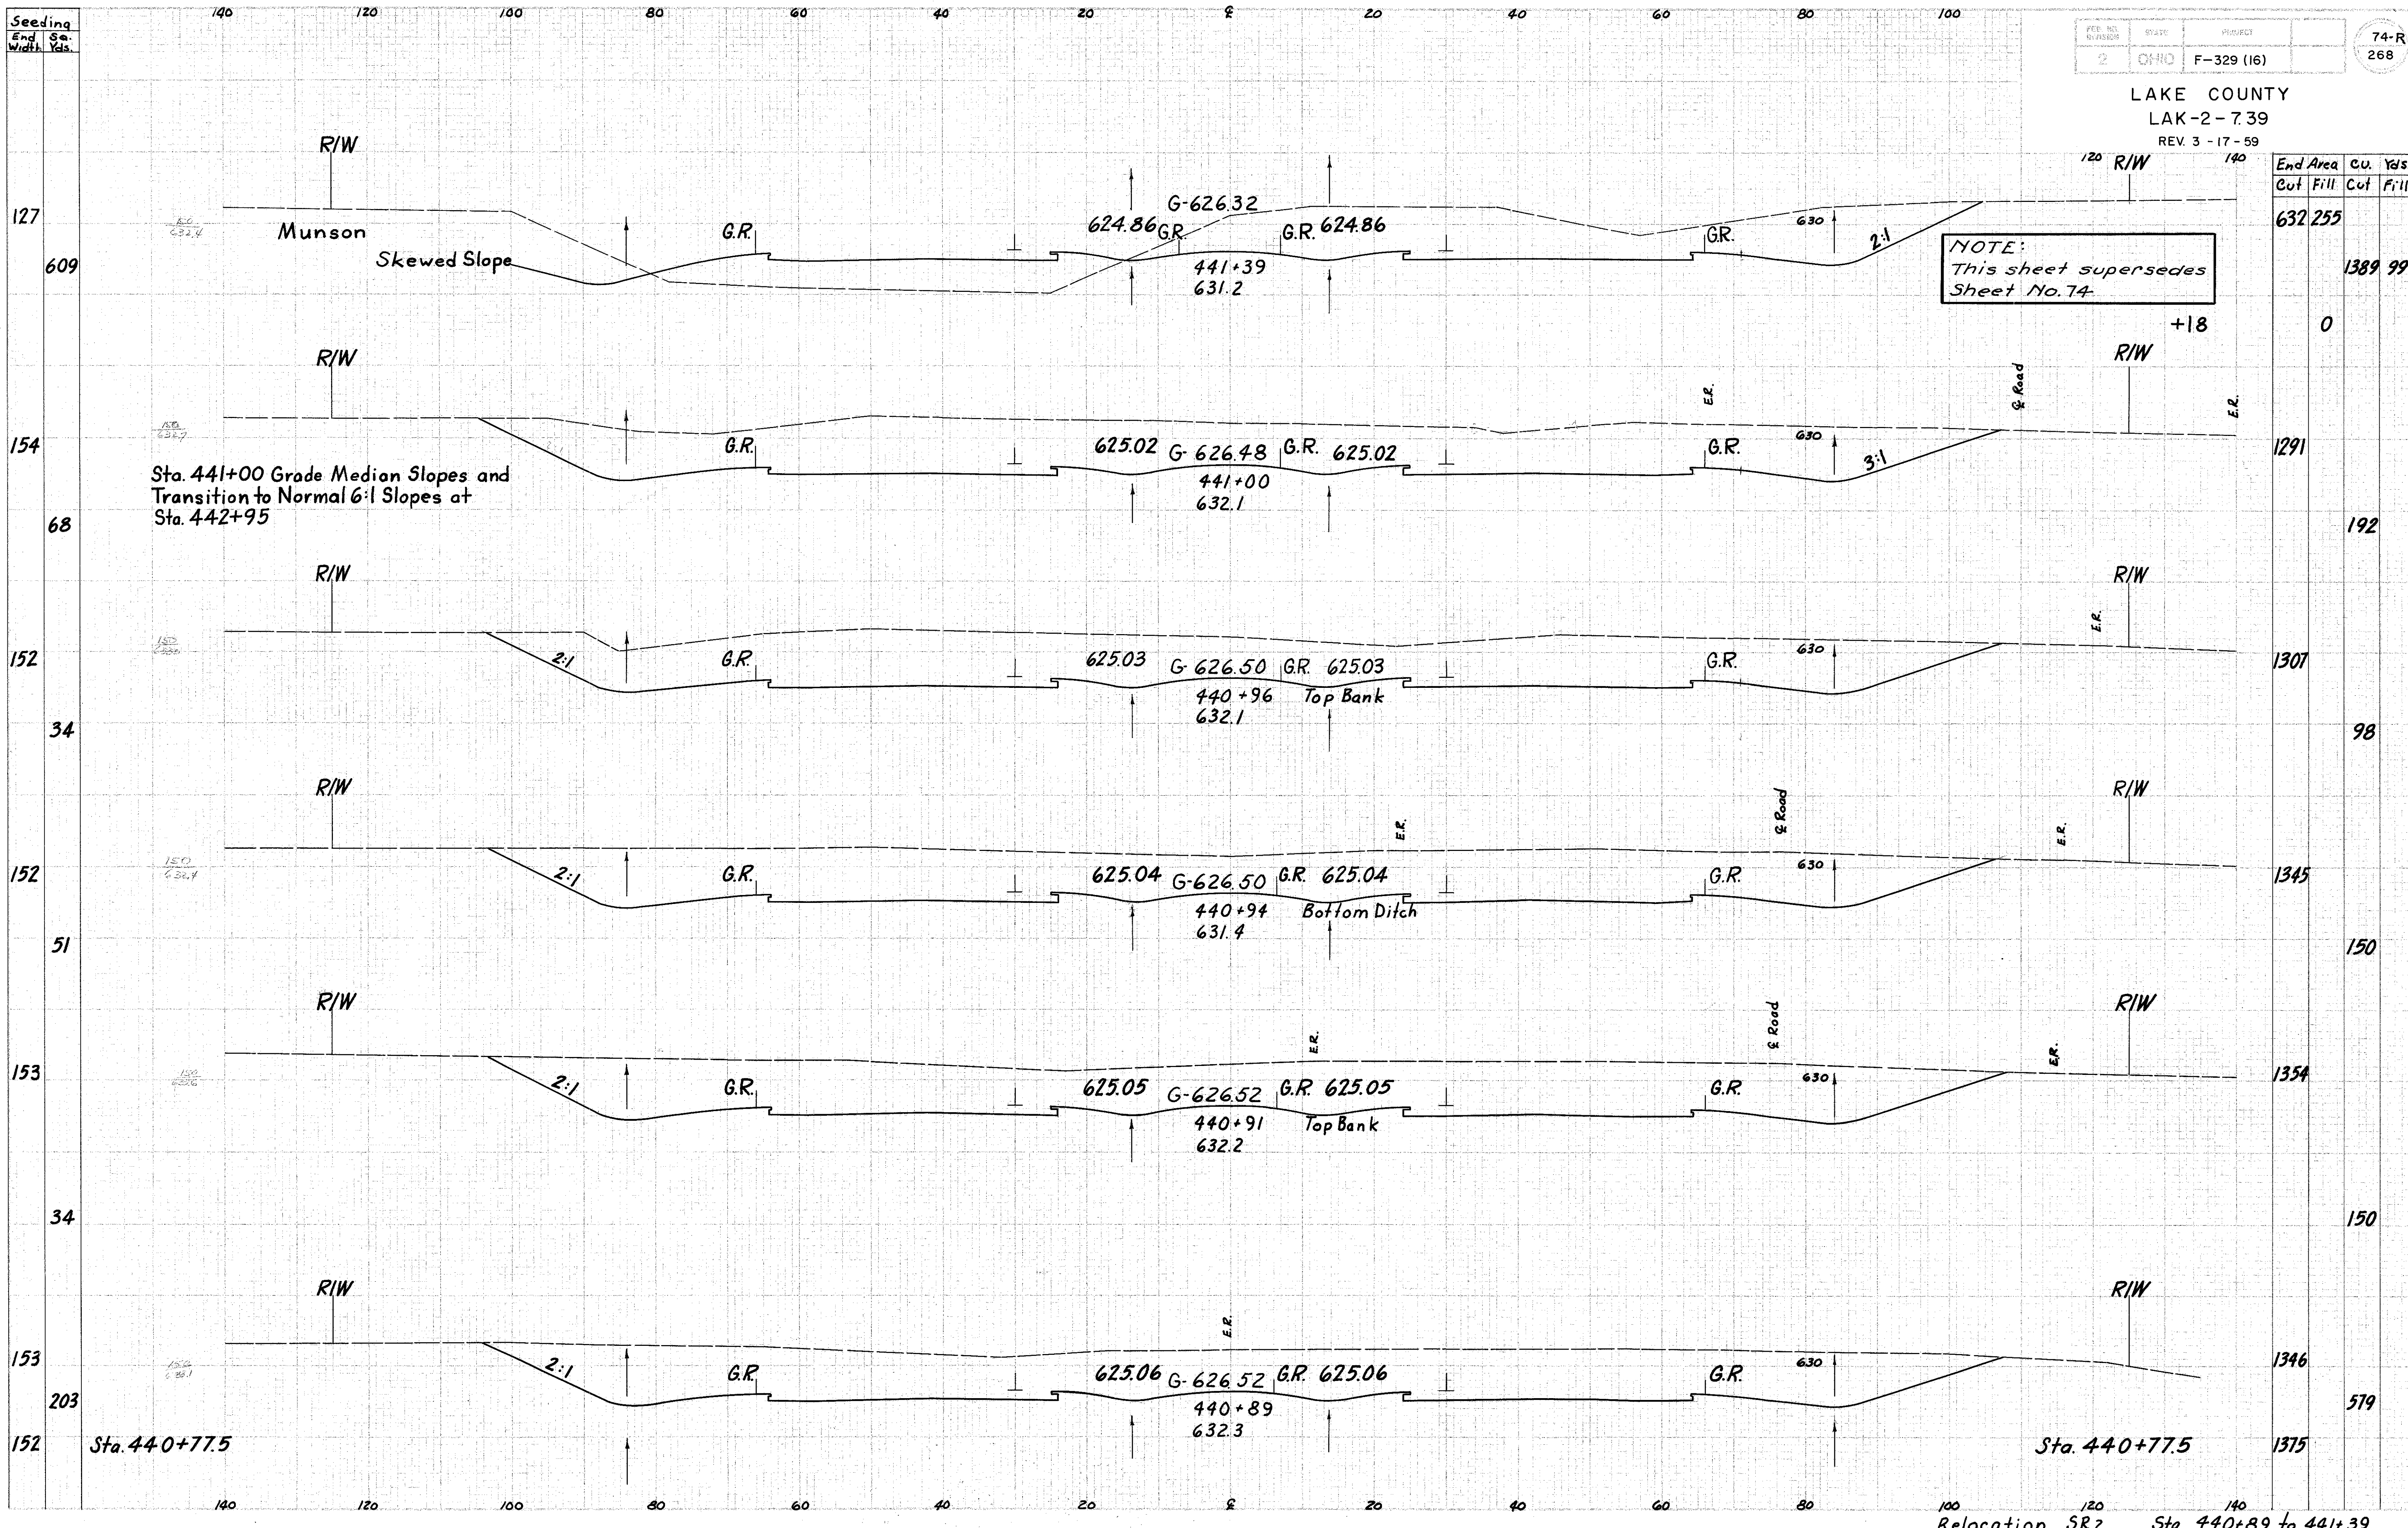

NOTE:
This sheet supersedes
Sheet No. 74.

End Area	Cu. Yds.
Cut	Fill
632	255
	1389 99
	0
	1291
	192
	1307
	98
	1345
	150
	1354
	150
	1346
	579
	1375

Sta. 441+00 Grade Median Slopes and
Transition to Normal 6:1 Slopes at
Sta. 442+95

Sta. 440+77.5

Sta. 440+77.5

Relocation S.R.2 Sta. 440+89 to 441+39