

Seeding
End Sta.
Width Yds.

140 120 100 80 60 40 20 0 20 40 60 80 100


FED. DIST. DISTRICT	STATE	PROJECT
2	OHIO	F-329 (16)

76-R
268

LAKE COUNTY
LAK-2-7.39
REV. 3-17-59

NOTE:
This sheet supersedes
Sheet No. 76

End Area	Cu. Yds.
Cut	Fill

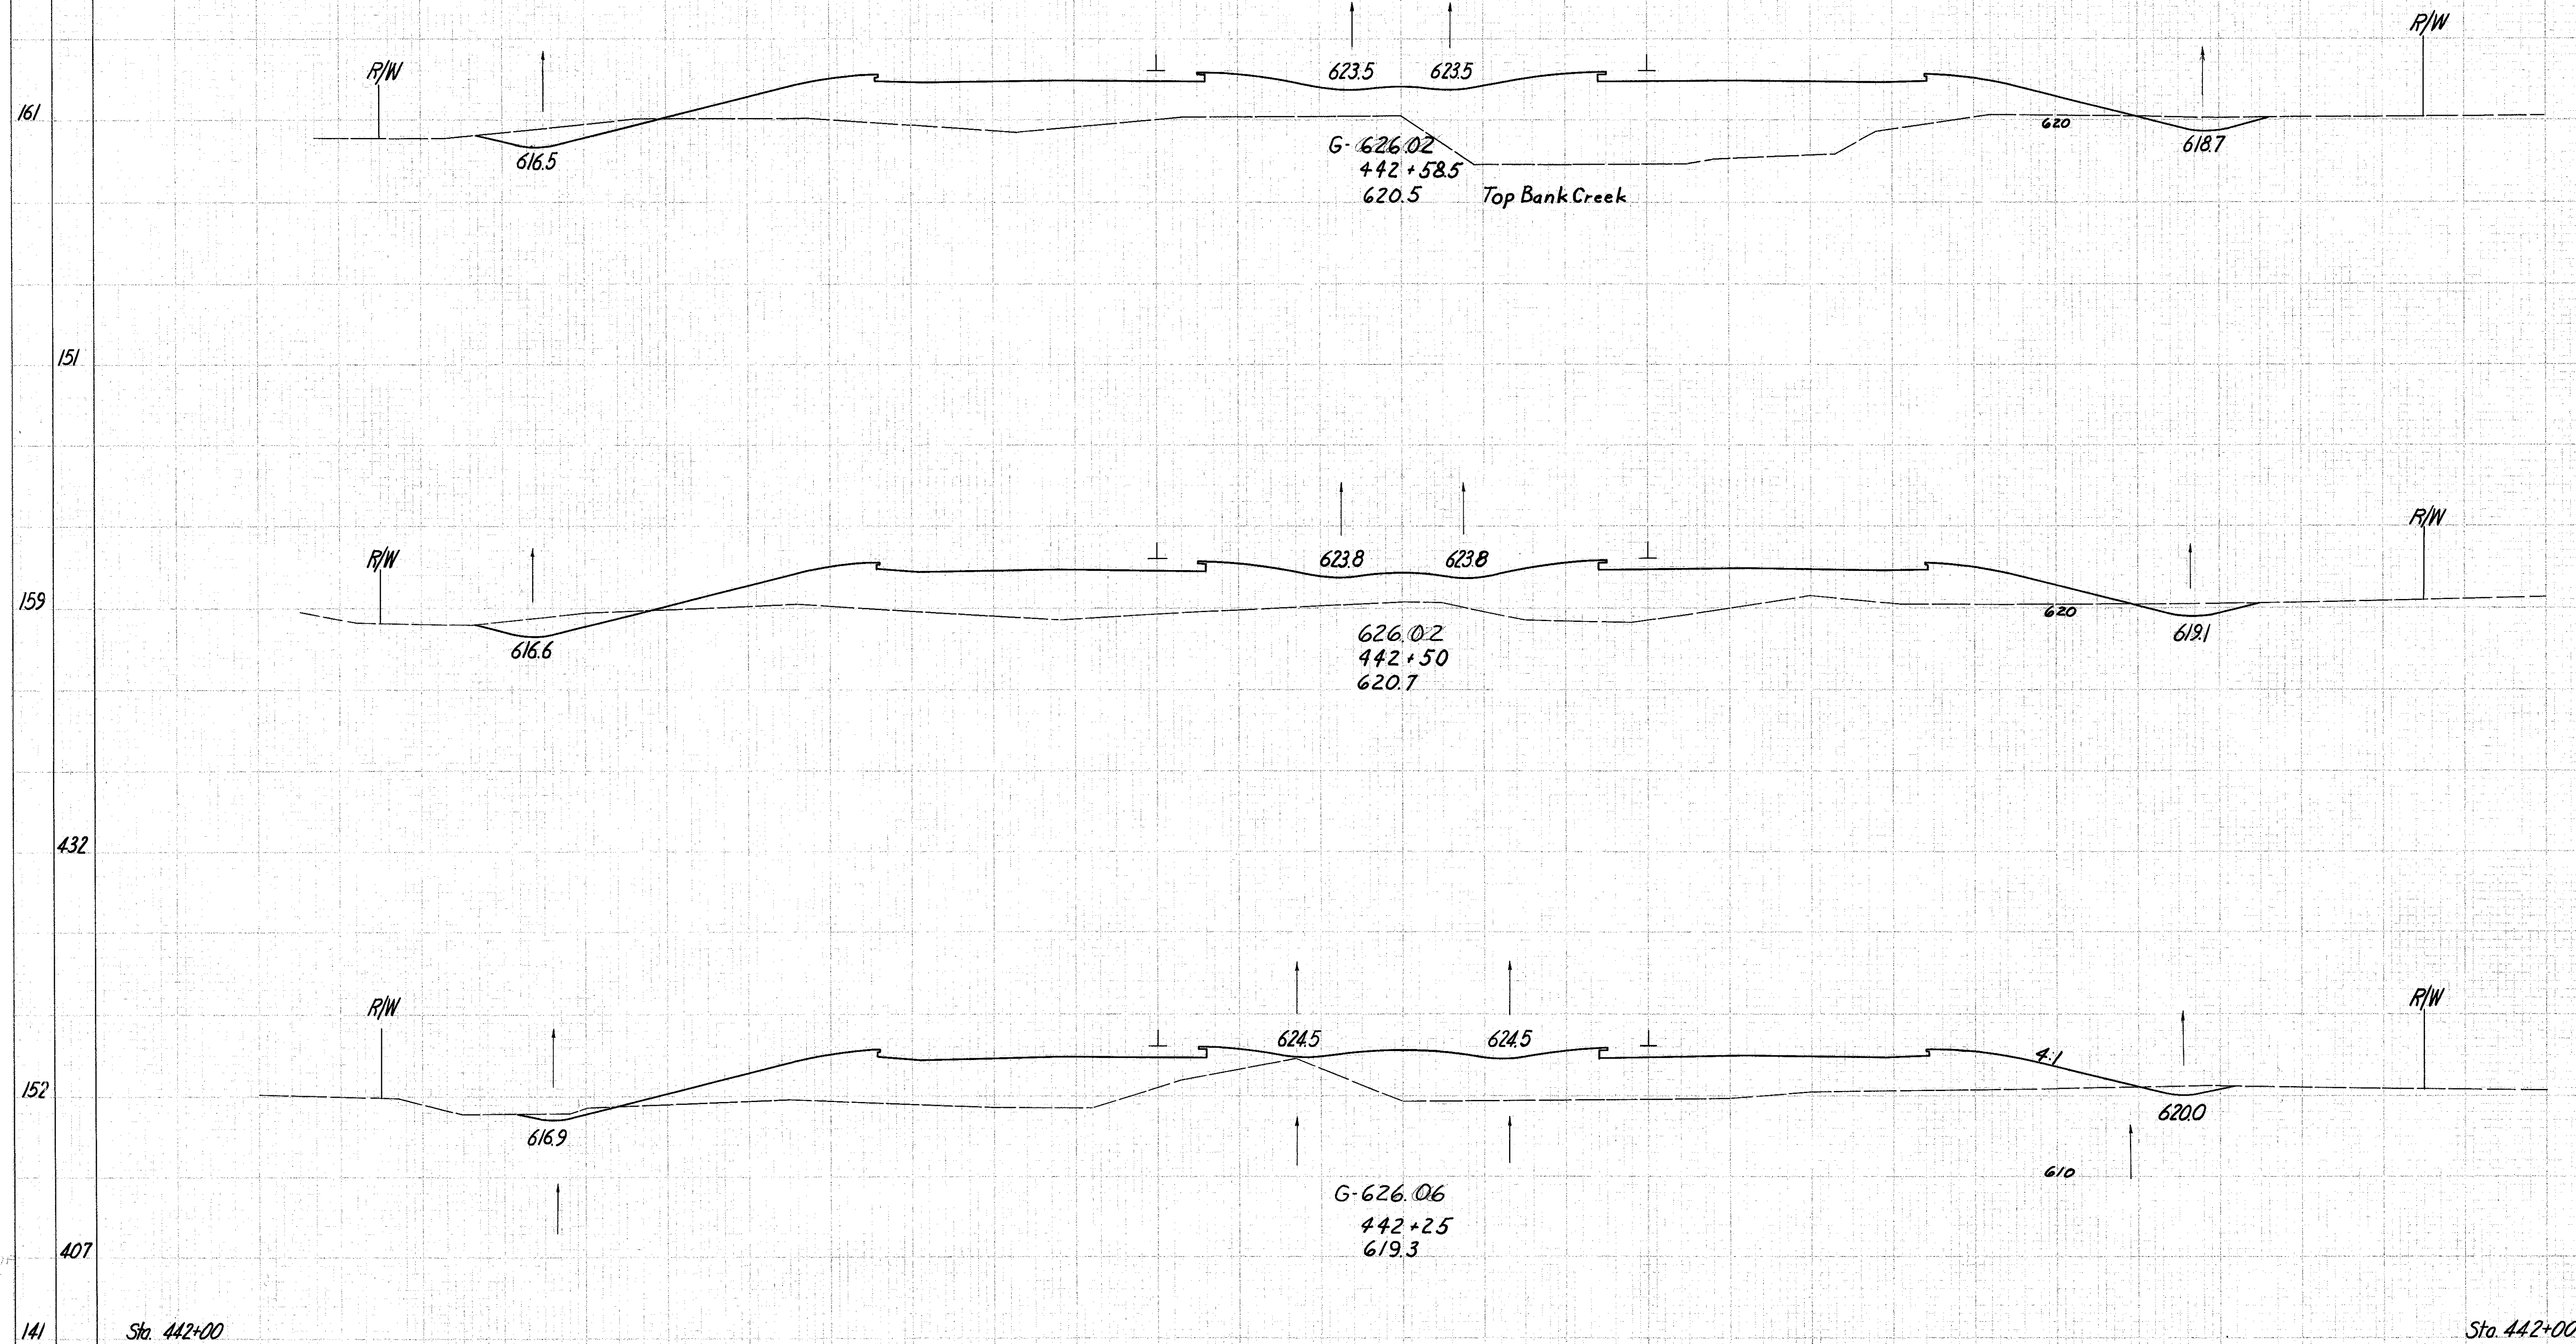

54 1045

15 291

42 806

27 741

17 795

24 799

34 930

Plotted on 1/2" x 1/4" paper

Relocation S.R. 2 Sta. 442+25 to 442+58.5