


Seeding  
End Sta.  
Width Yds.

REV. NO.	DATE	PROJECT	77-R
2	OHIO	F-329 (16)	268

LAKE COUNTY  
LAK-2-7.39  
REV. 3-17-59

NOTE:  
This sheet supersedes  
Sheet No. 77.

End	Area		Cu. Yds.	
	Cut	Fill	Cut	Fill
253	1114			
76		580		
50	1205			
10		208		
54	1045			

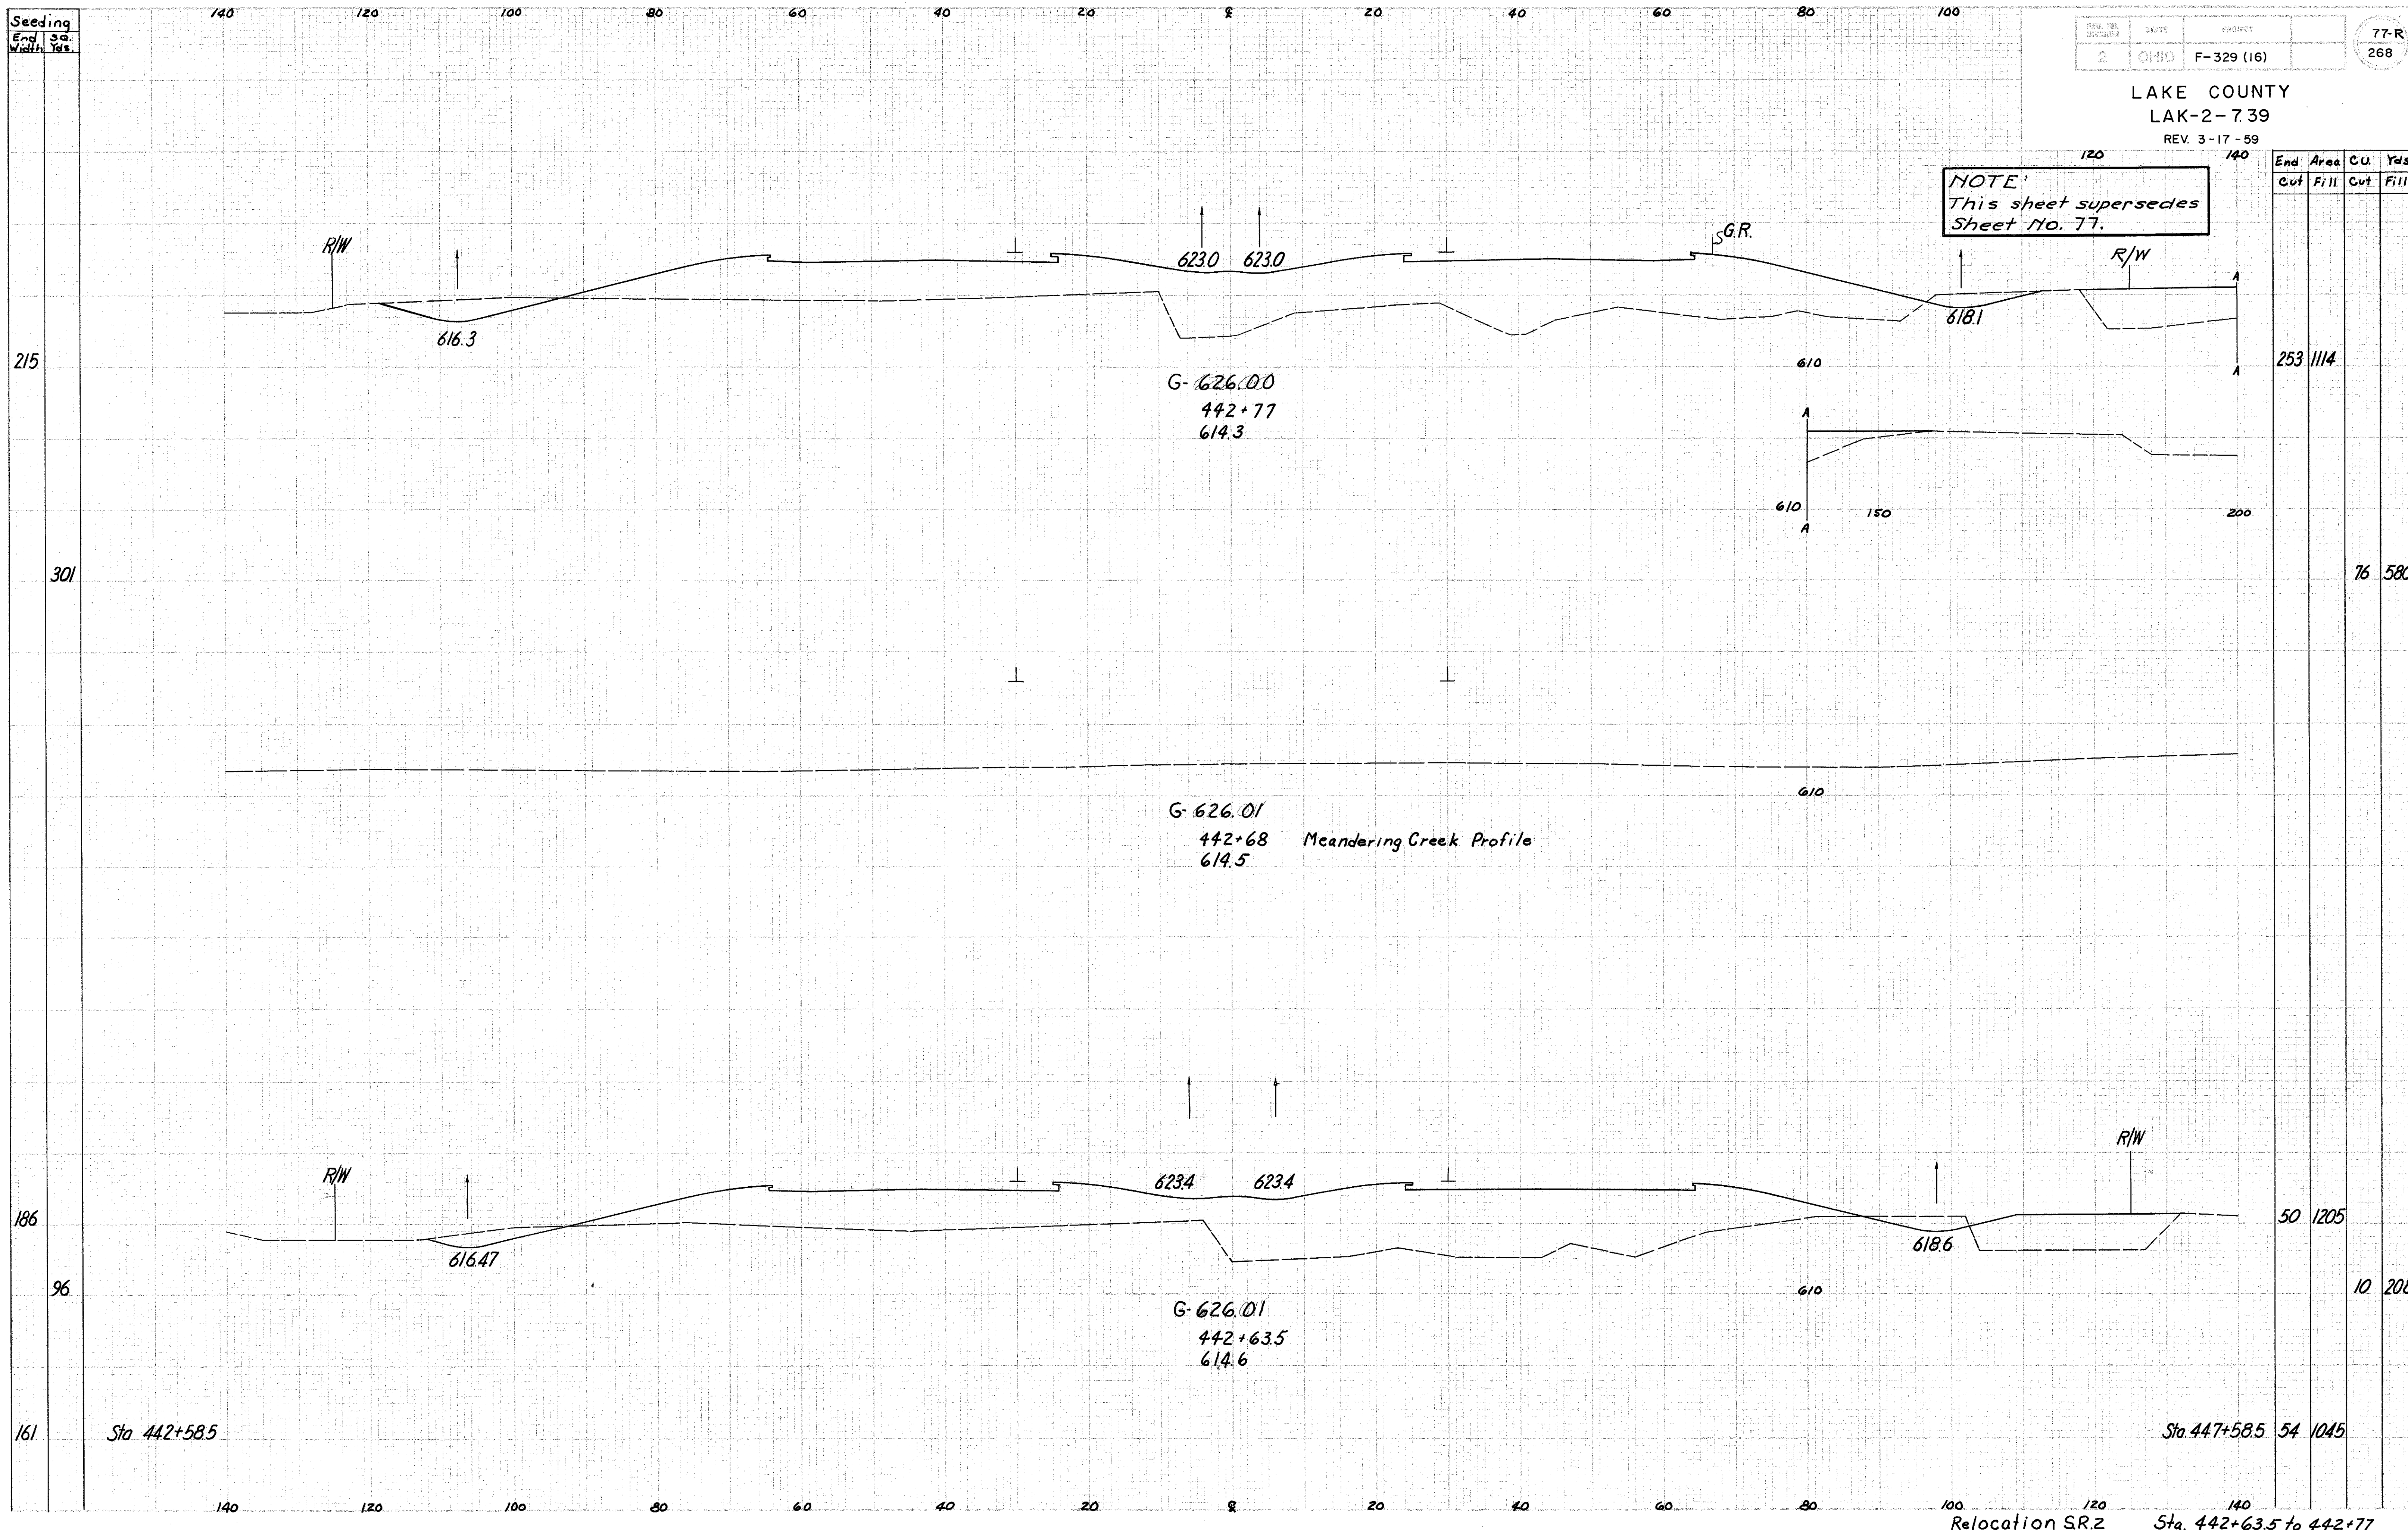

G-626.00  
442+77  
614.3

G-626.01  
442+68 Meandering Creek Profile  
614.5

G-626.01  
442+63.5  
614.6

Relocation SR2 Sta. 442+63.5 to 442+77

Plotted 2/11/59