


Seeding
End Width Sta. Yds

LAKE COUNTY
LAK-2-7.39
REV. 3-17-59

NOTE:
This sheet supersedes
Sheet No. 80.

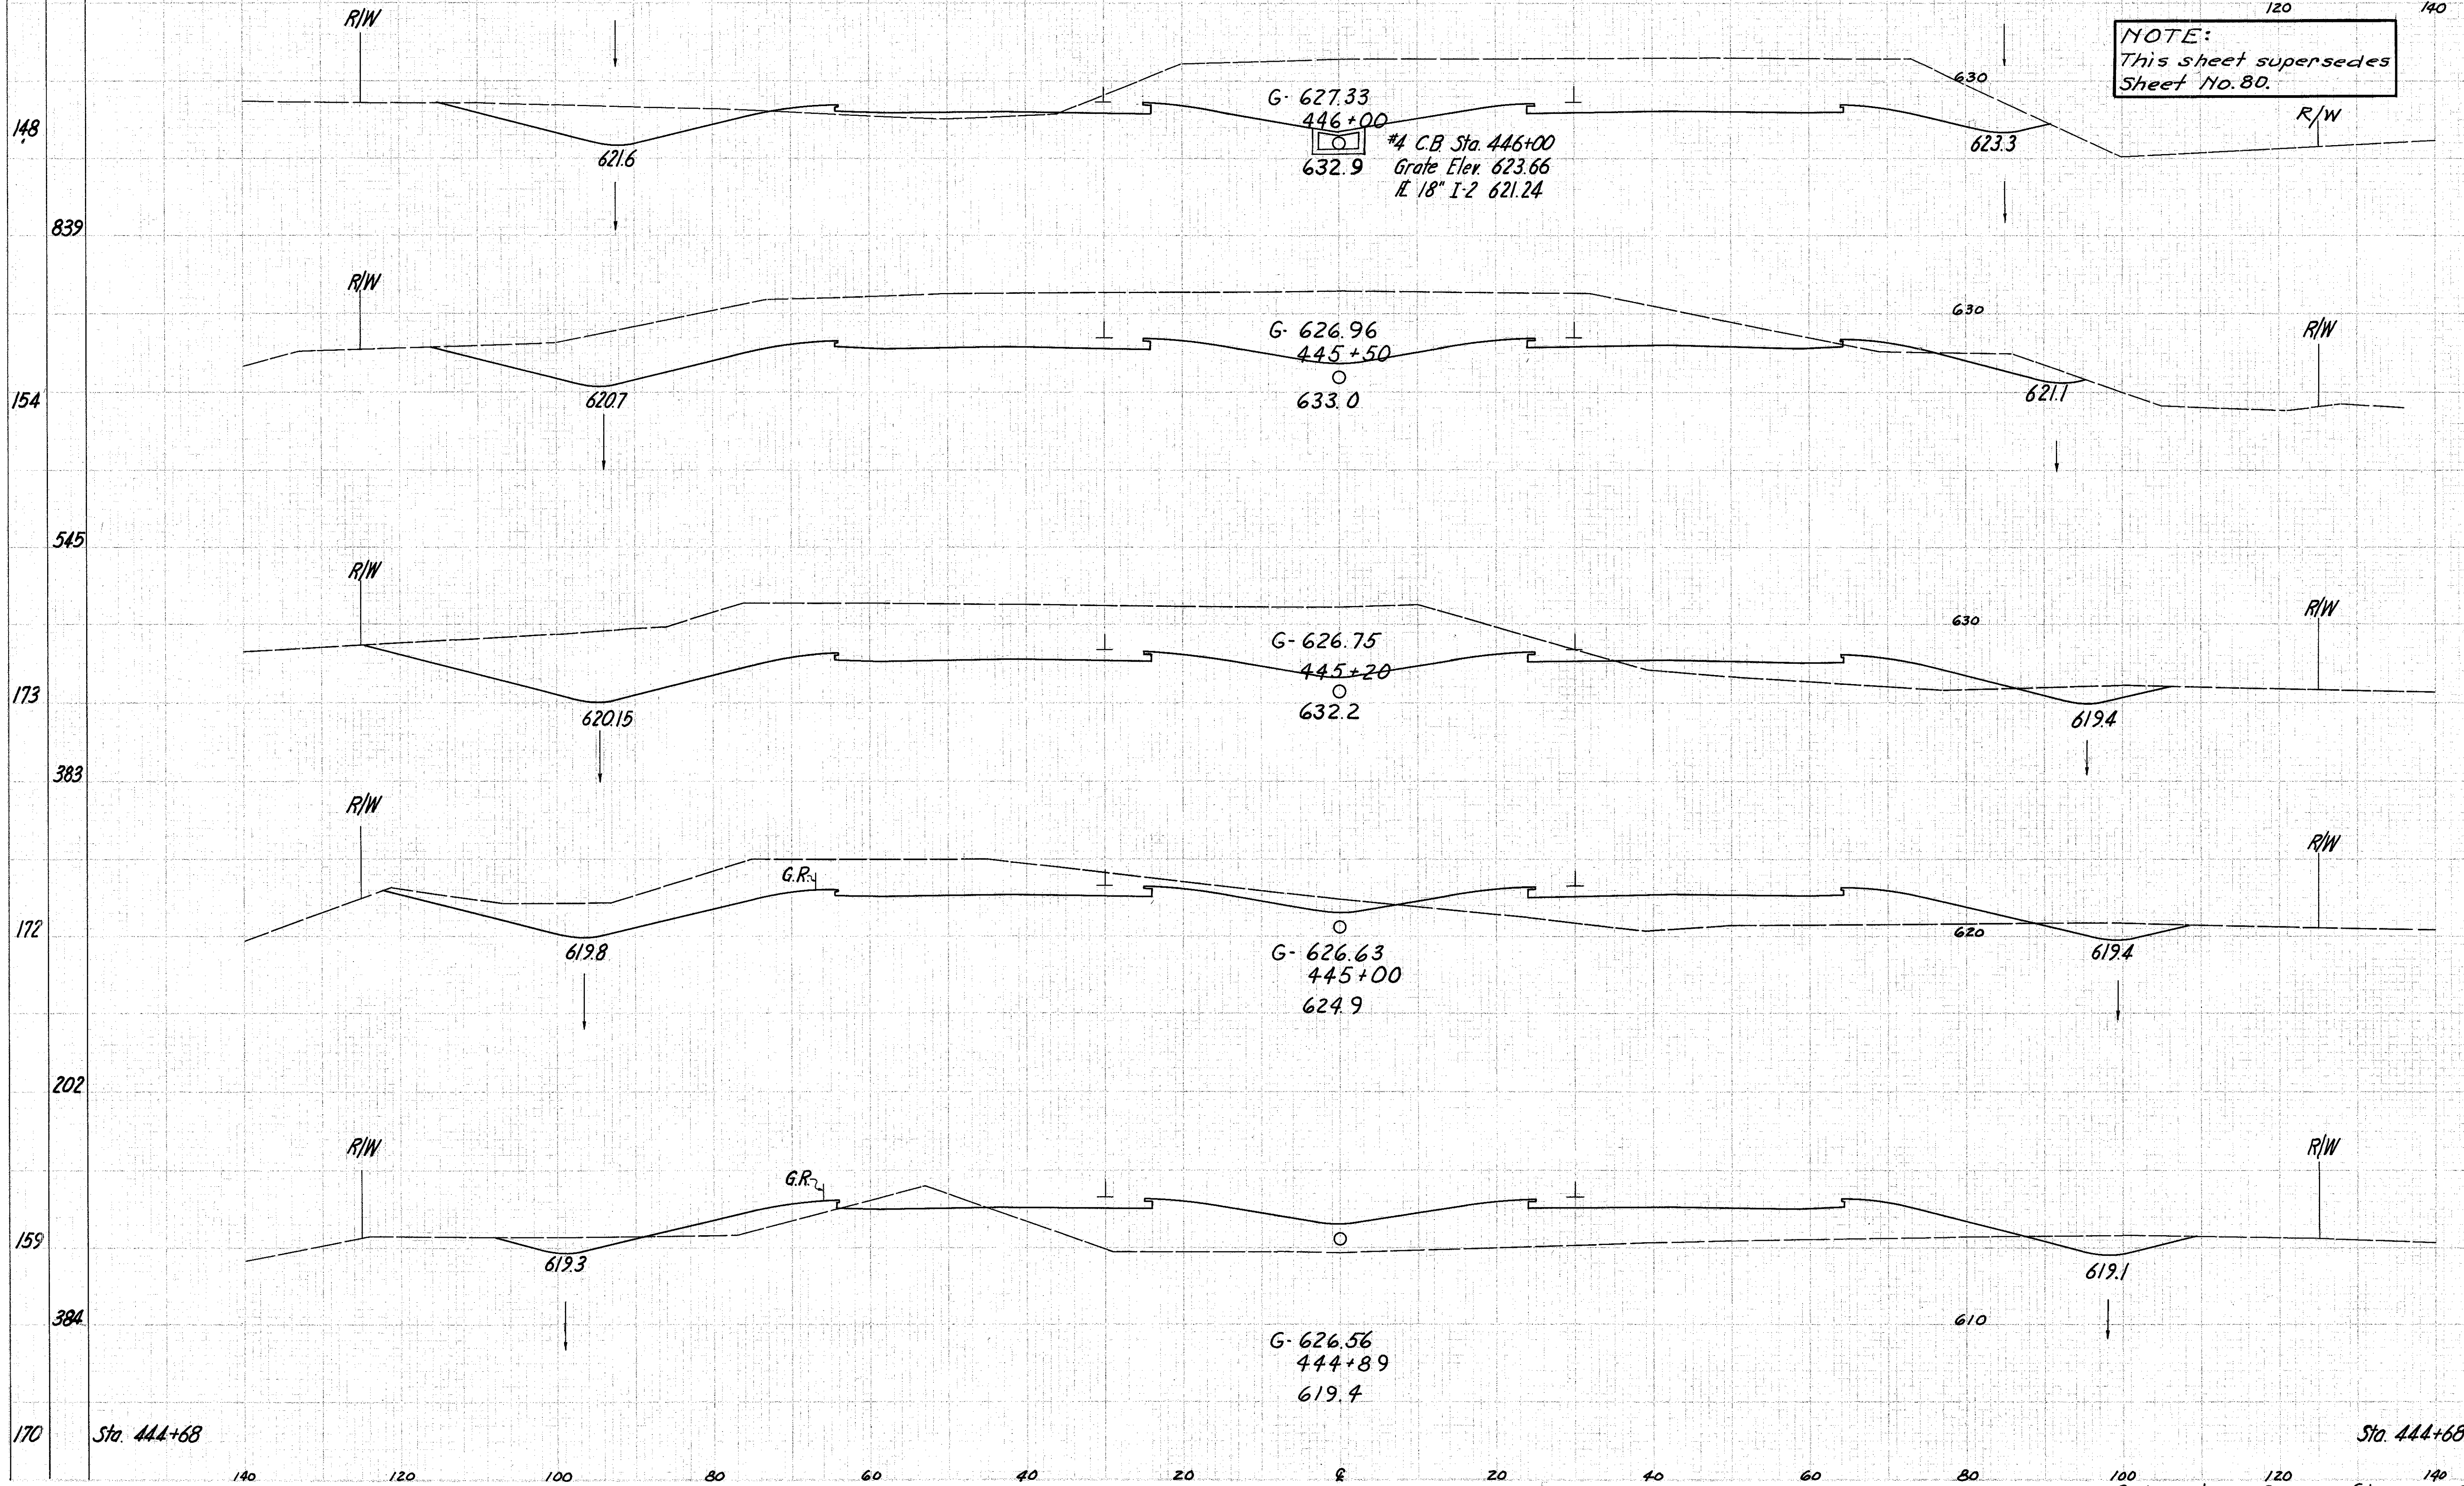

End Area	Cu. Yds	
	Cut	Fill
905	23	
1082	10	
1040	114	
442	269	
87	623	