

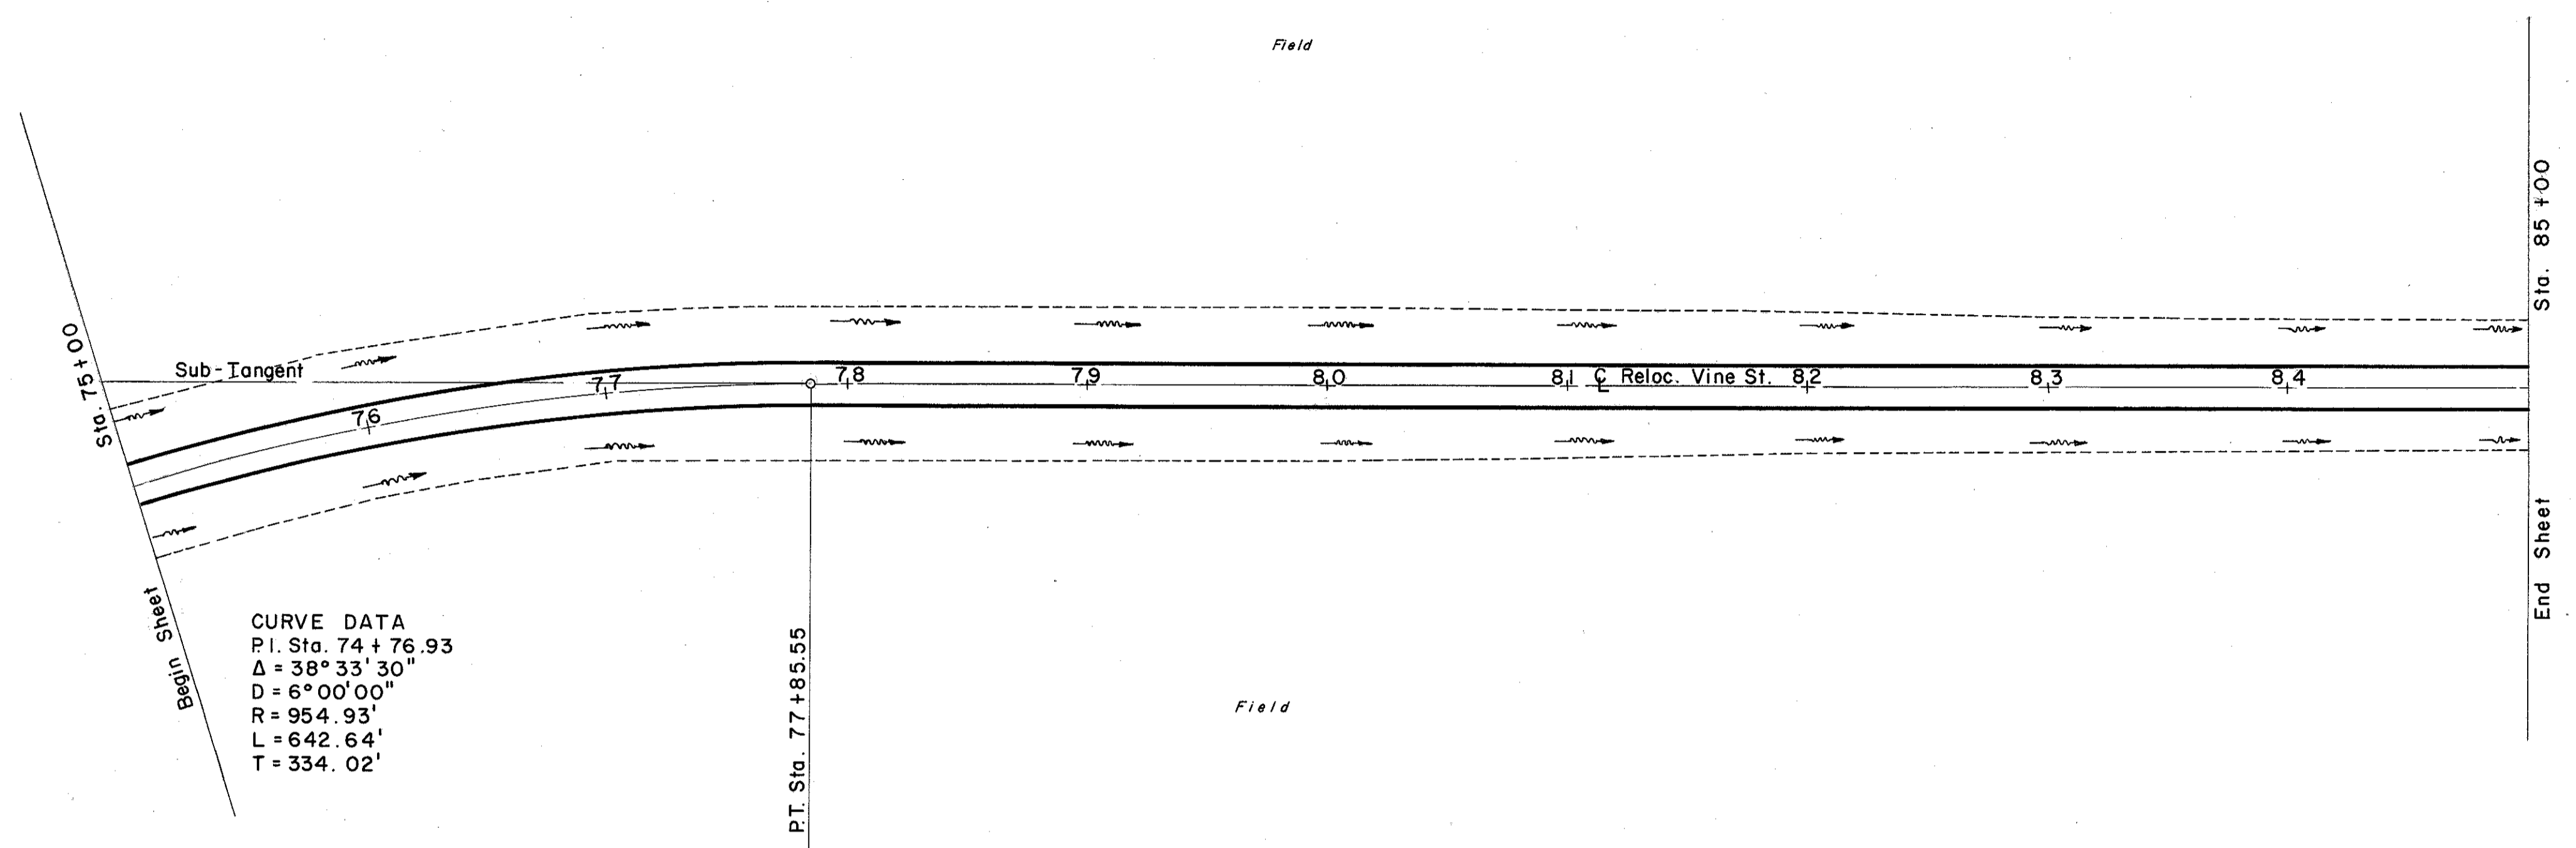


LAKE COUNTY  
LAK-2-7.39  
REV. 11-14-58  
*This sheet replaces  
Sheet No. 83 of  
the original plans.*

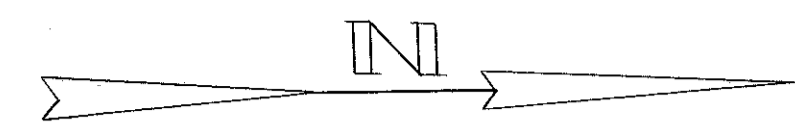

CURVE DATA  
P.I. Sta. 74 + 76.93  
 $\Delta = 38^\circ 33' 30''$   
 $D = 6^\circ 00' 00''$   
R = 954.93'  
L = 642.64'  
T = 334.02'

SUPERELEVATION NOTE: Transition Pavement  
from Full Super Rate 0.063'/Ft. at Sta. 77+22 to  
Normal Cross Slope at Sta. 78+50.

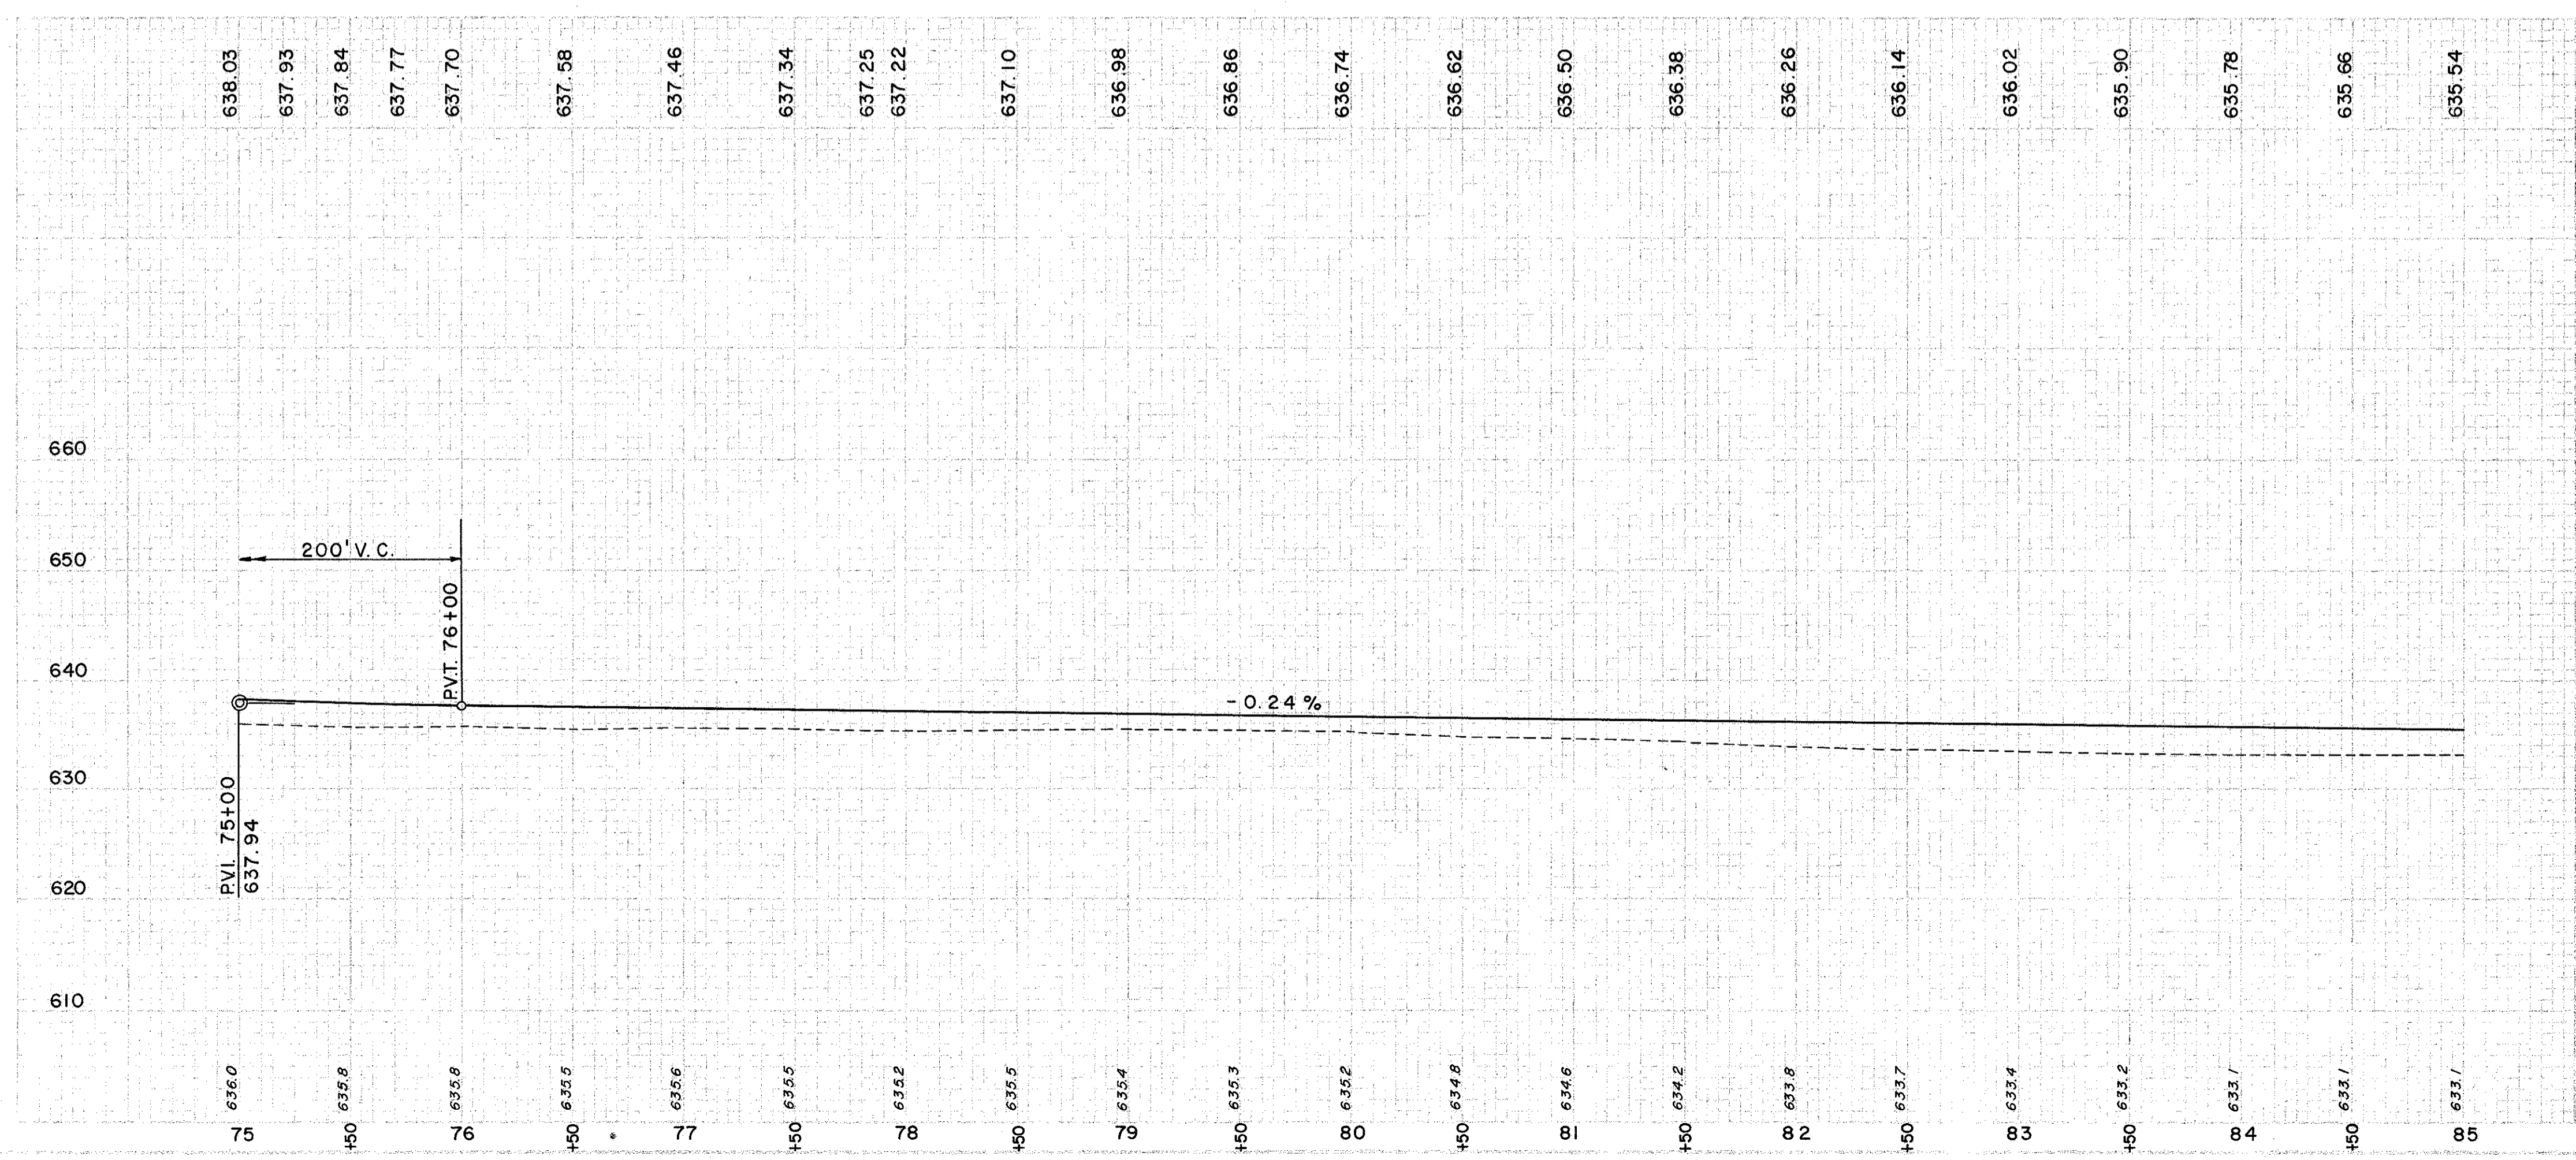

Excavation	= 780 C.Y.
Embankment	= 1734 C.Y.
Embankment $\times 20'$	= 2081 C.Y.