
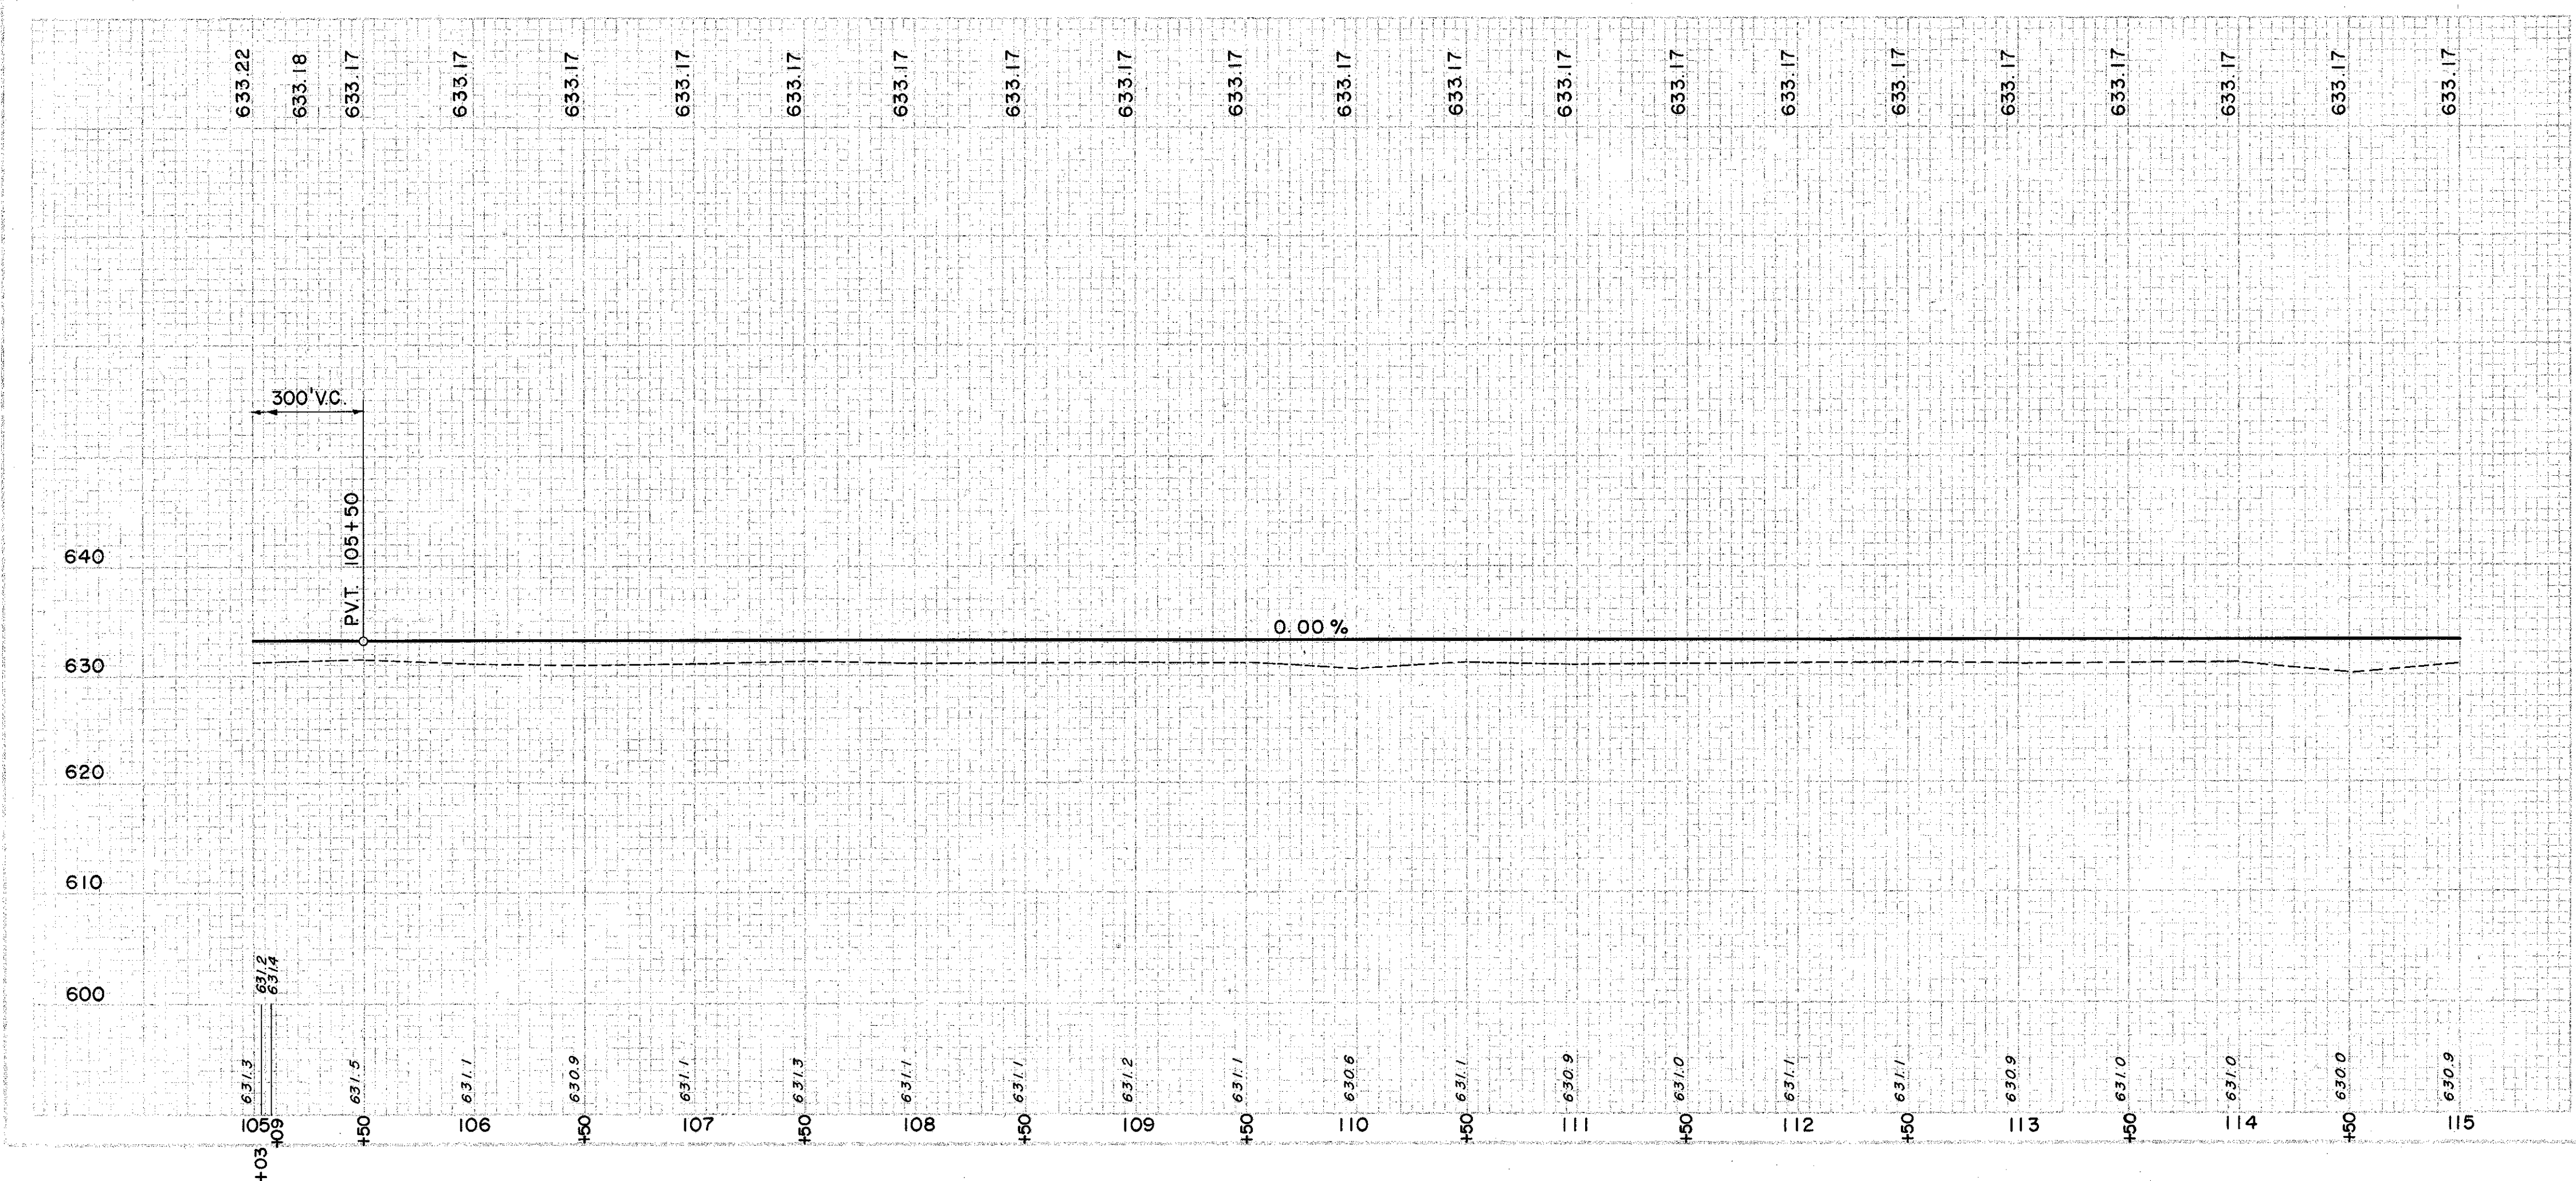
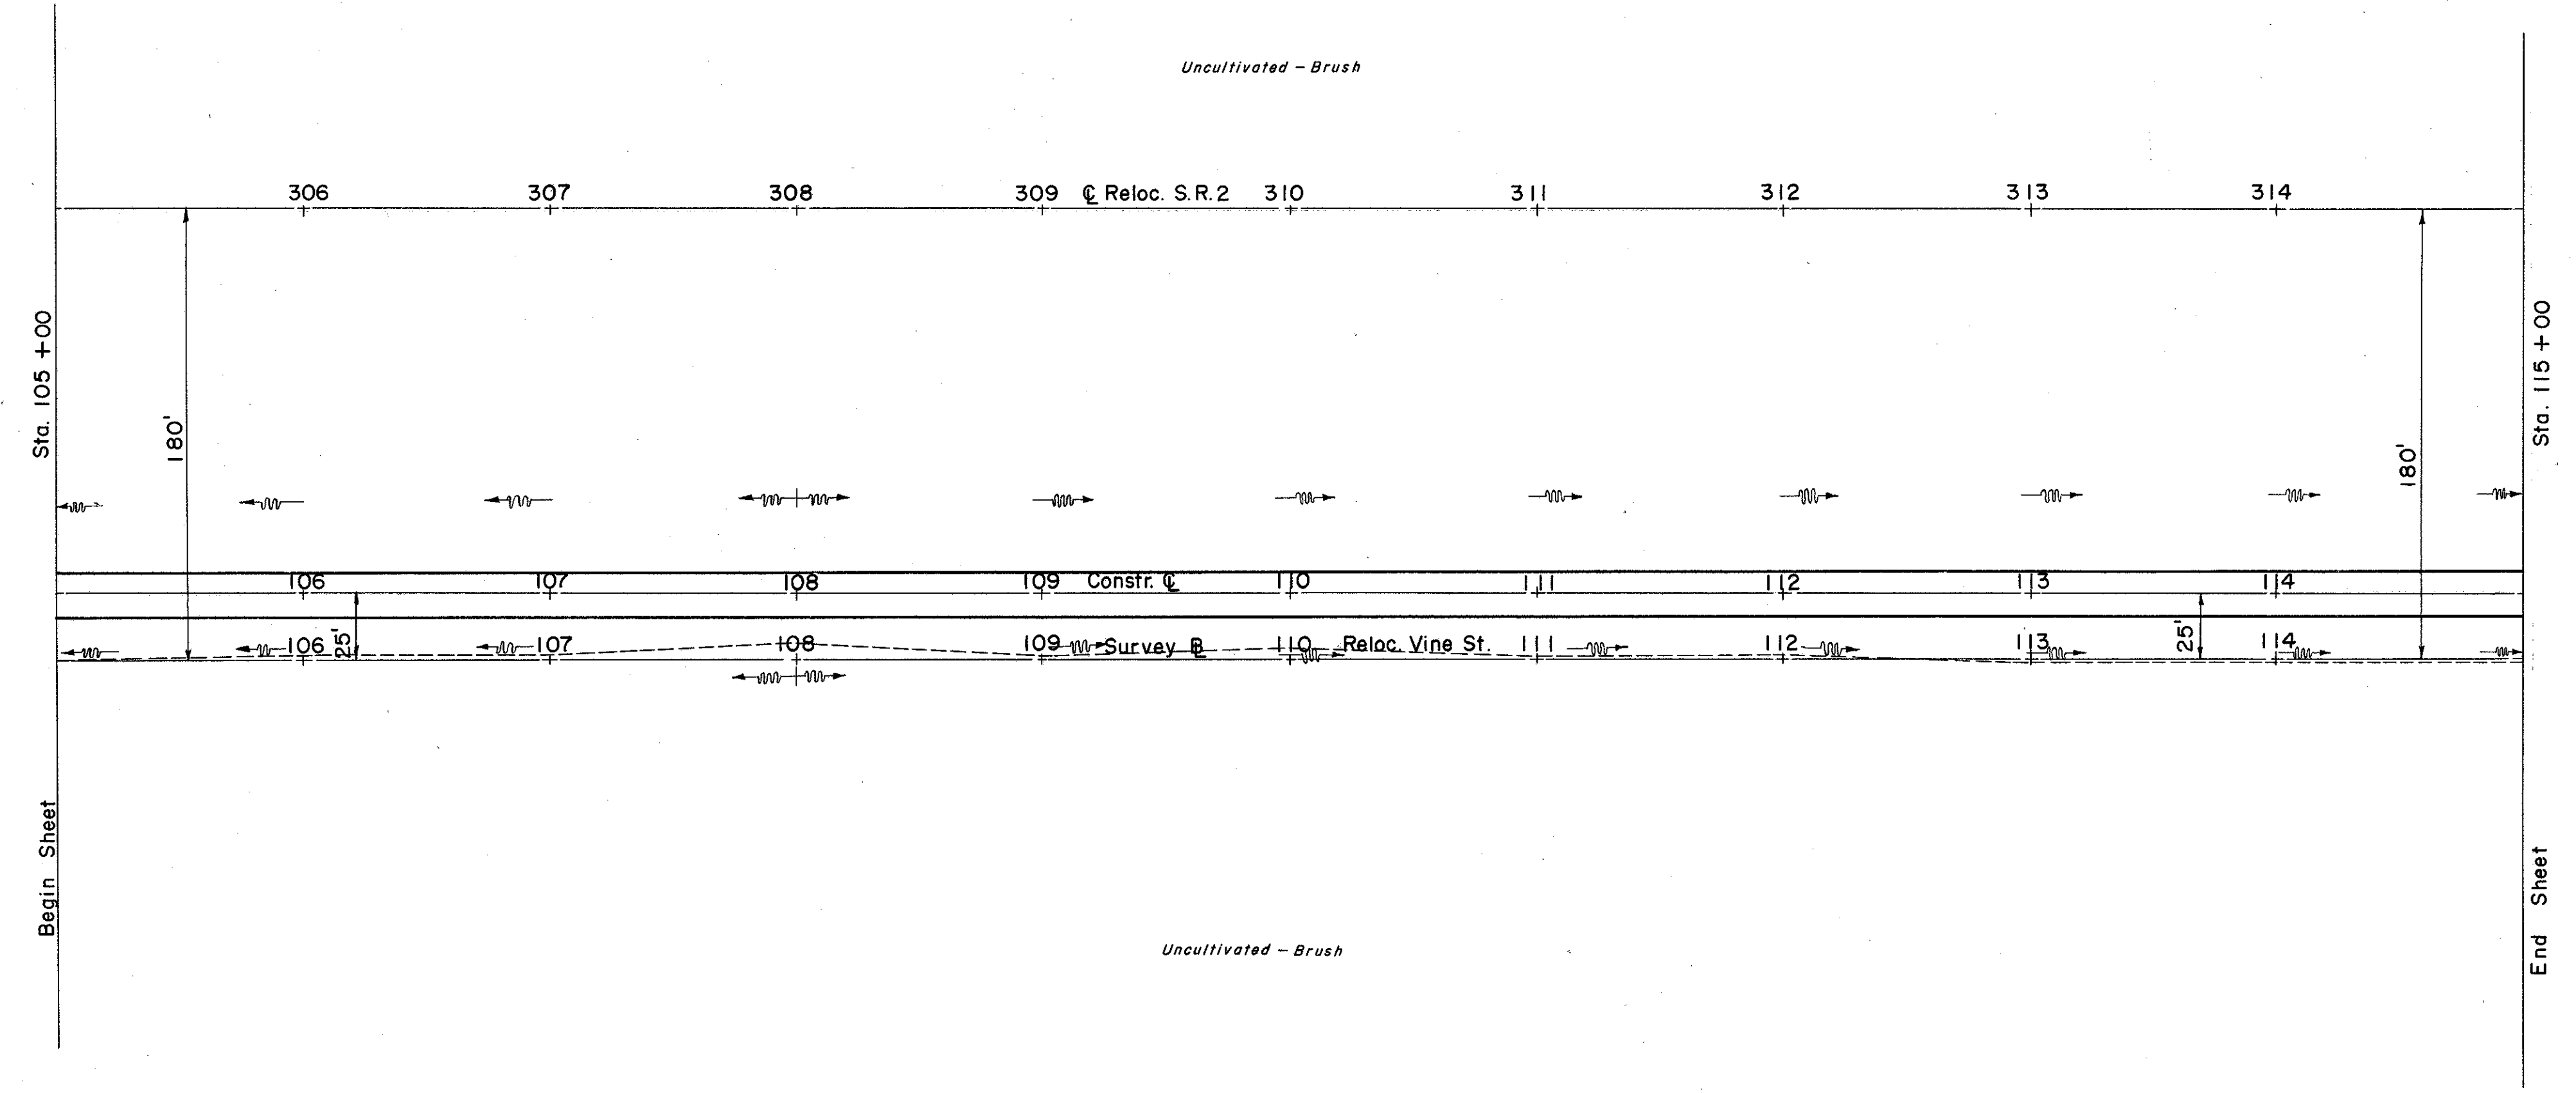


LAKE COUNTY  
LAK-2-7.39

REV. 11-14-58  
This sheet replaces  
Sheet No. 86 of the  
original plans.

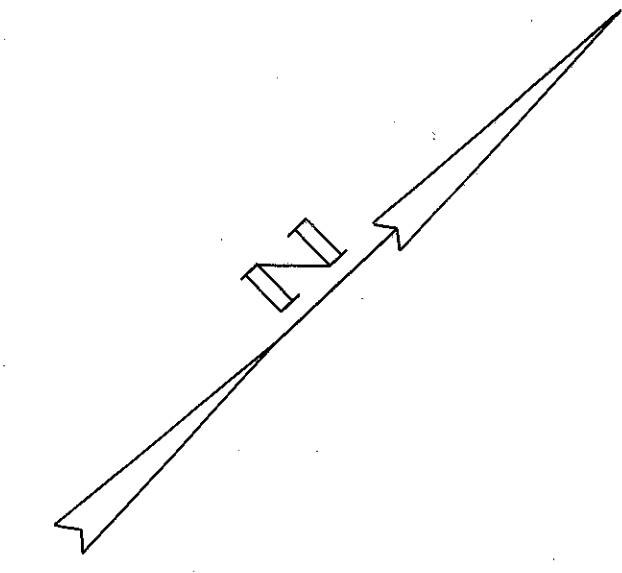

EXCAVATION	=	104	C.Y.
EMBANKMENT	=	1863	C.Y.
EMBANKMENT + 20%	=	2236	C.Y.