
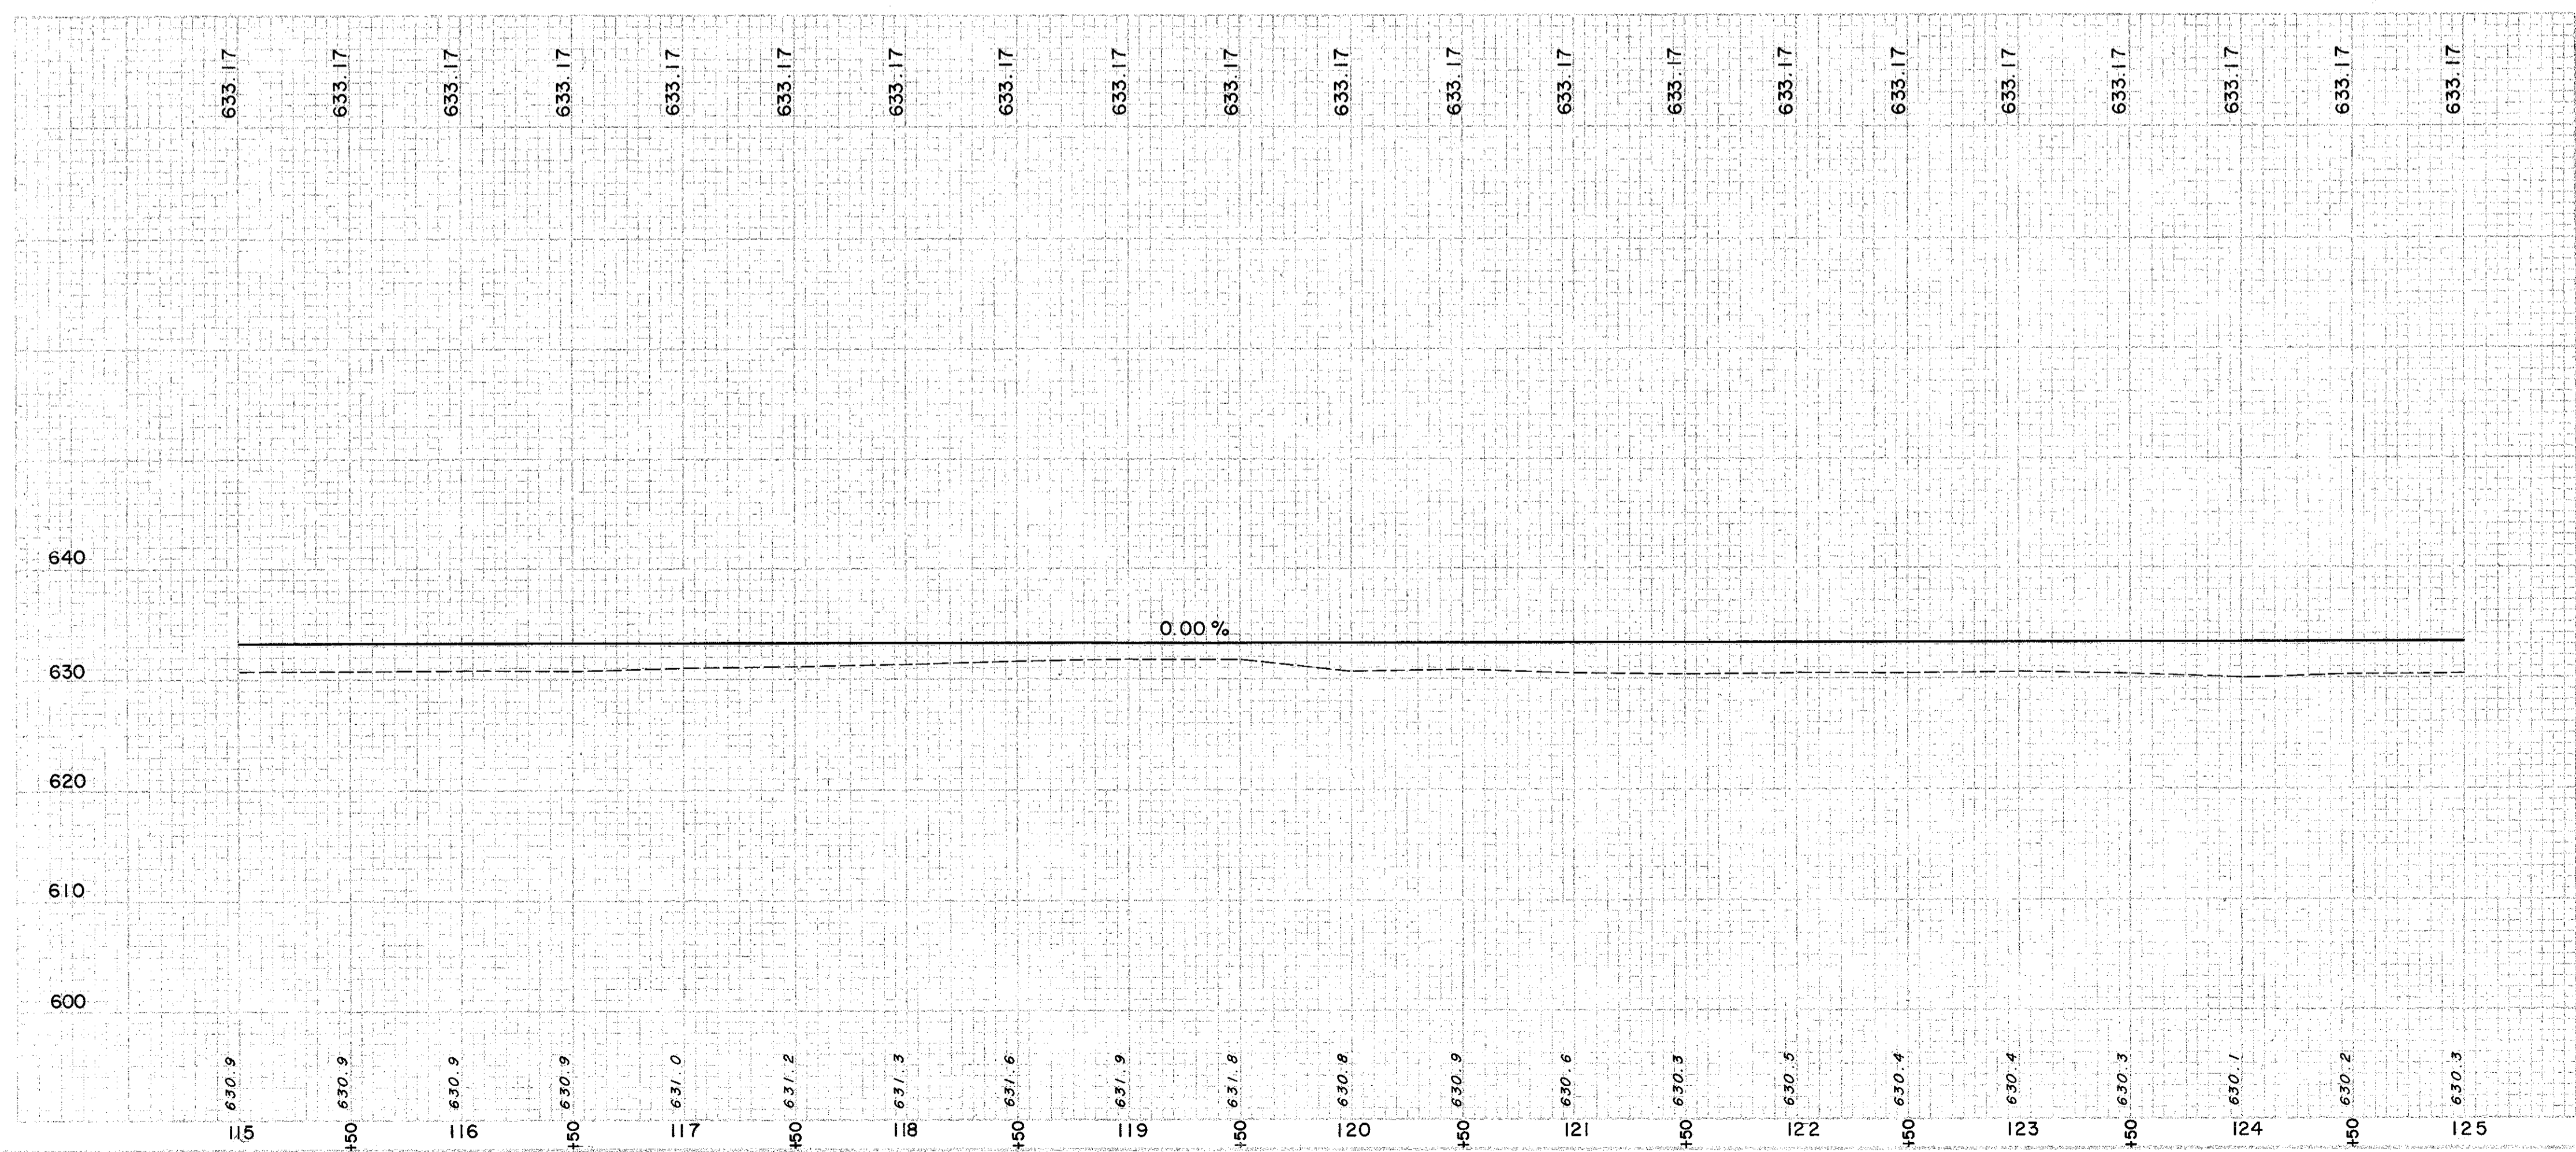
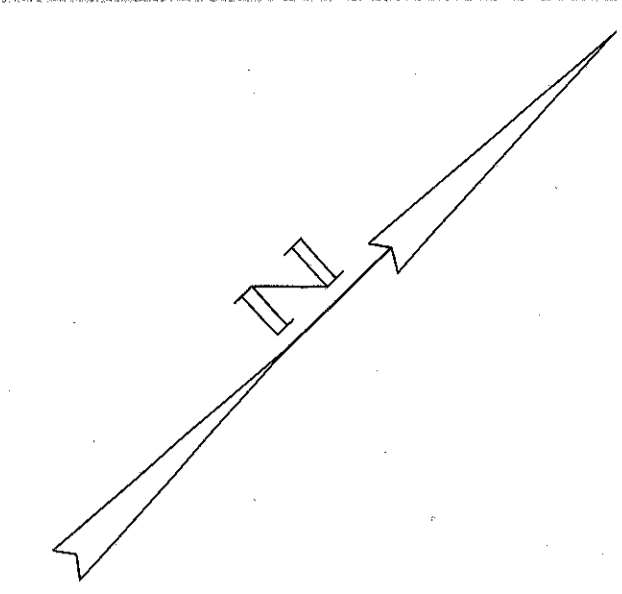


PG. NO.	STATE	PROJECT
2	OHIO	F-329 (16)

87
268

LAKE COUNTY
LAK-2-739

REV. 11-4-58
This sheet replaces
Sheet No. 87 of the
original plans.

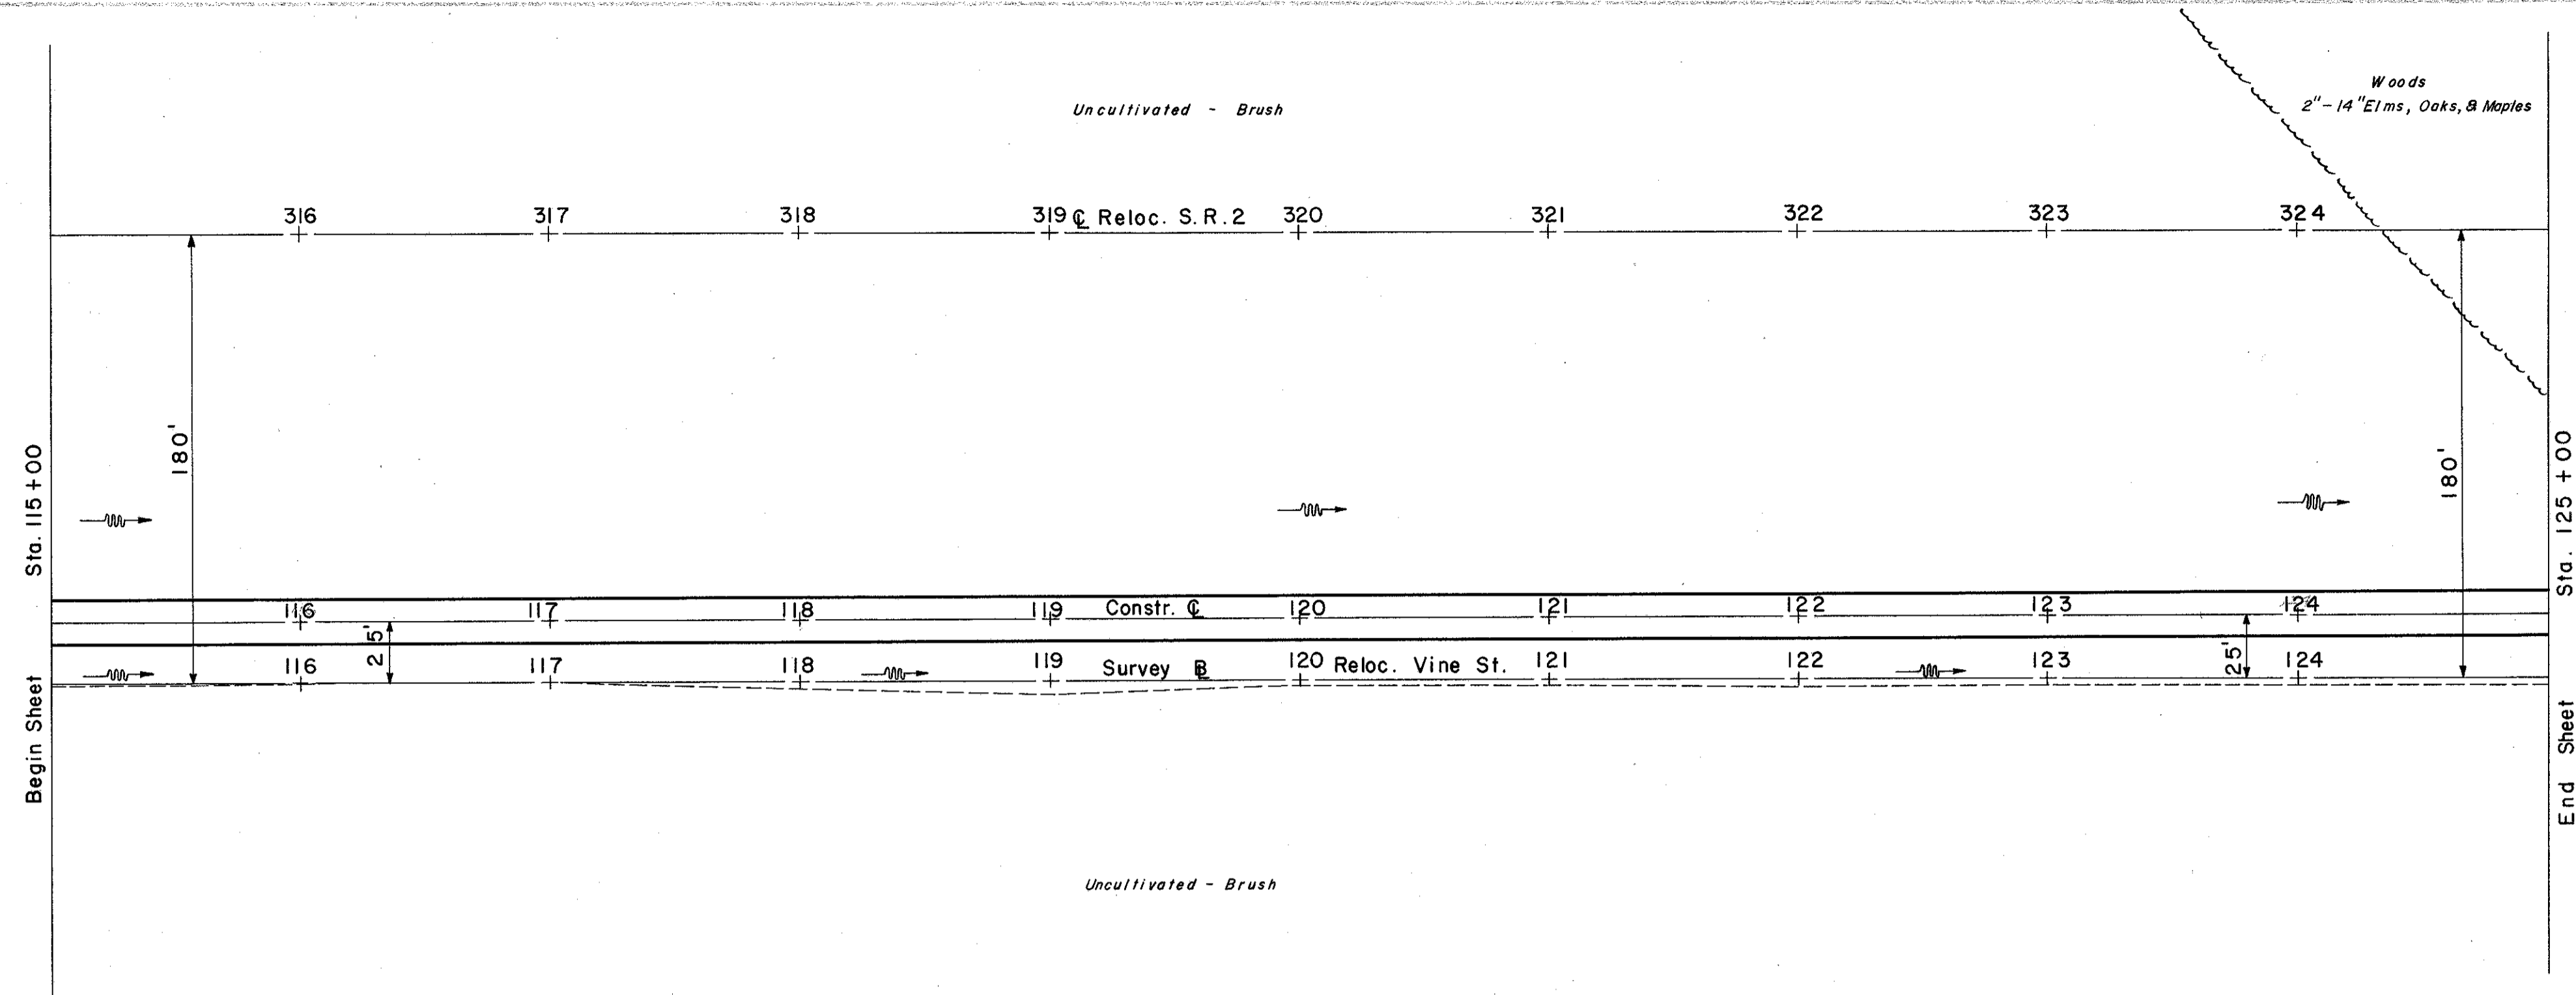

EXCAVATION	=	238 C.Y.
EMBANKMENT	=	2,256 C.Y.
EMBANKMENT @ 20%	=	2,707 C.Y.