




LAKE COUNTY
LAK-2-7.39

REV. 11-14-58
This sheet replaces
Sheet No. 88 of the
original plans.

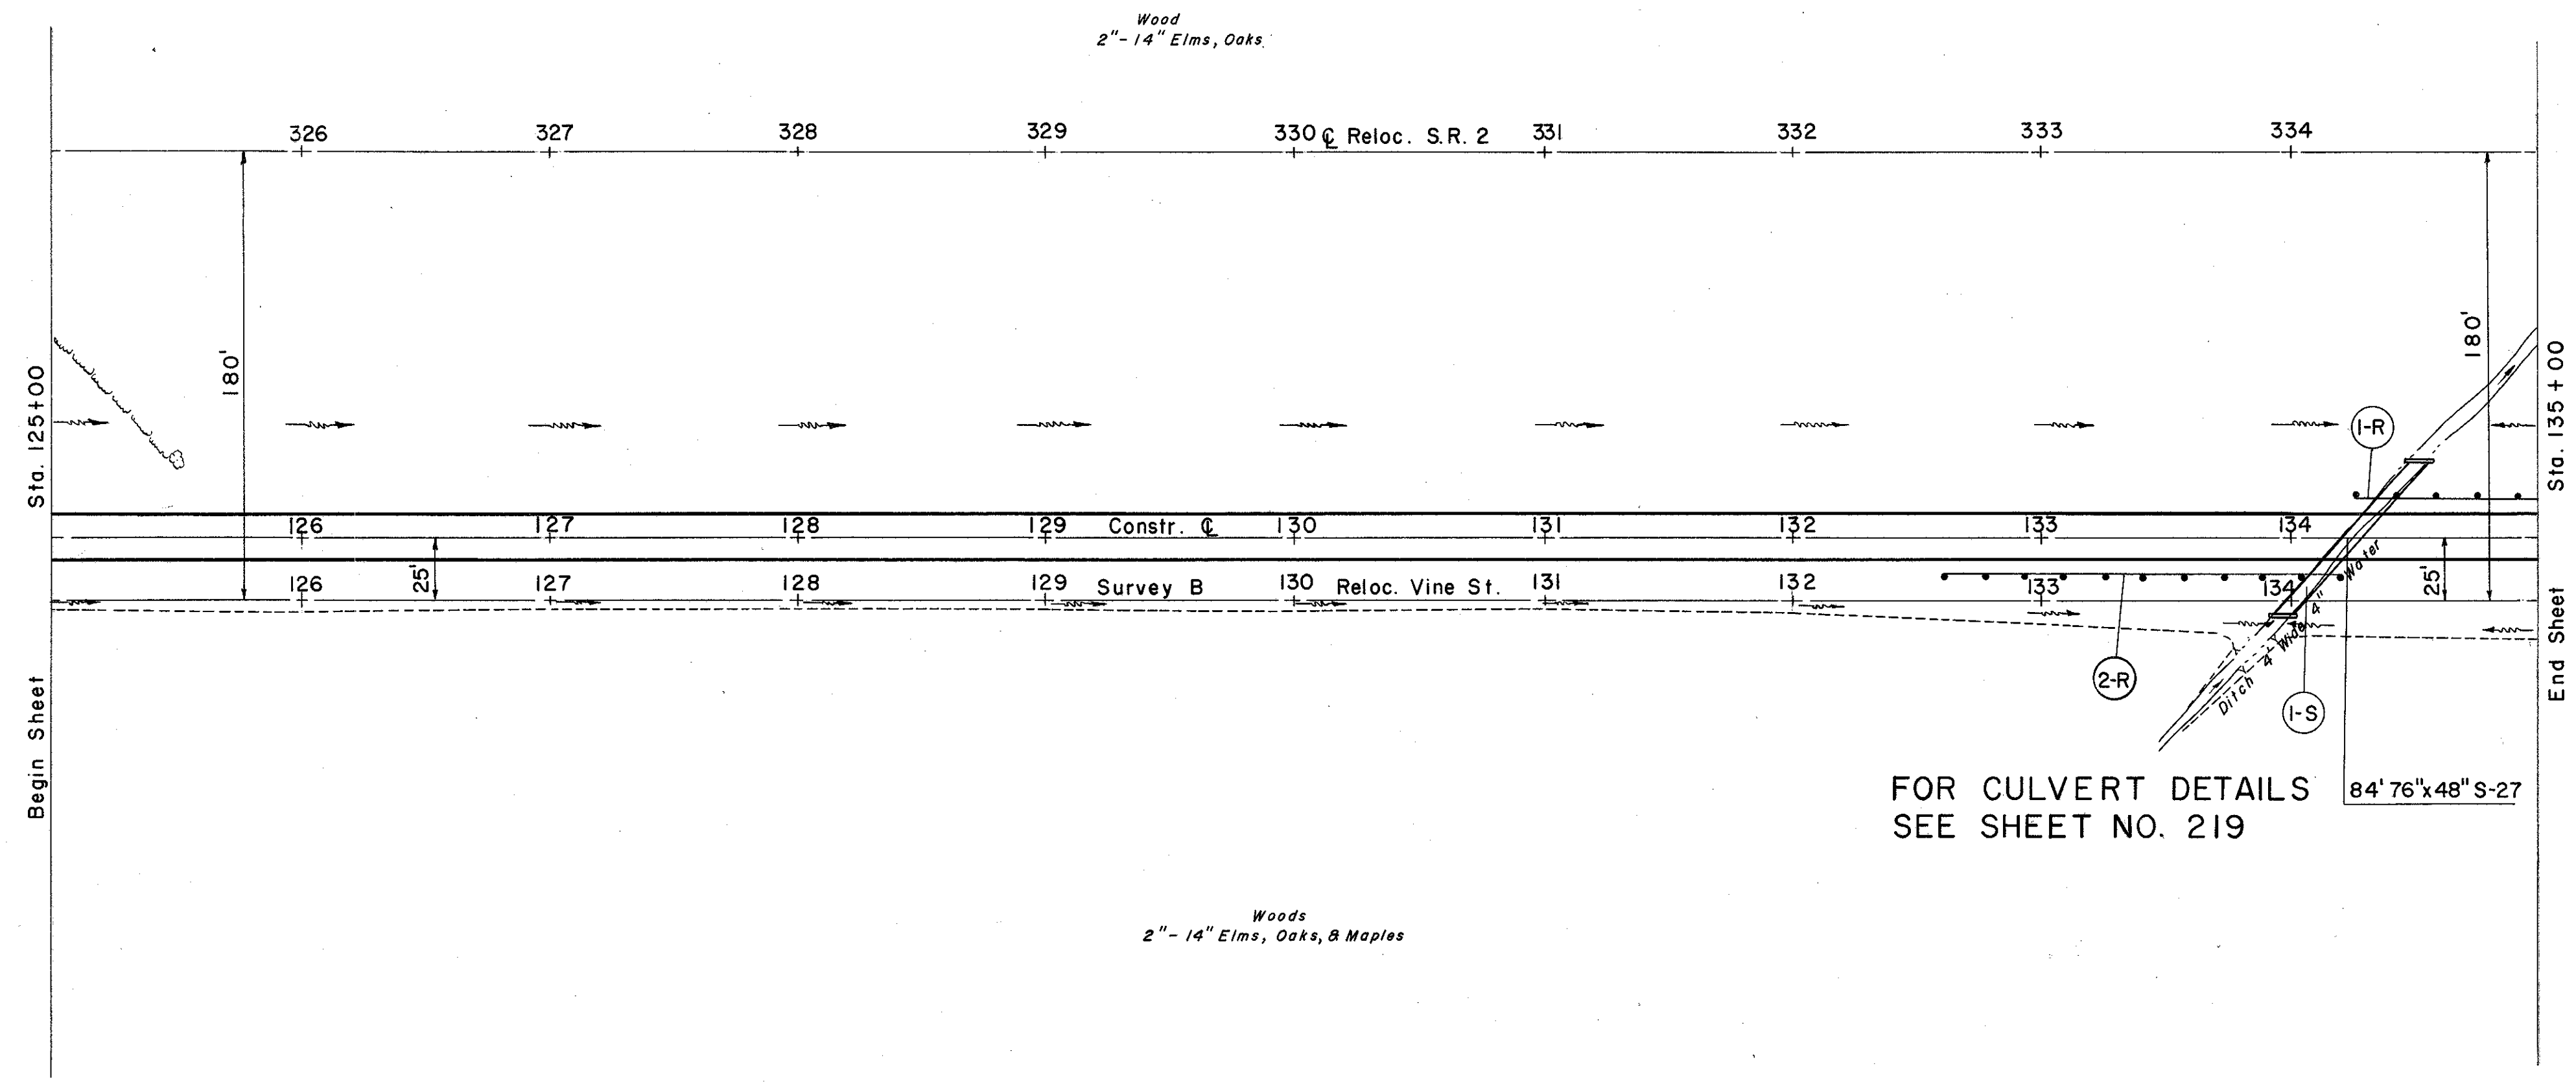

FOR CULVERT DETAILS
SEE SHEET NO. 219

84' 76"x48" S-27

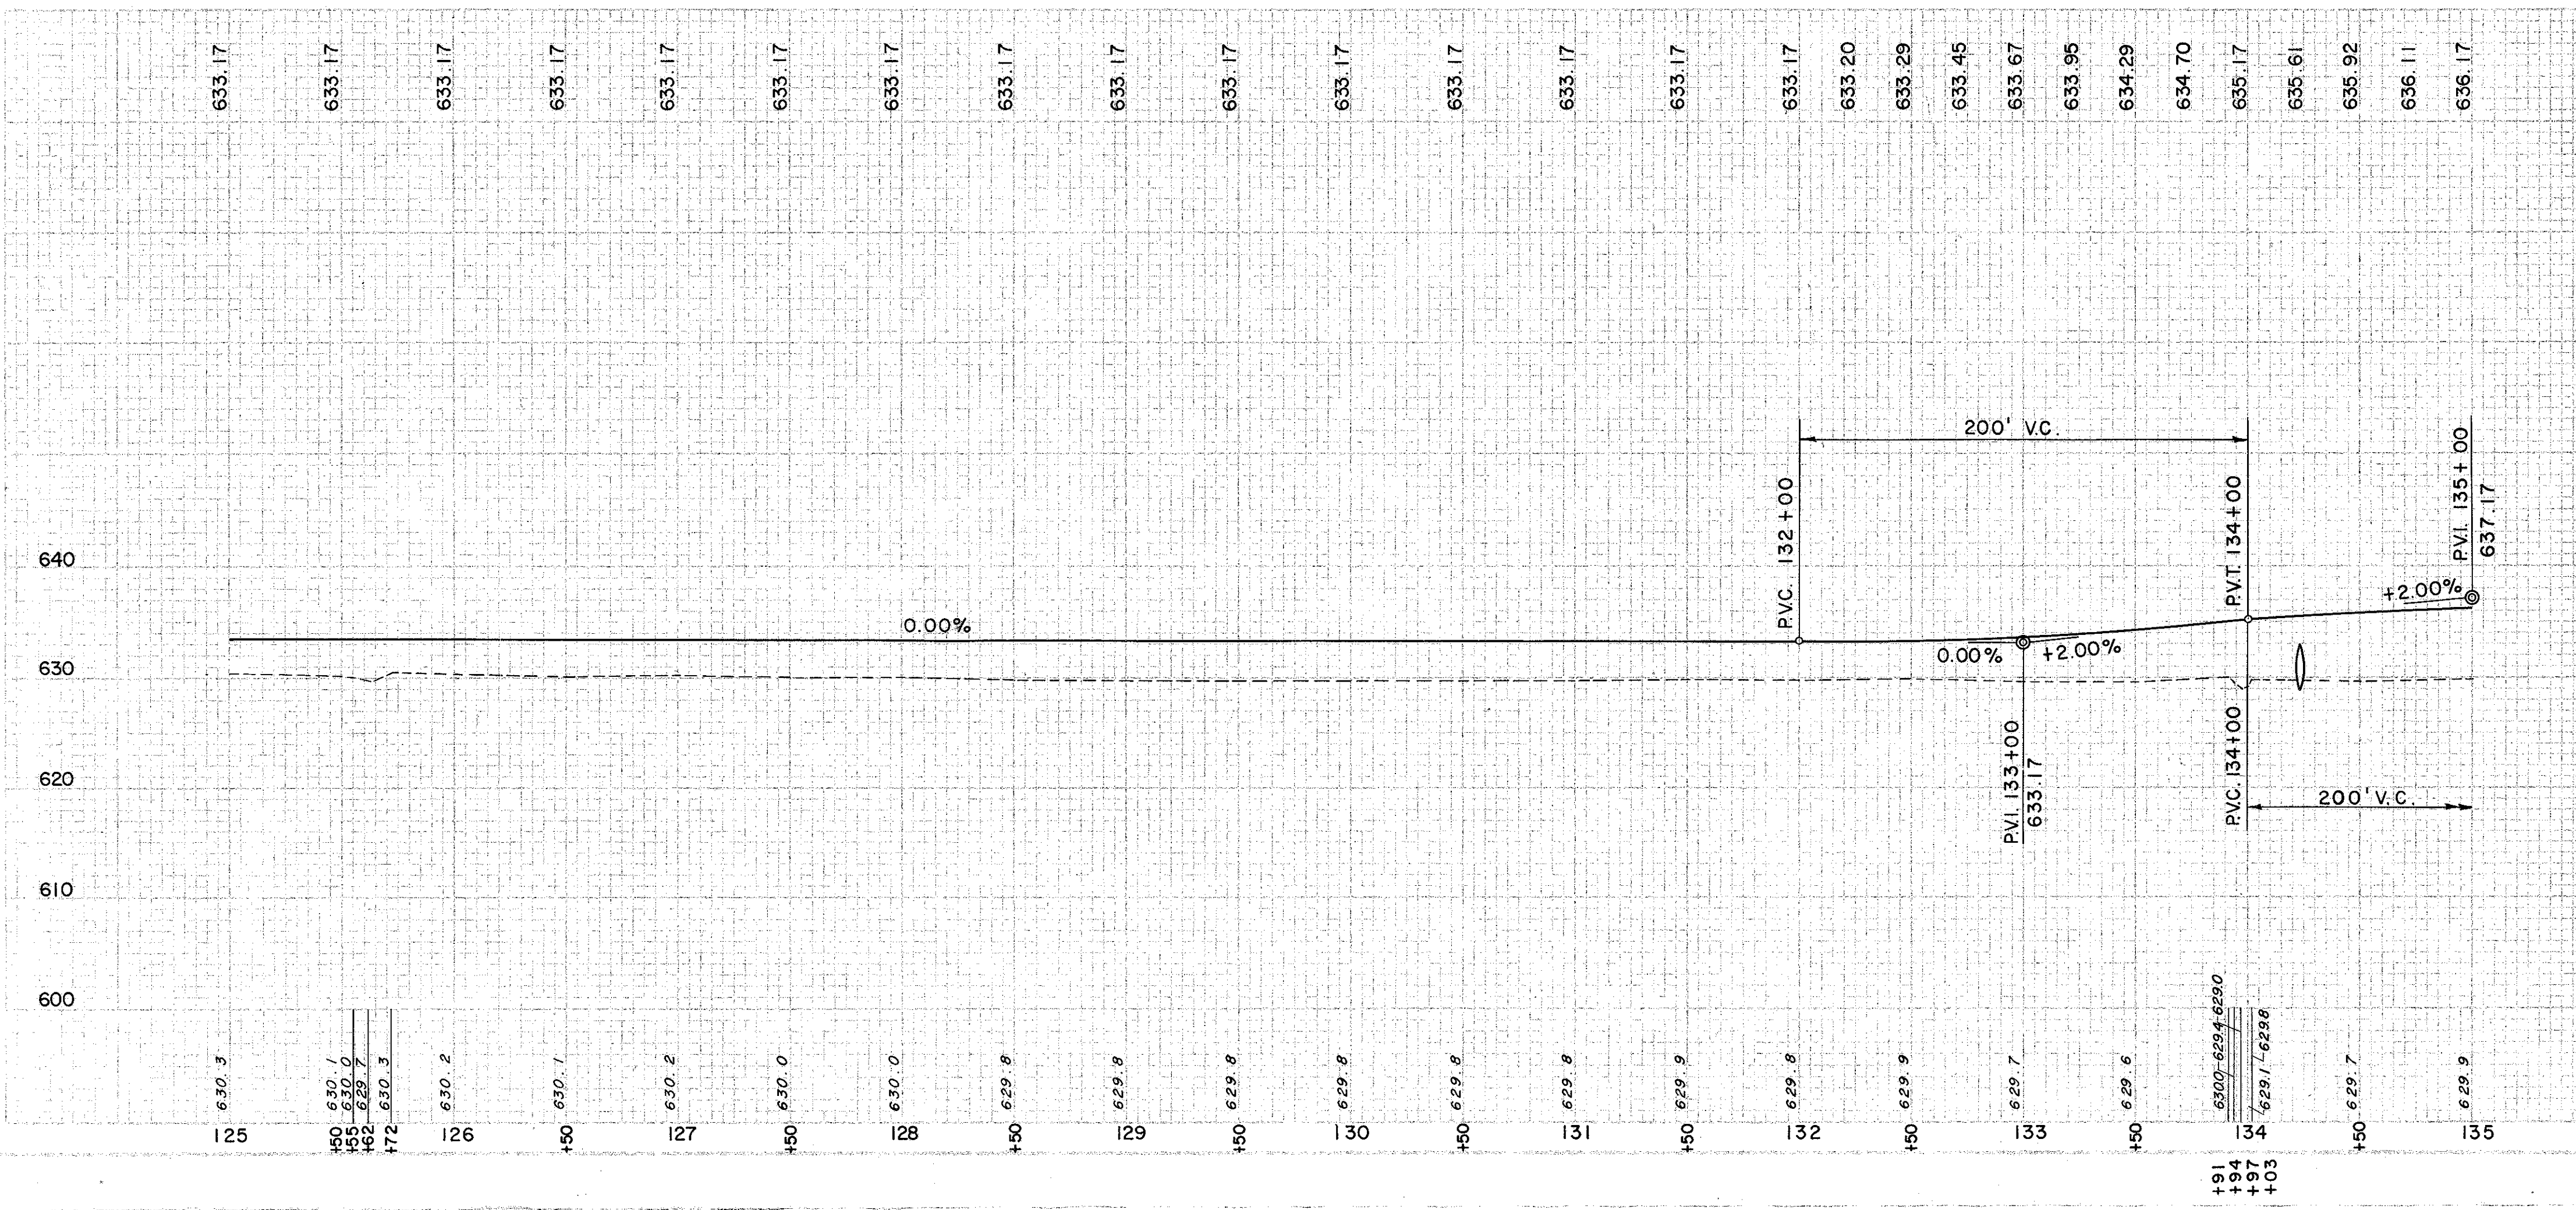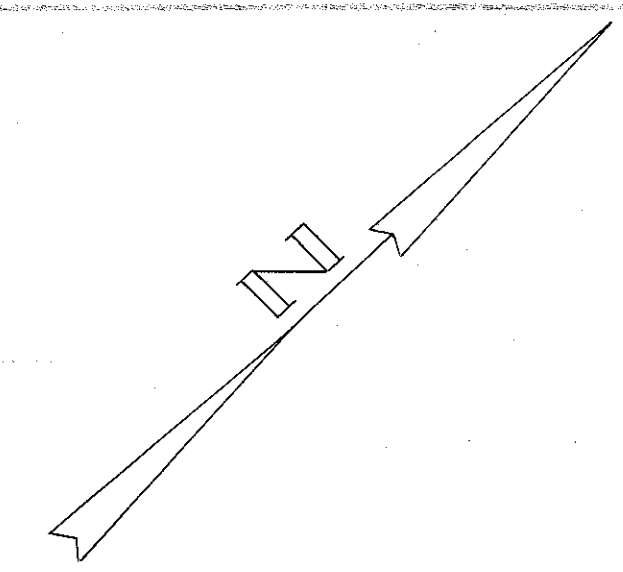

STRUCTURE

REF. STATION NO.	FROM	TO	DESCRIPTION	C.Y.	L.F.
I-S 134+23			E-2 EXCAV. FOR STRUCT. C.Y.	34	
			E-3 CHANNEL EXCAV. C.Y.	5	
			S-1 CONC. FOR STRUCT. CL. "E" C.Y.	4.75	
			S-27 76" x 48" PIPE FOR ROADWAY CULVERT (M-2066B)		84

ROADWAY

REF. STATION NO.	FROM	TO	DESCRIPTION	L.F.	RT.
I-R 134+25		135+85	I-15 GUARD RAIL STEEL BEAM TYPE (DEEP)	160	
			NO. 2-A L.F.		176
2-R 132+63		134+39	TOTAL		336

EXCAVATION	=	124 C.Y.
EMBANKMENT	=	5115 C.Y.
EMBANKMENT 20	=	6138 C.Y.

Rev. 11-14-58