



LAKE COUNTY
LAK-2-7.39

REV. 11-14-58
This sheet replaces
Sheet No. 89 of the
original plans.

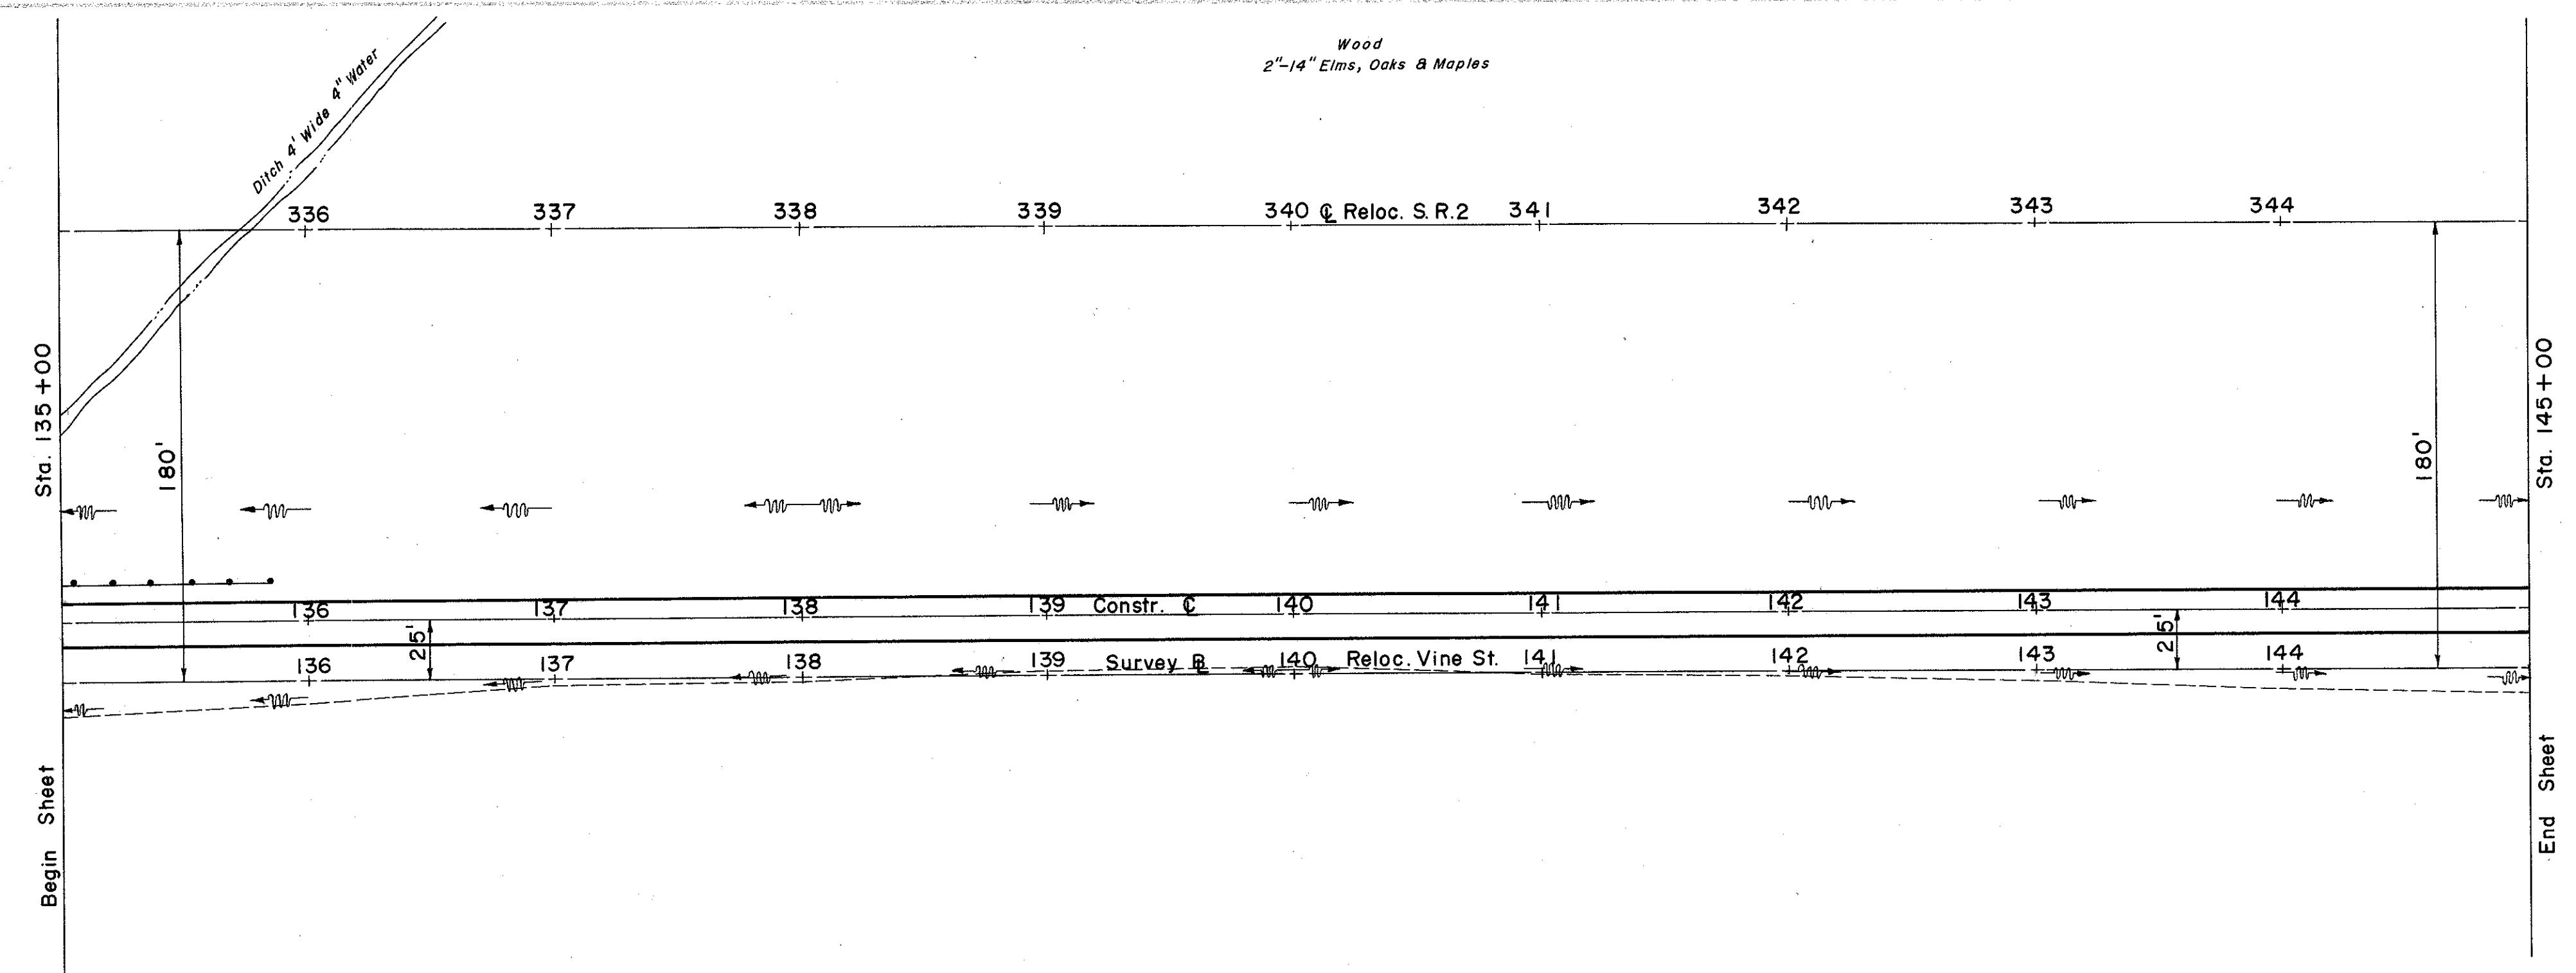

FOR GUARD RAIL QUANTITIES
SEE SHEET NO. 88

Woods
2"-14" Elms, Oaks & Maples

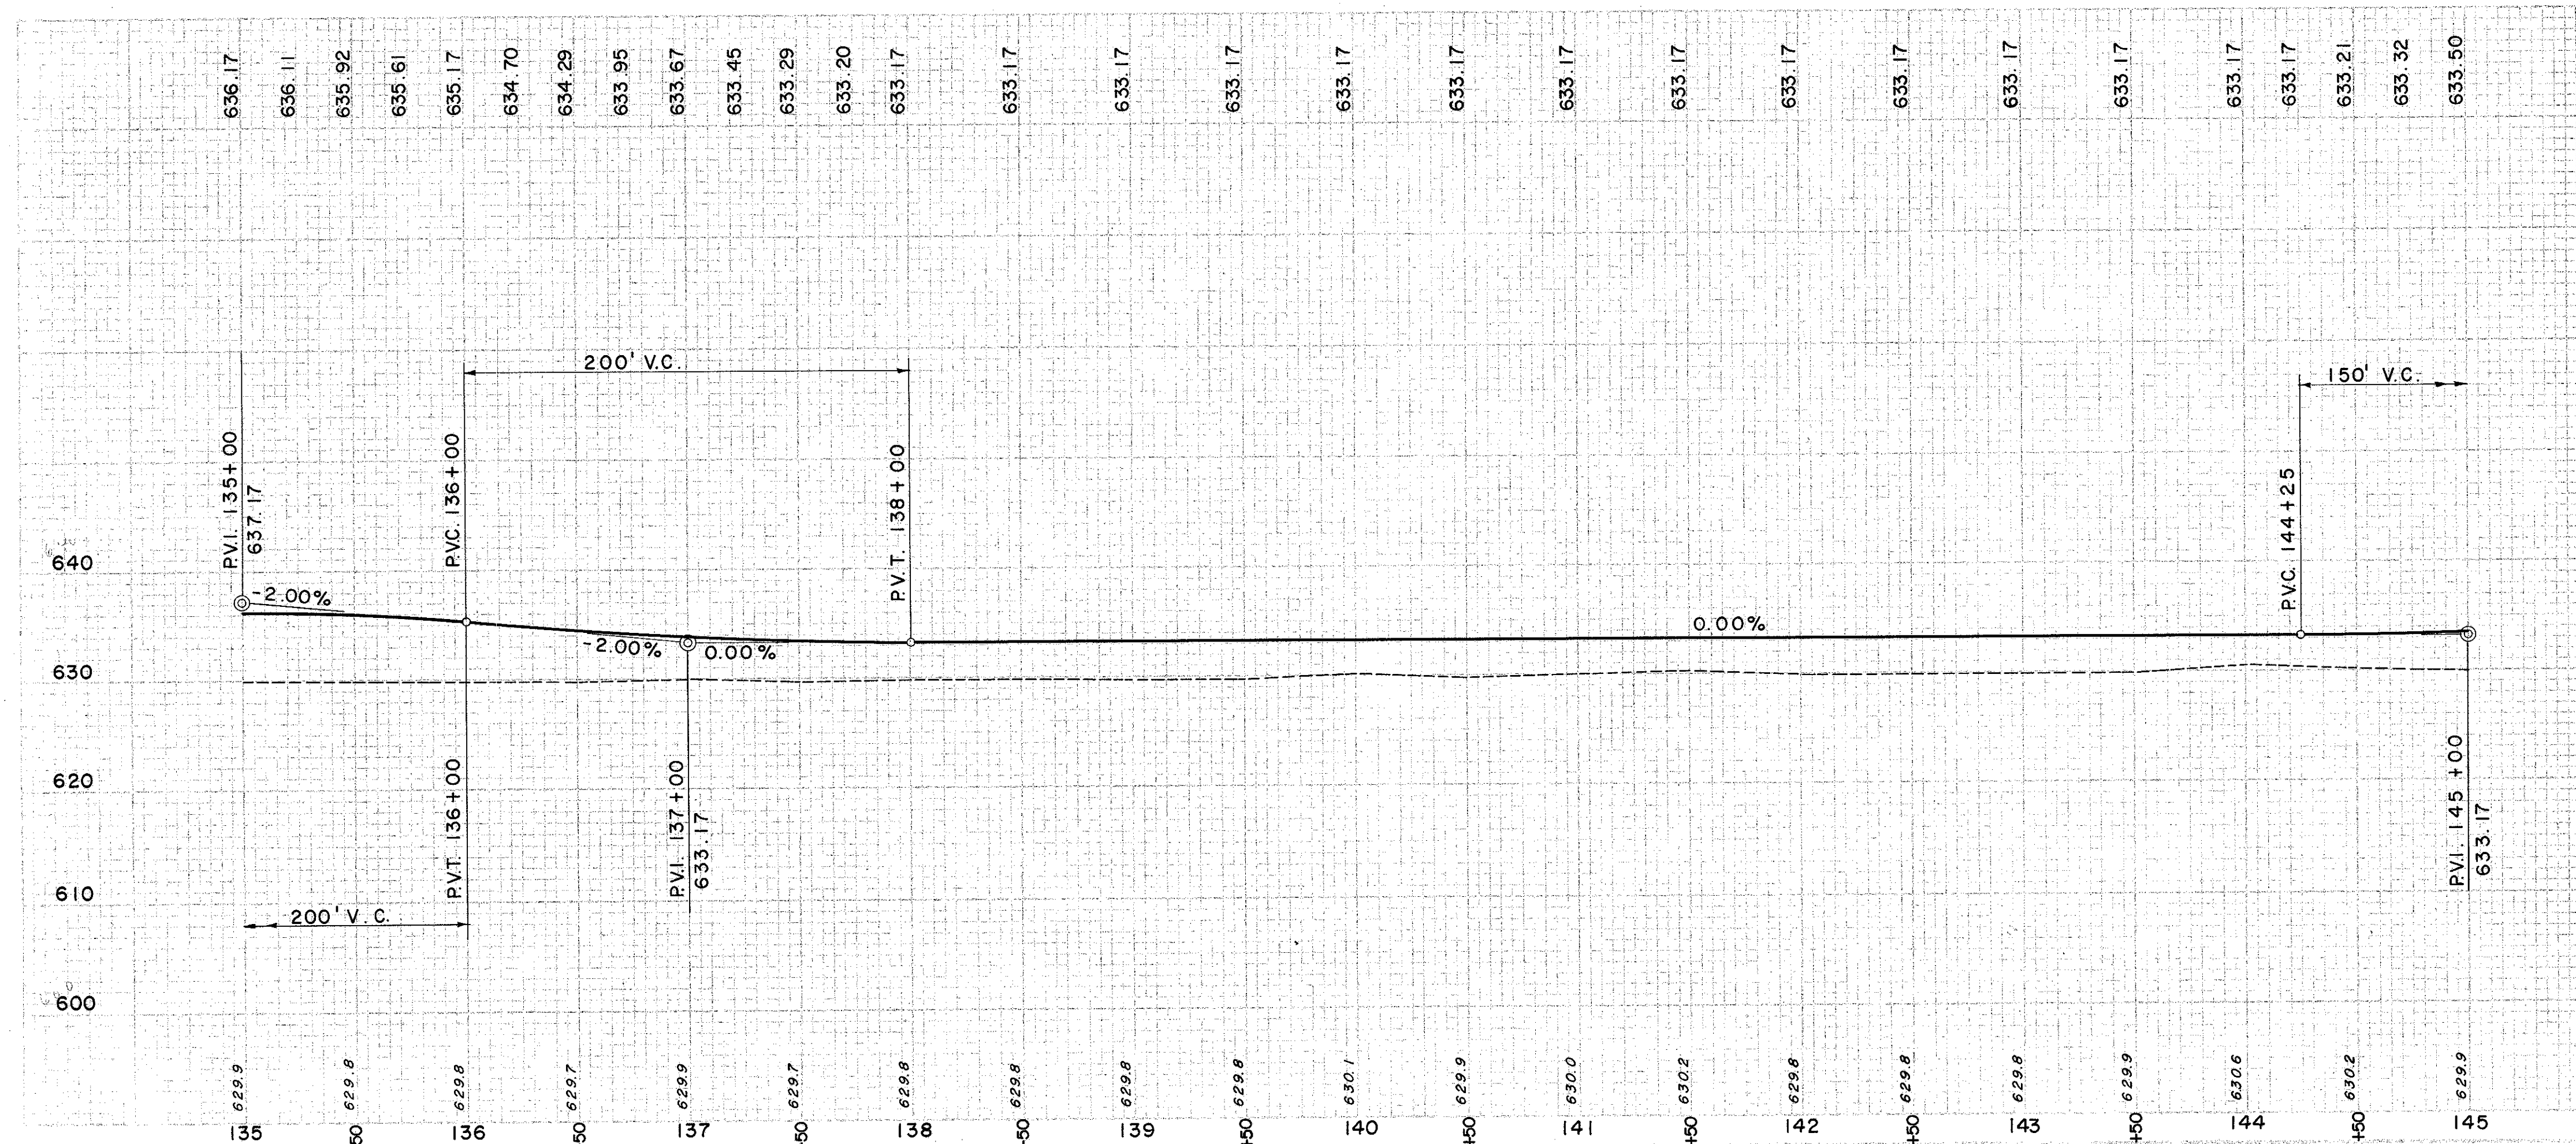

EXCAVATION	=	170 C.Y.
EMBANKMENT	=	4193 C.Y.
EMBANKMENT 20'	=	5032 C.Y.