


SEEDING
END SQ.
WIDTH YDS.

E-18

REV. NO.	DATE	BY
2	CHD	F-329 (16)

92
268

LAKE COUNTY
LAK 2-739
REV. 11-14-58
120 140
This sheet replaces
Sheet No. 92 of the
original plans.

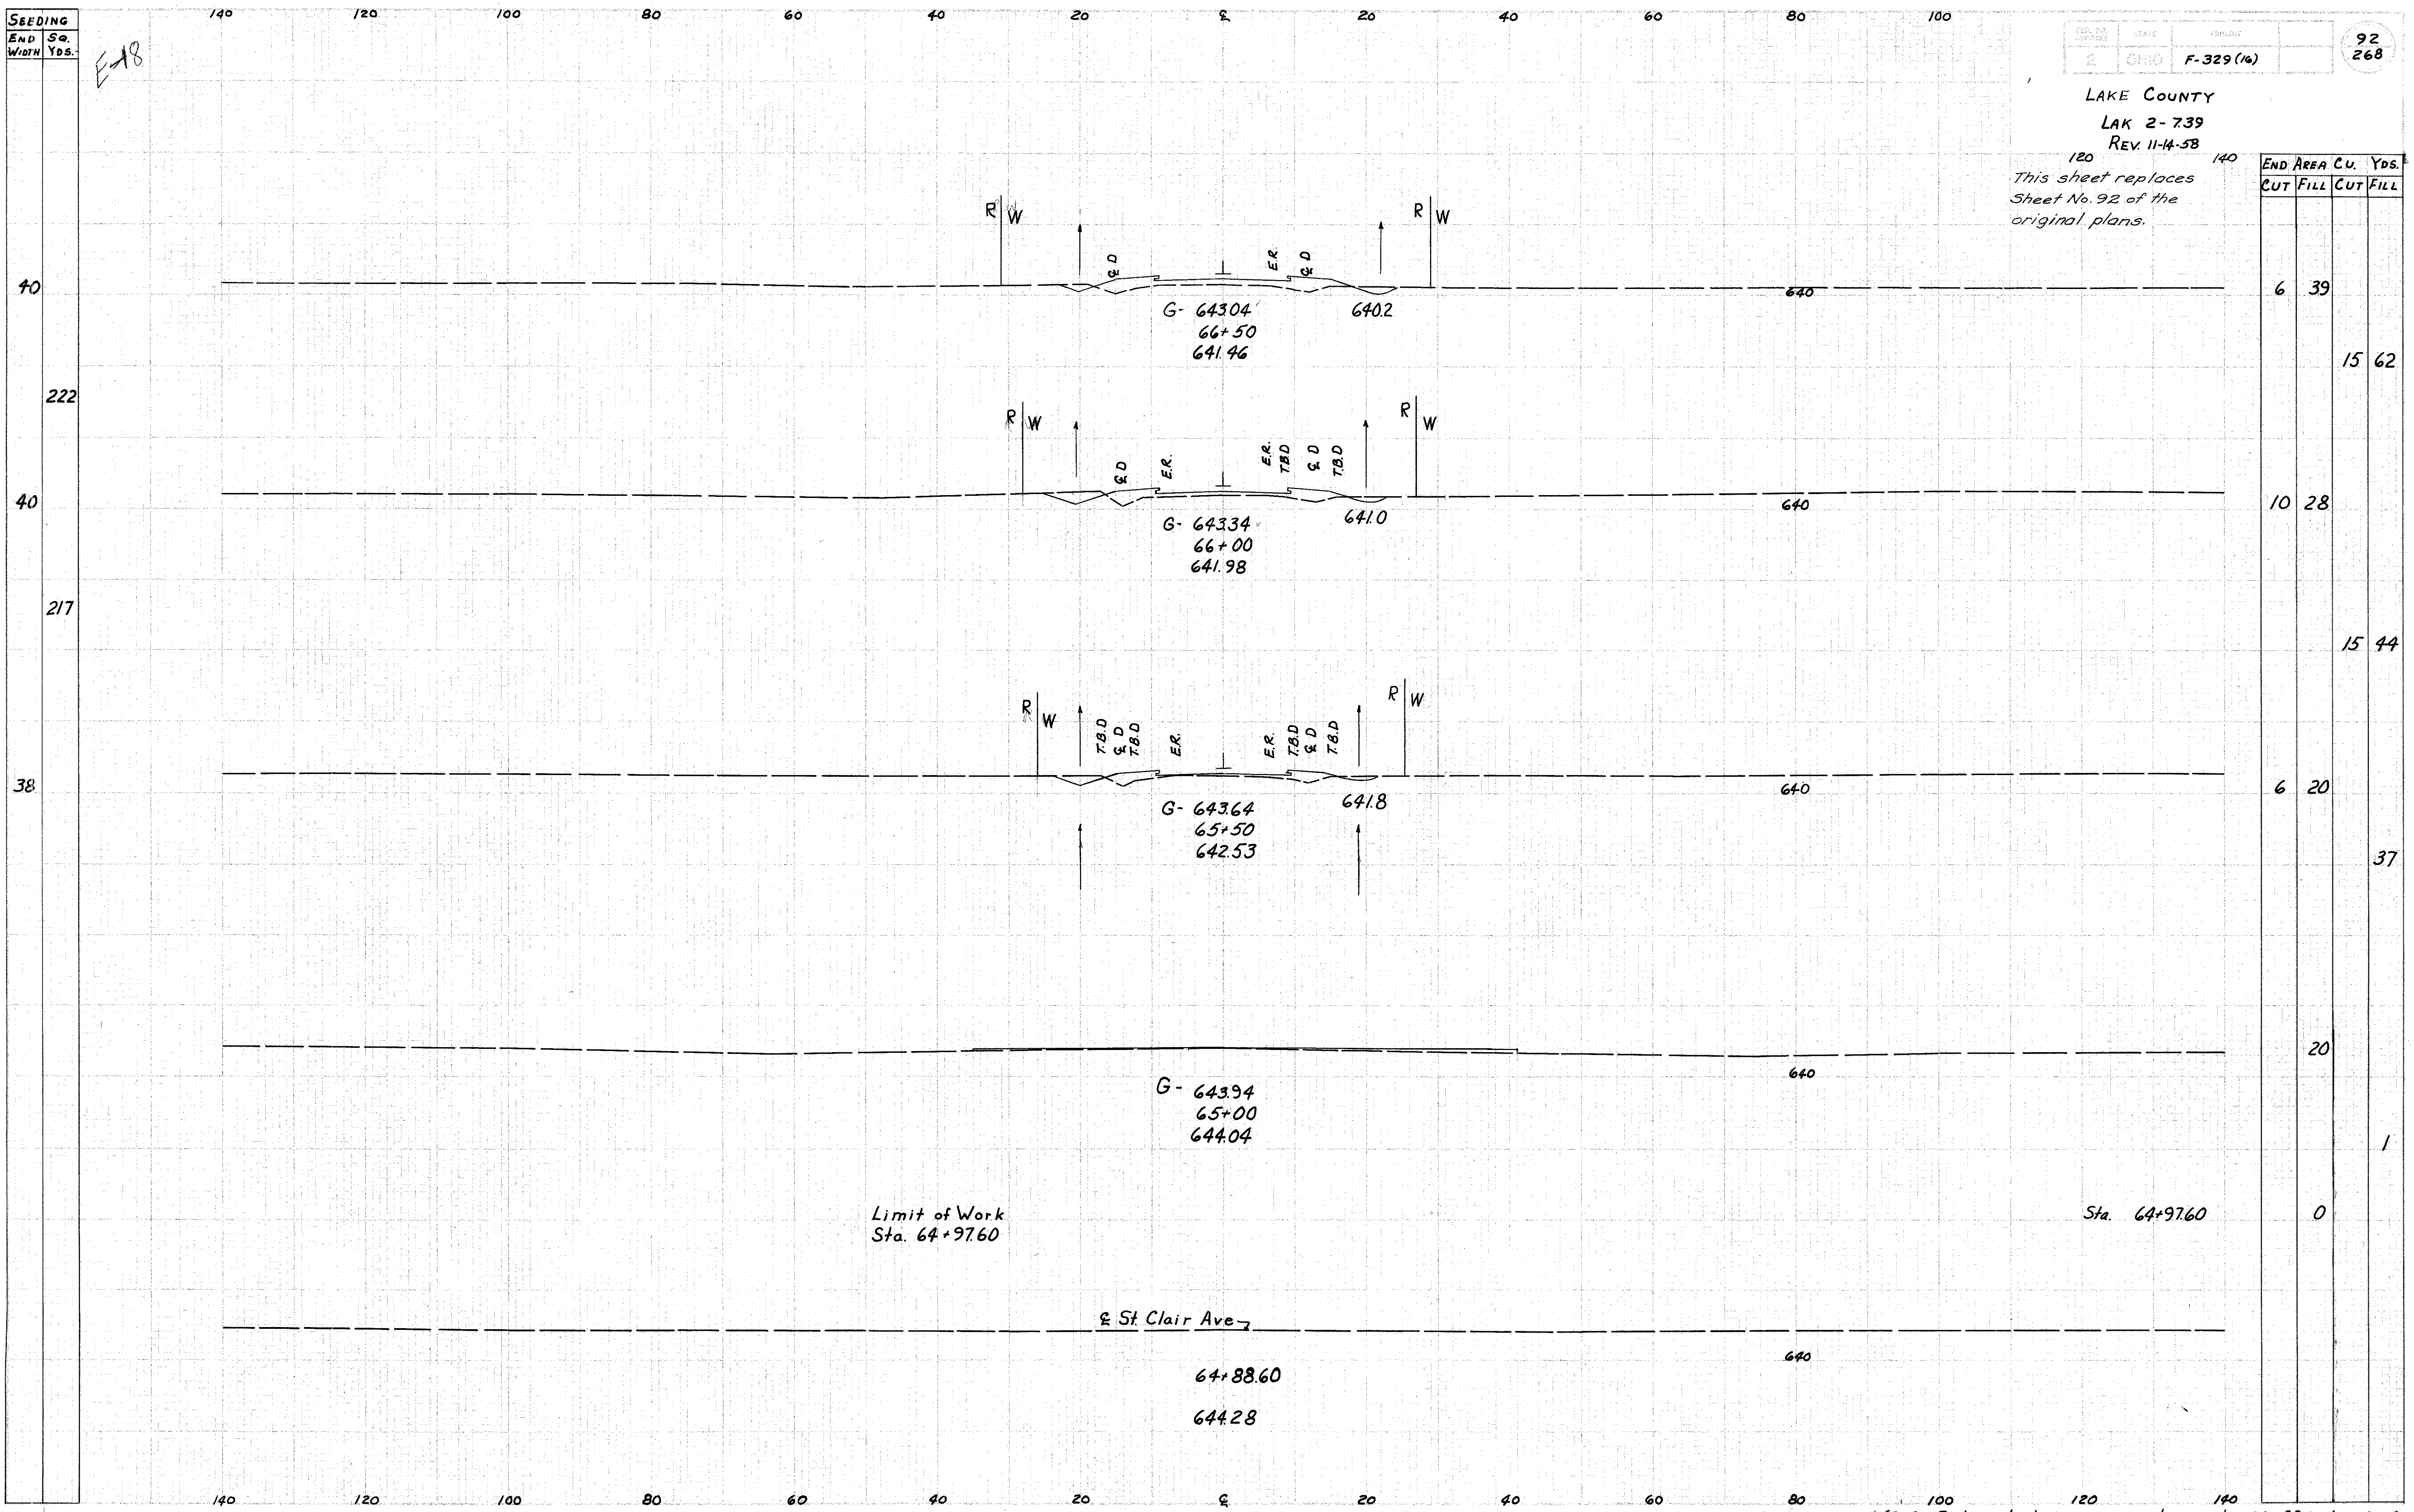

END	AREA	C.U.	YDS.
CUT	FILL	CUT	FILL
6	39		
		15	62
10	28		
		15	44
6	20		
		37	
	20		
			1
	0		

Limit of Work
Sta. 64+97.60

Sta. 64+97.60

E St. Clair Ave

64+88.60
644.28