


SEEDING
END SQ.
WIDTH Yds.

LAKE COUNTY
LAK-2-739
REV 11-14-58

This sheet replaces
Sheet No. 93 of the
original plans

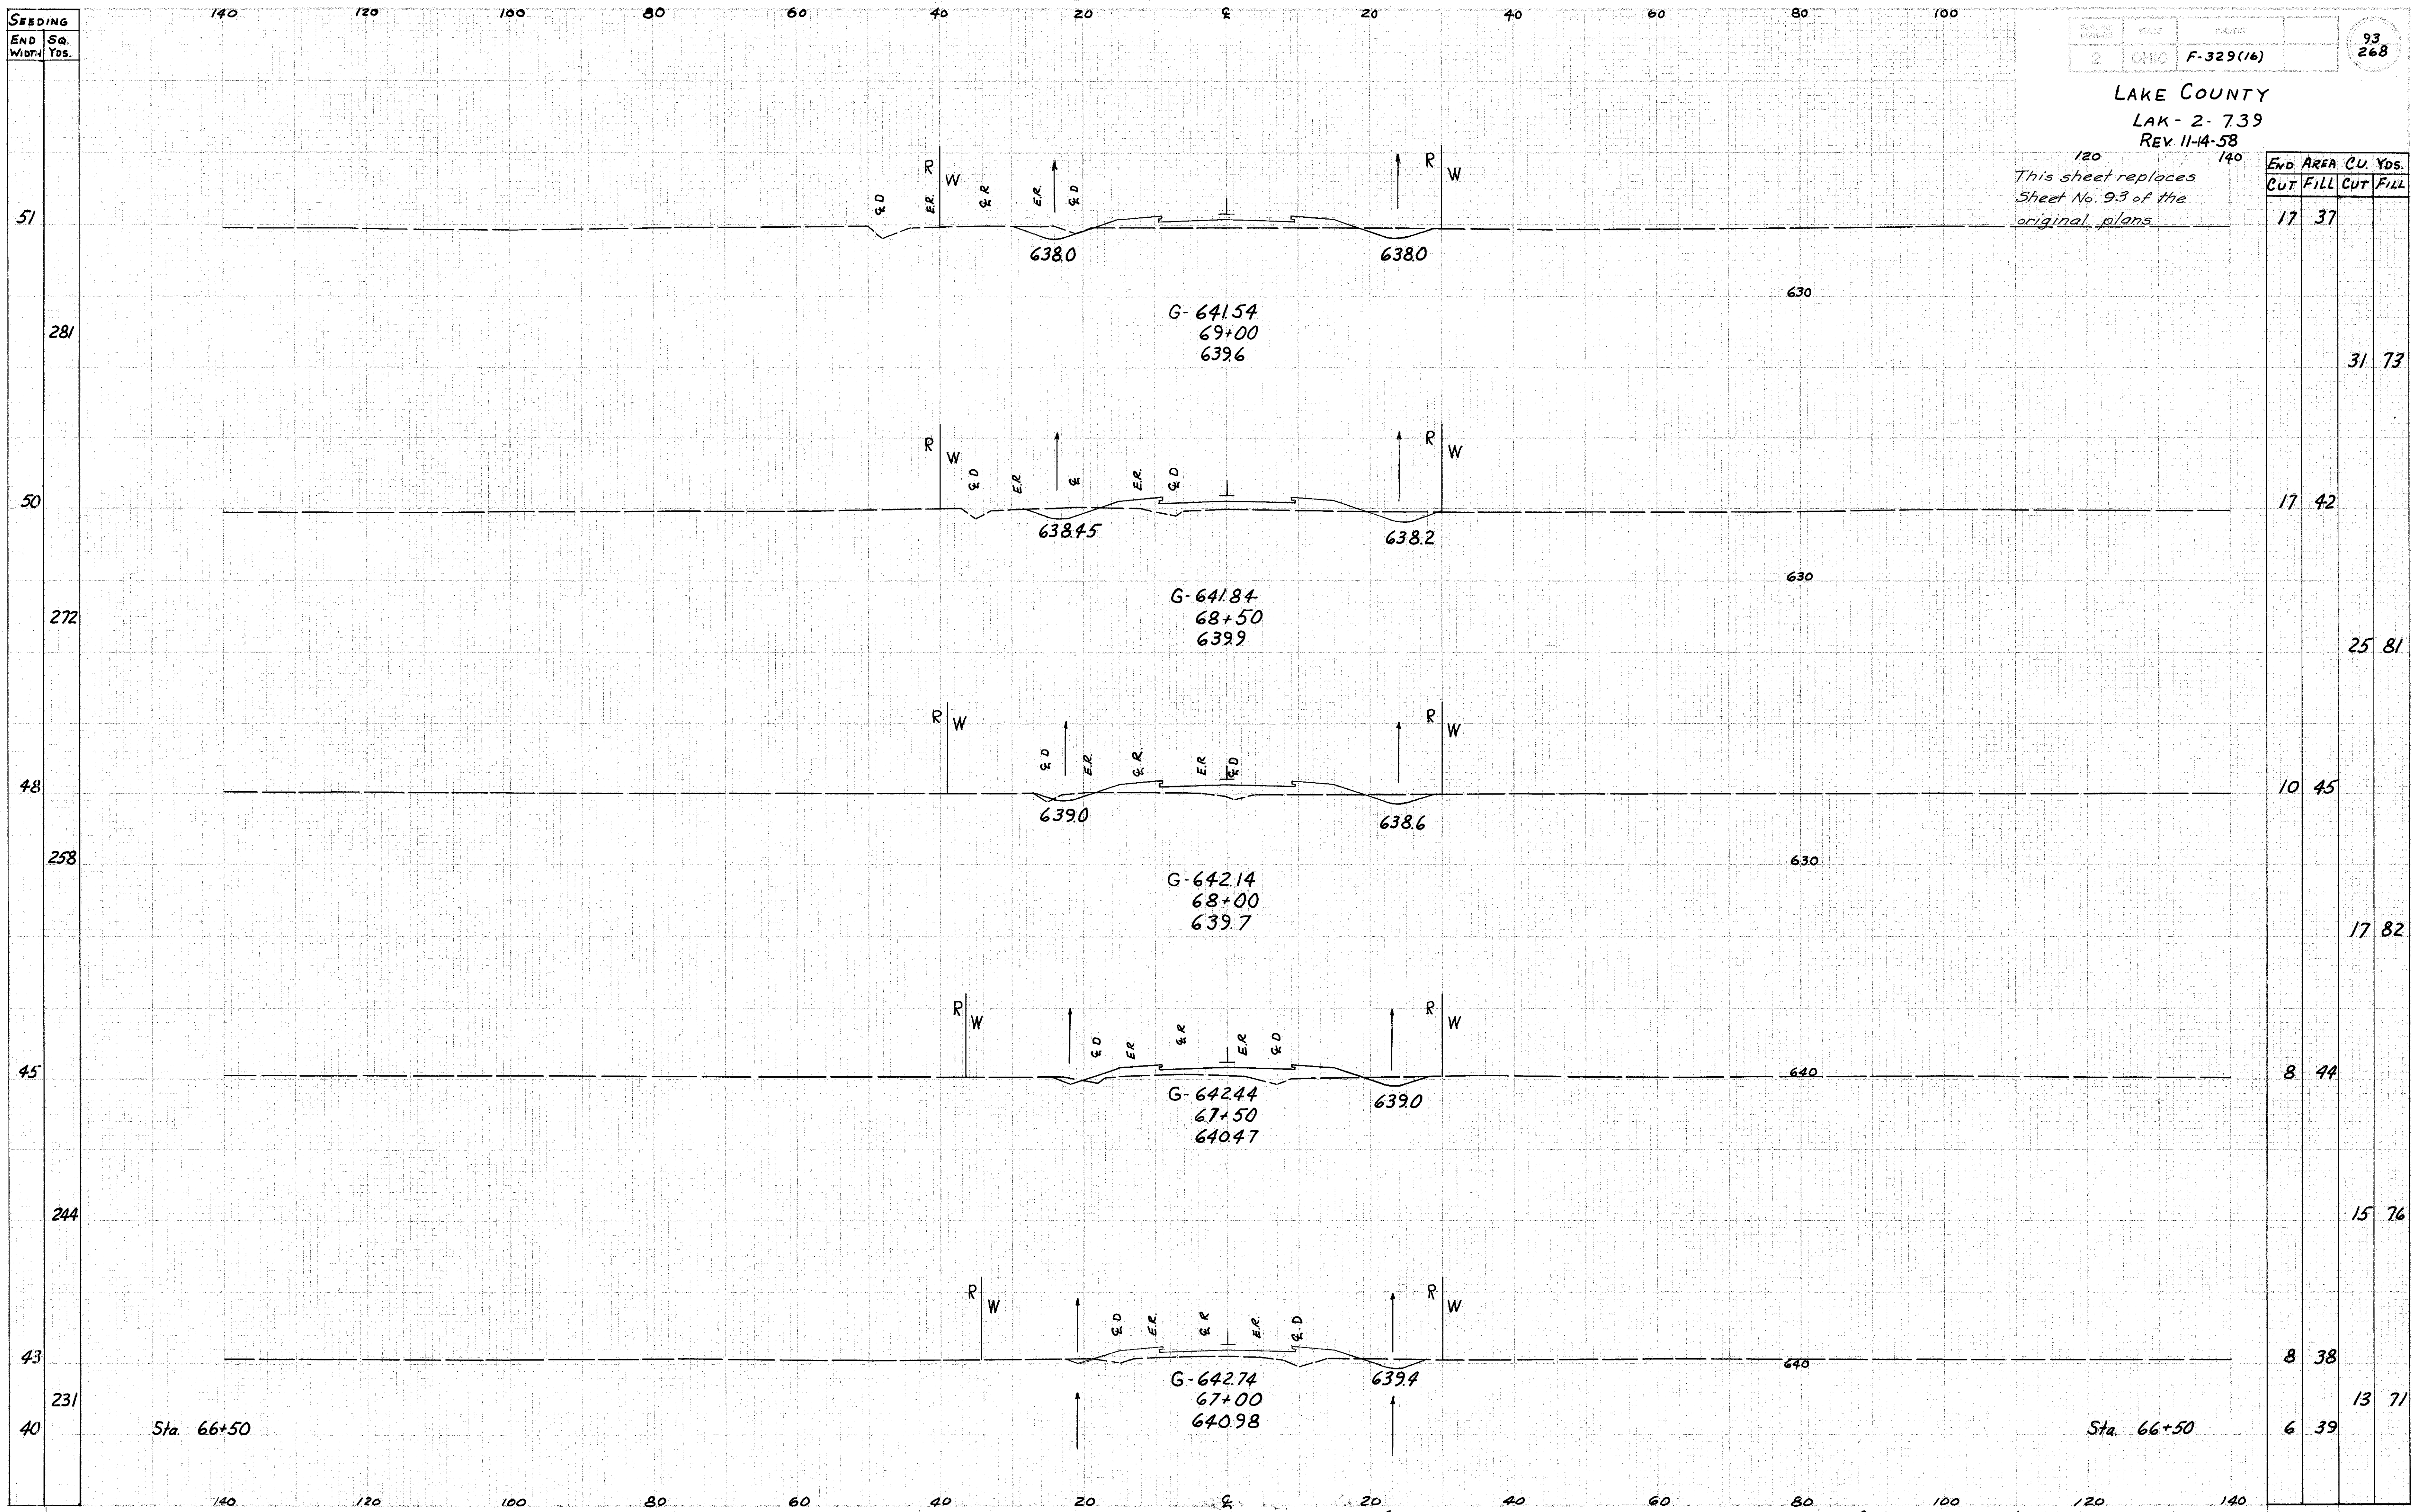

END STA.	AREA		CU. YDS.	
	CUT	FILL	CUT	FILL
51	17	37		
281			31	73
50	17	42		
272			25	81
48	10	45		
258			17	82
45	8	44		
244			15	76
43	8	38		
231			13	71
40	6	39		