


SEEDING  
END SQ.  
WIDTH YDS.

LAKE COUNTY  
LAK-2-739  
REV. 114-58  
120 140

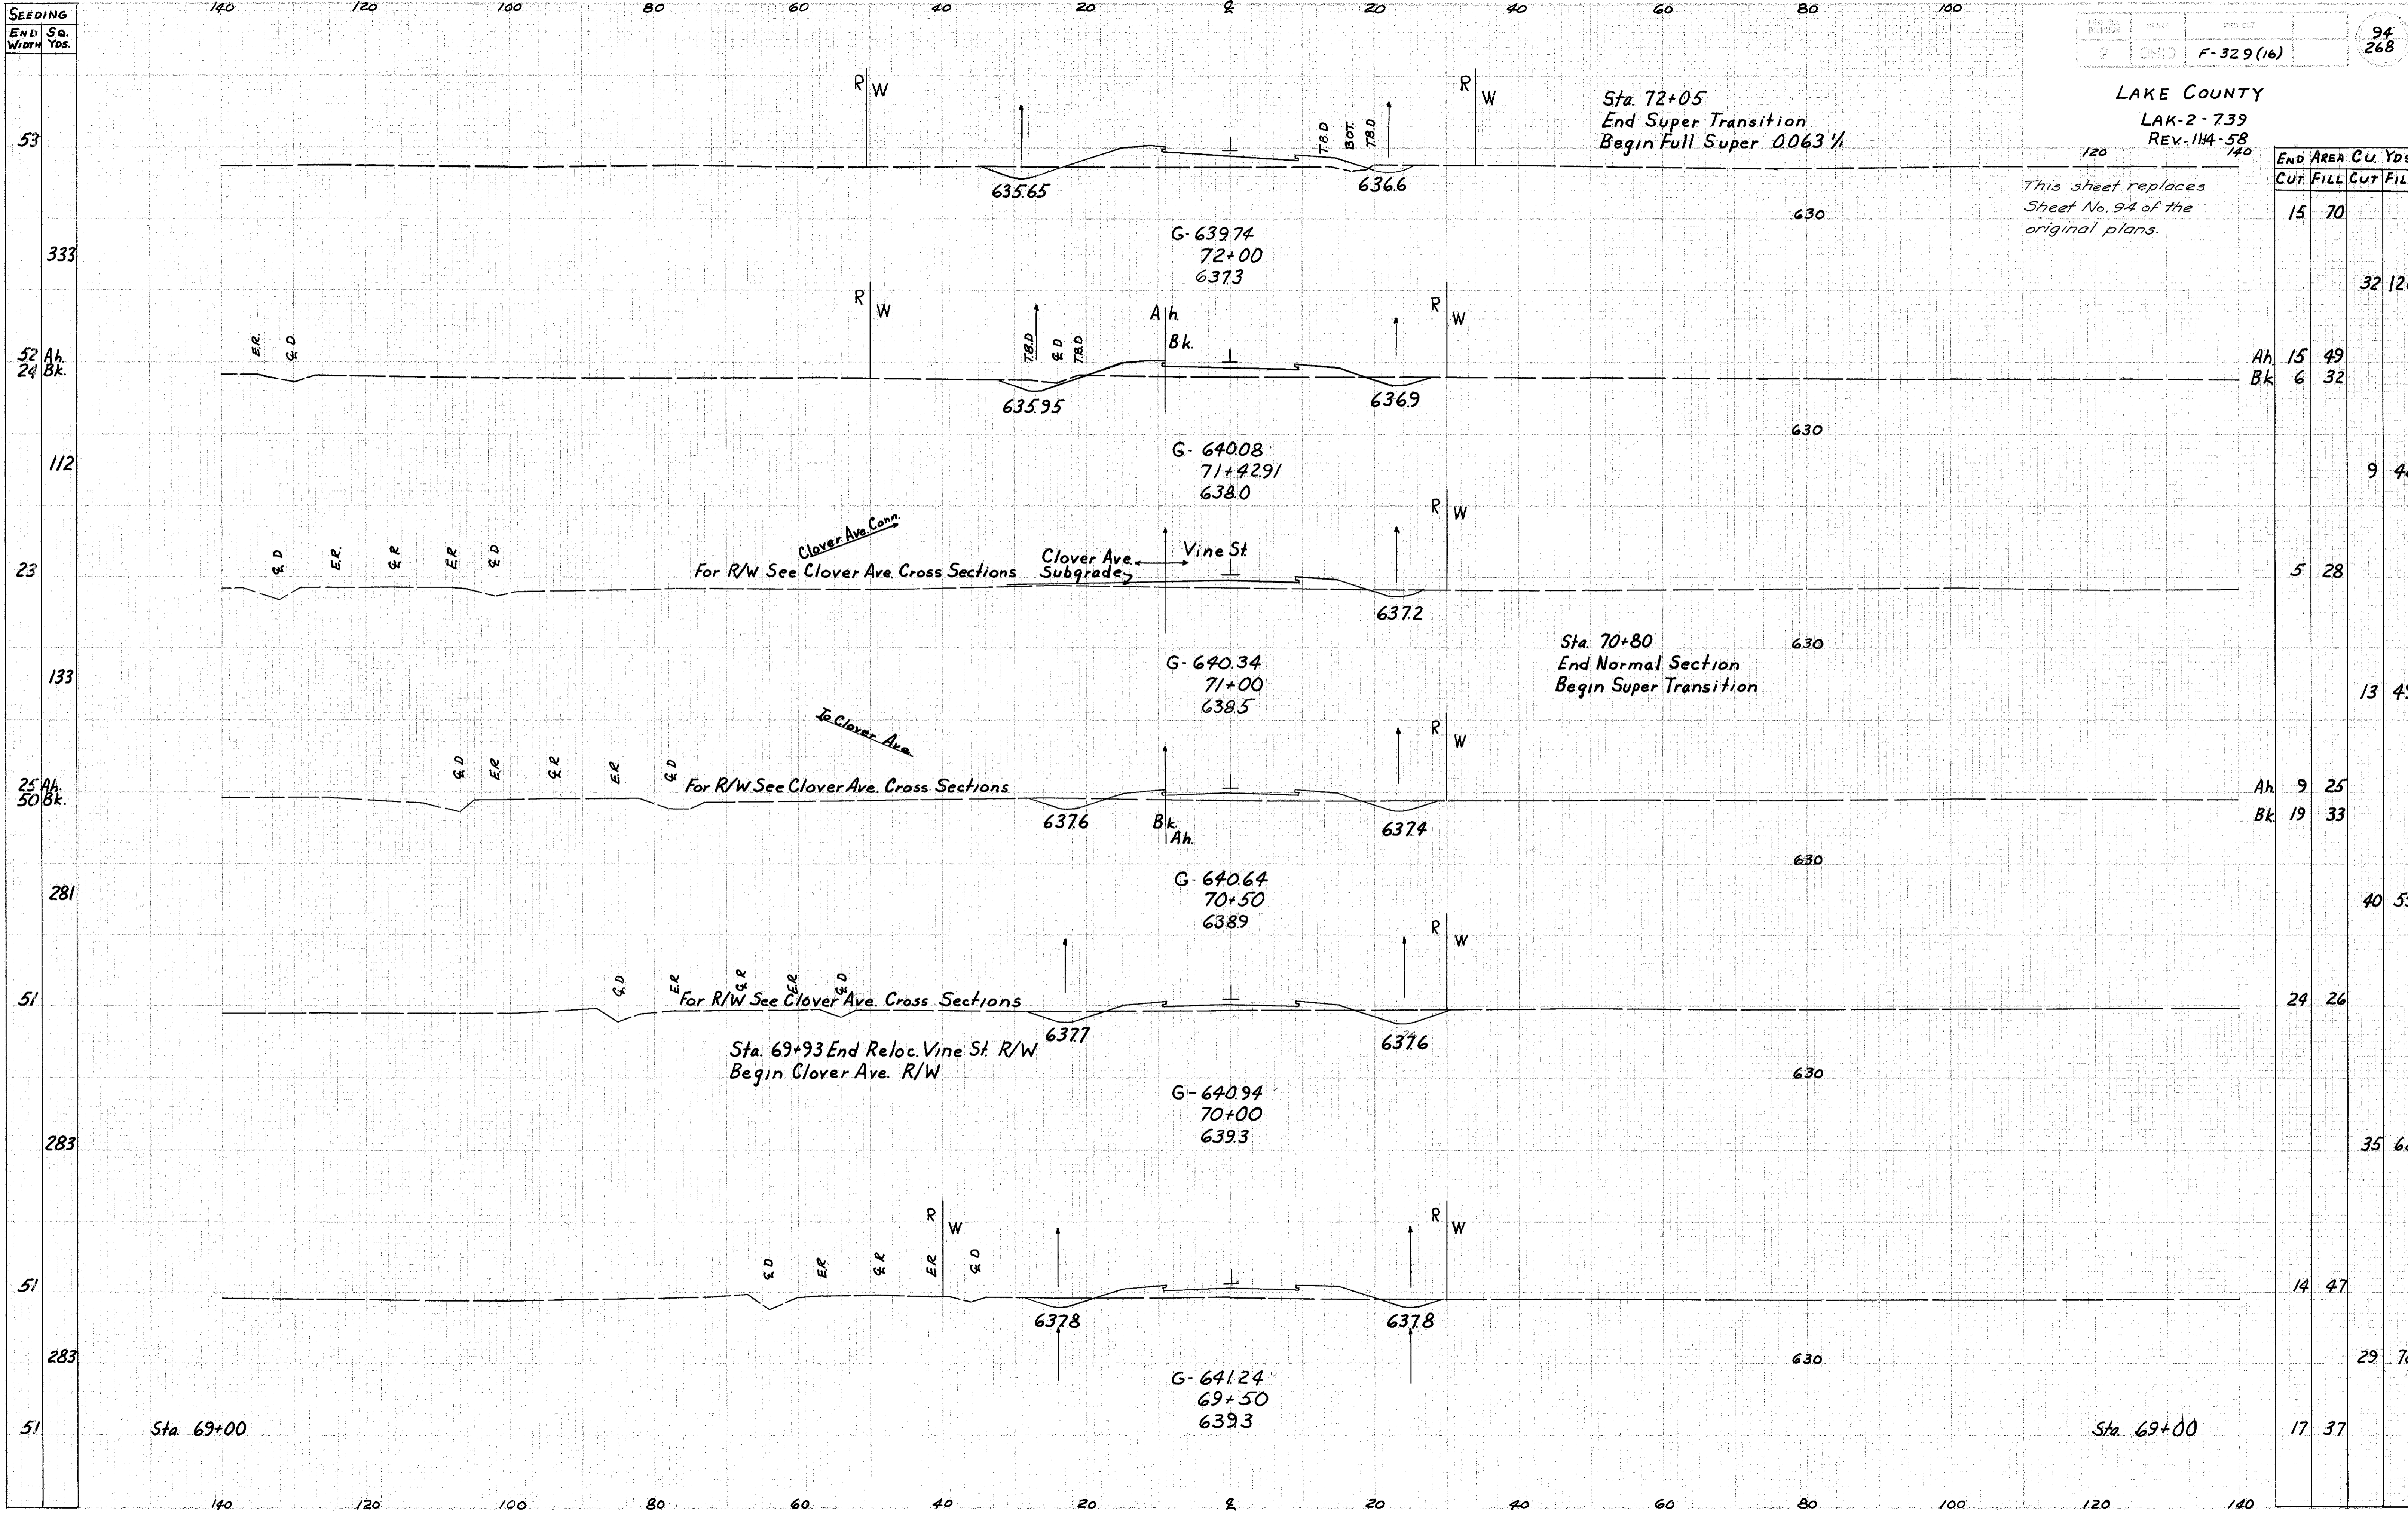

This sheet replaces  
Sheet No. 94 of the  
original plans.

END AREA C.U. YDS.		CUT FILL CUT FILL	
15	70		
		32	126
Ah	15	49	
Bk	6	32	
		9	48
		5	28
		13	49
Ah	9	25	
Bk	19	33	
		40	55
		24	26
		35	68
		14	47
		29	78
		17	37