


SEEDING  
END WIDTH SQ. YDS.

LAKE COUNTY  
LAK-2-739  
REV. 11-14-58

This sheet replaces  
Sheet No. 96 of the  
original plans.

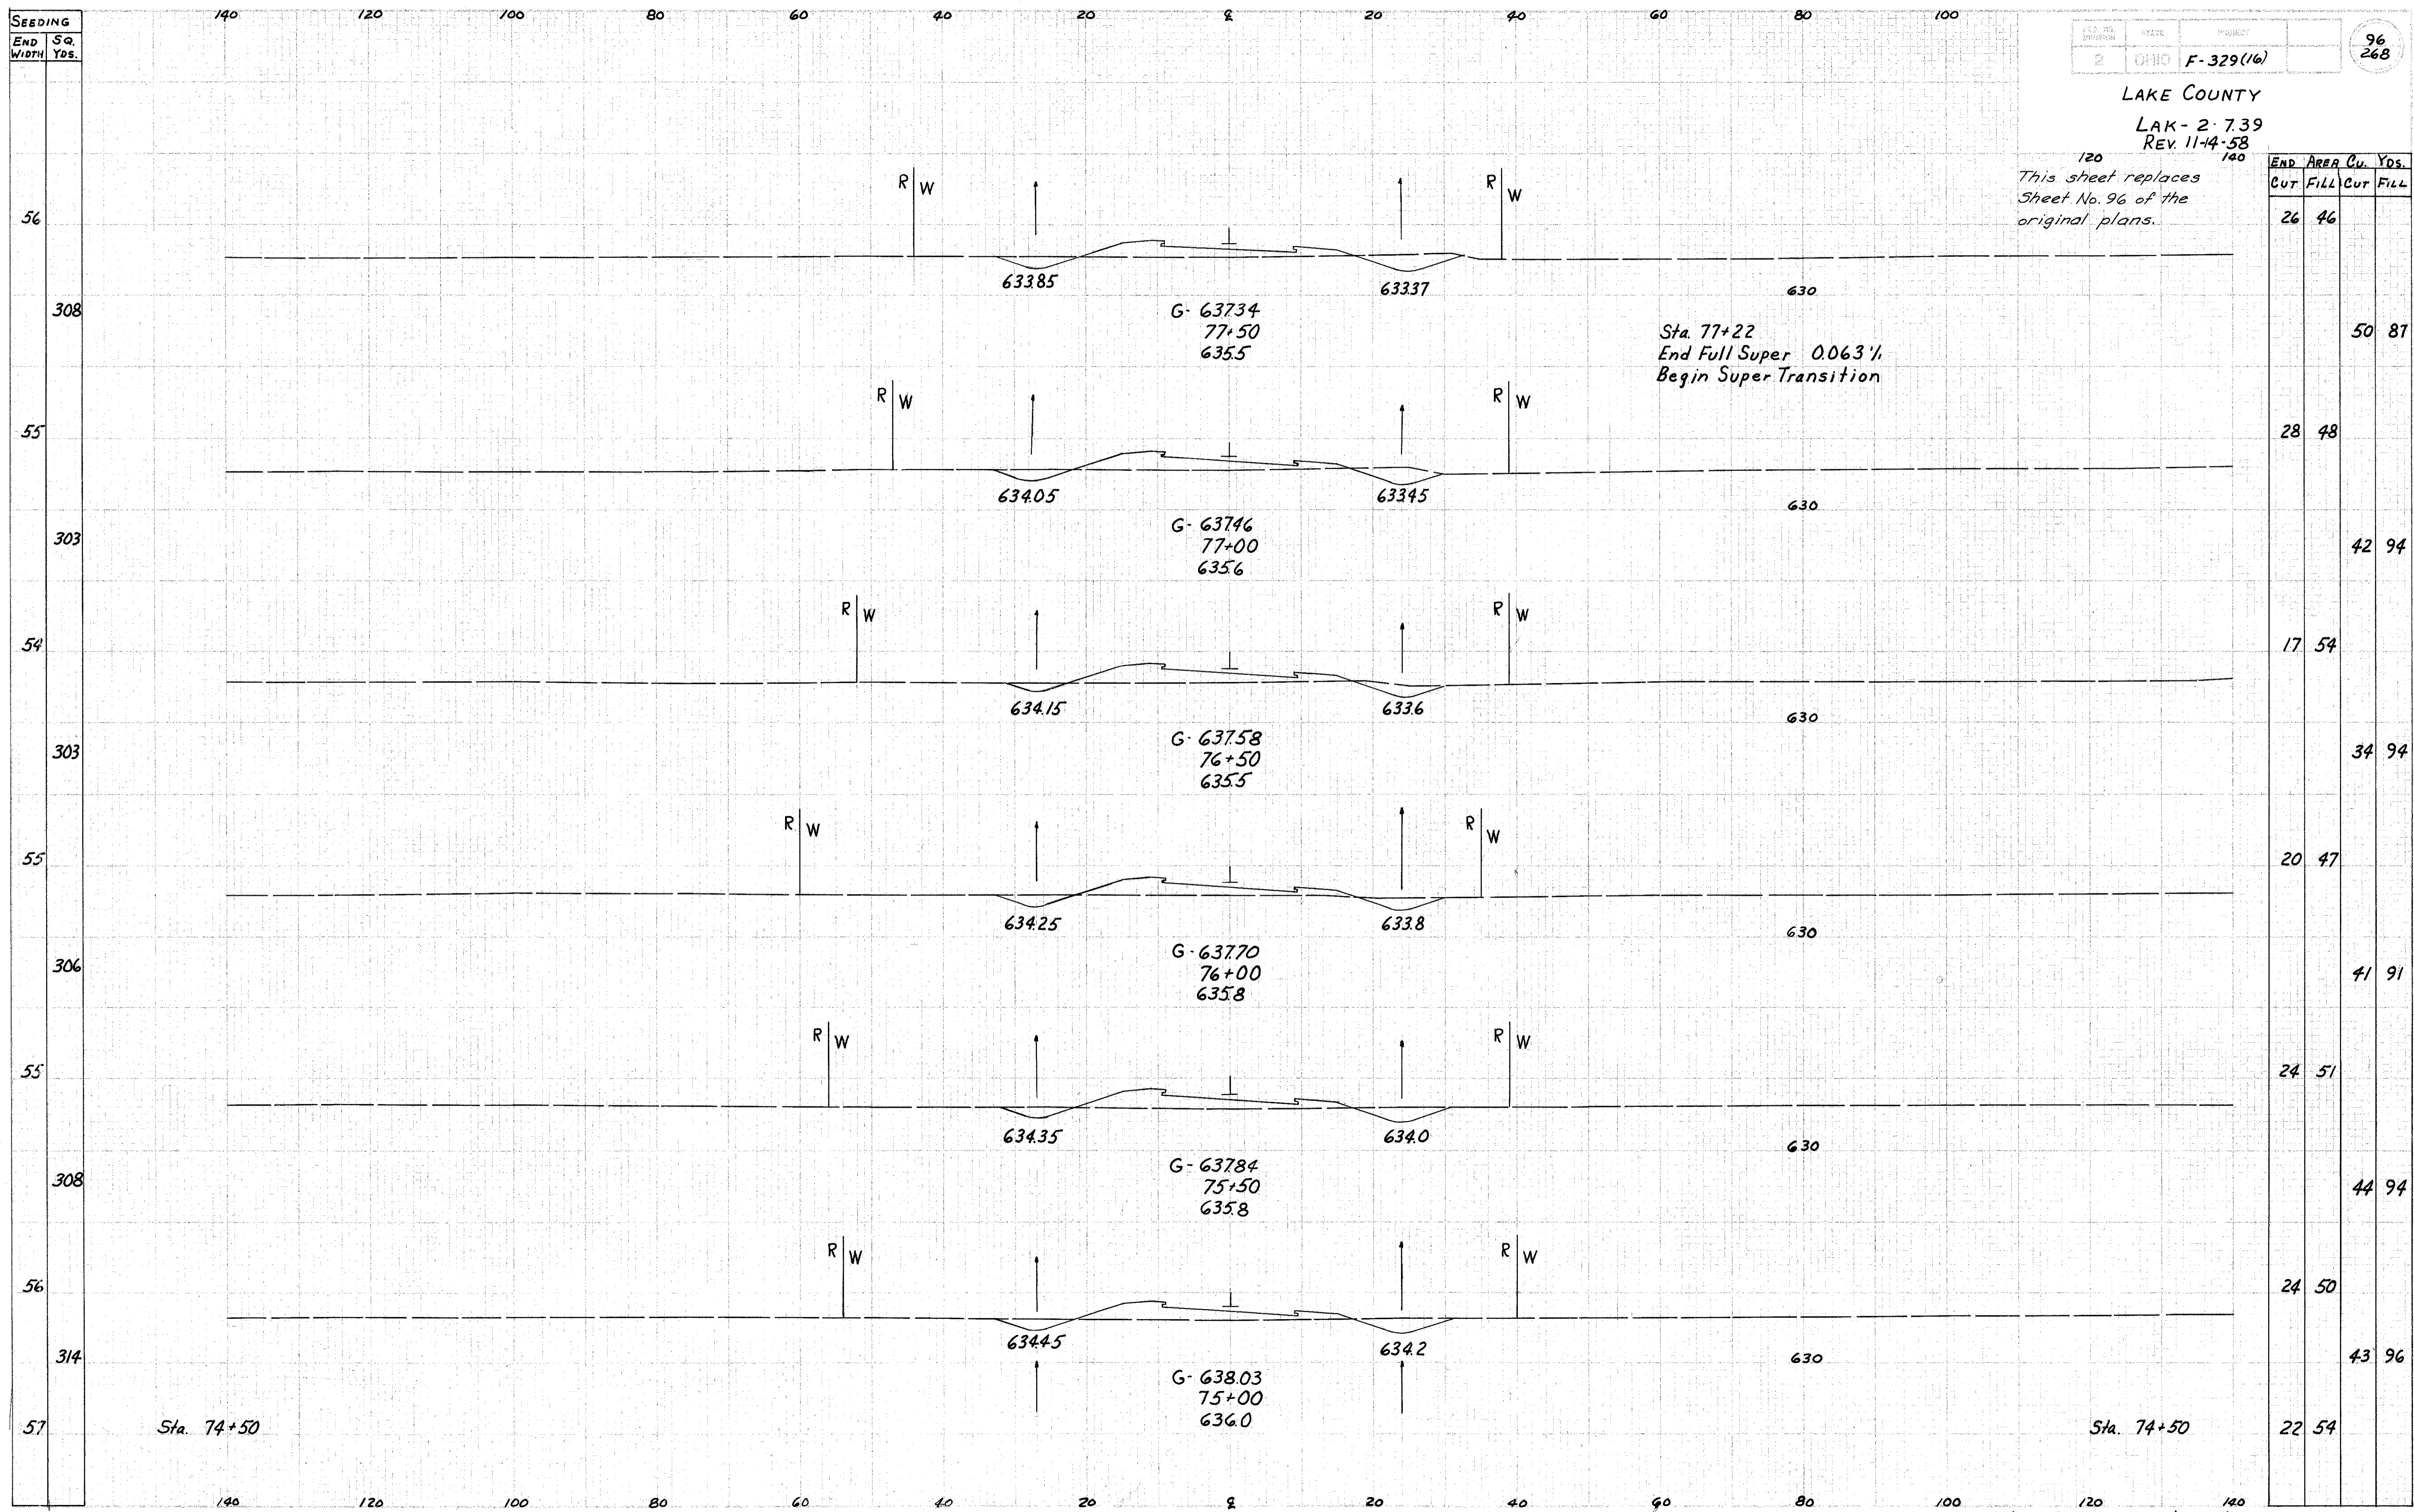

END AREA		Cu. Yds.	
CUT	FILL	CUT	FILL
26	46		
		50	87
28	48		
		42	94
17	54		
		34	94
20	47		
		41	91
24	51		
		44	94
24	50		
		43	96
22	54		

Sta. 74+50

Sta. 74+50