


SEEDING 140 120 100 80 60 40 20 0 20 40 60 80 100

END SR. END WIDTH YDS.

LAKE COUNTY
LAK 2-739
REV. 11-14-58

This sheet replaces
Sheet No. 97 of the
original plans.

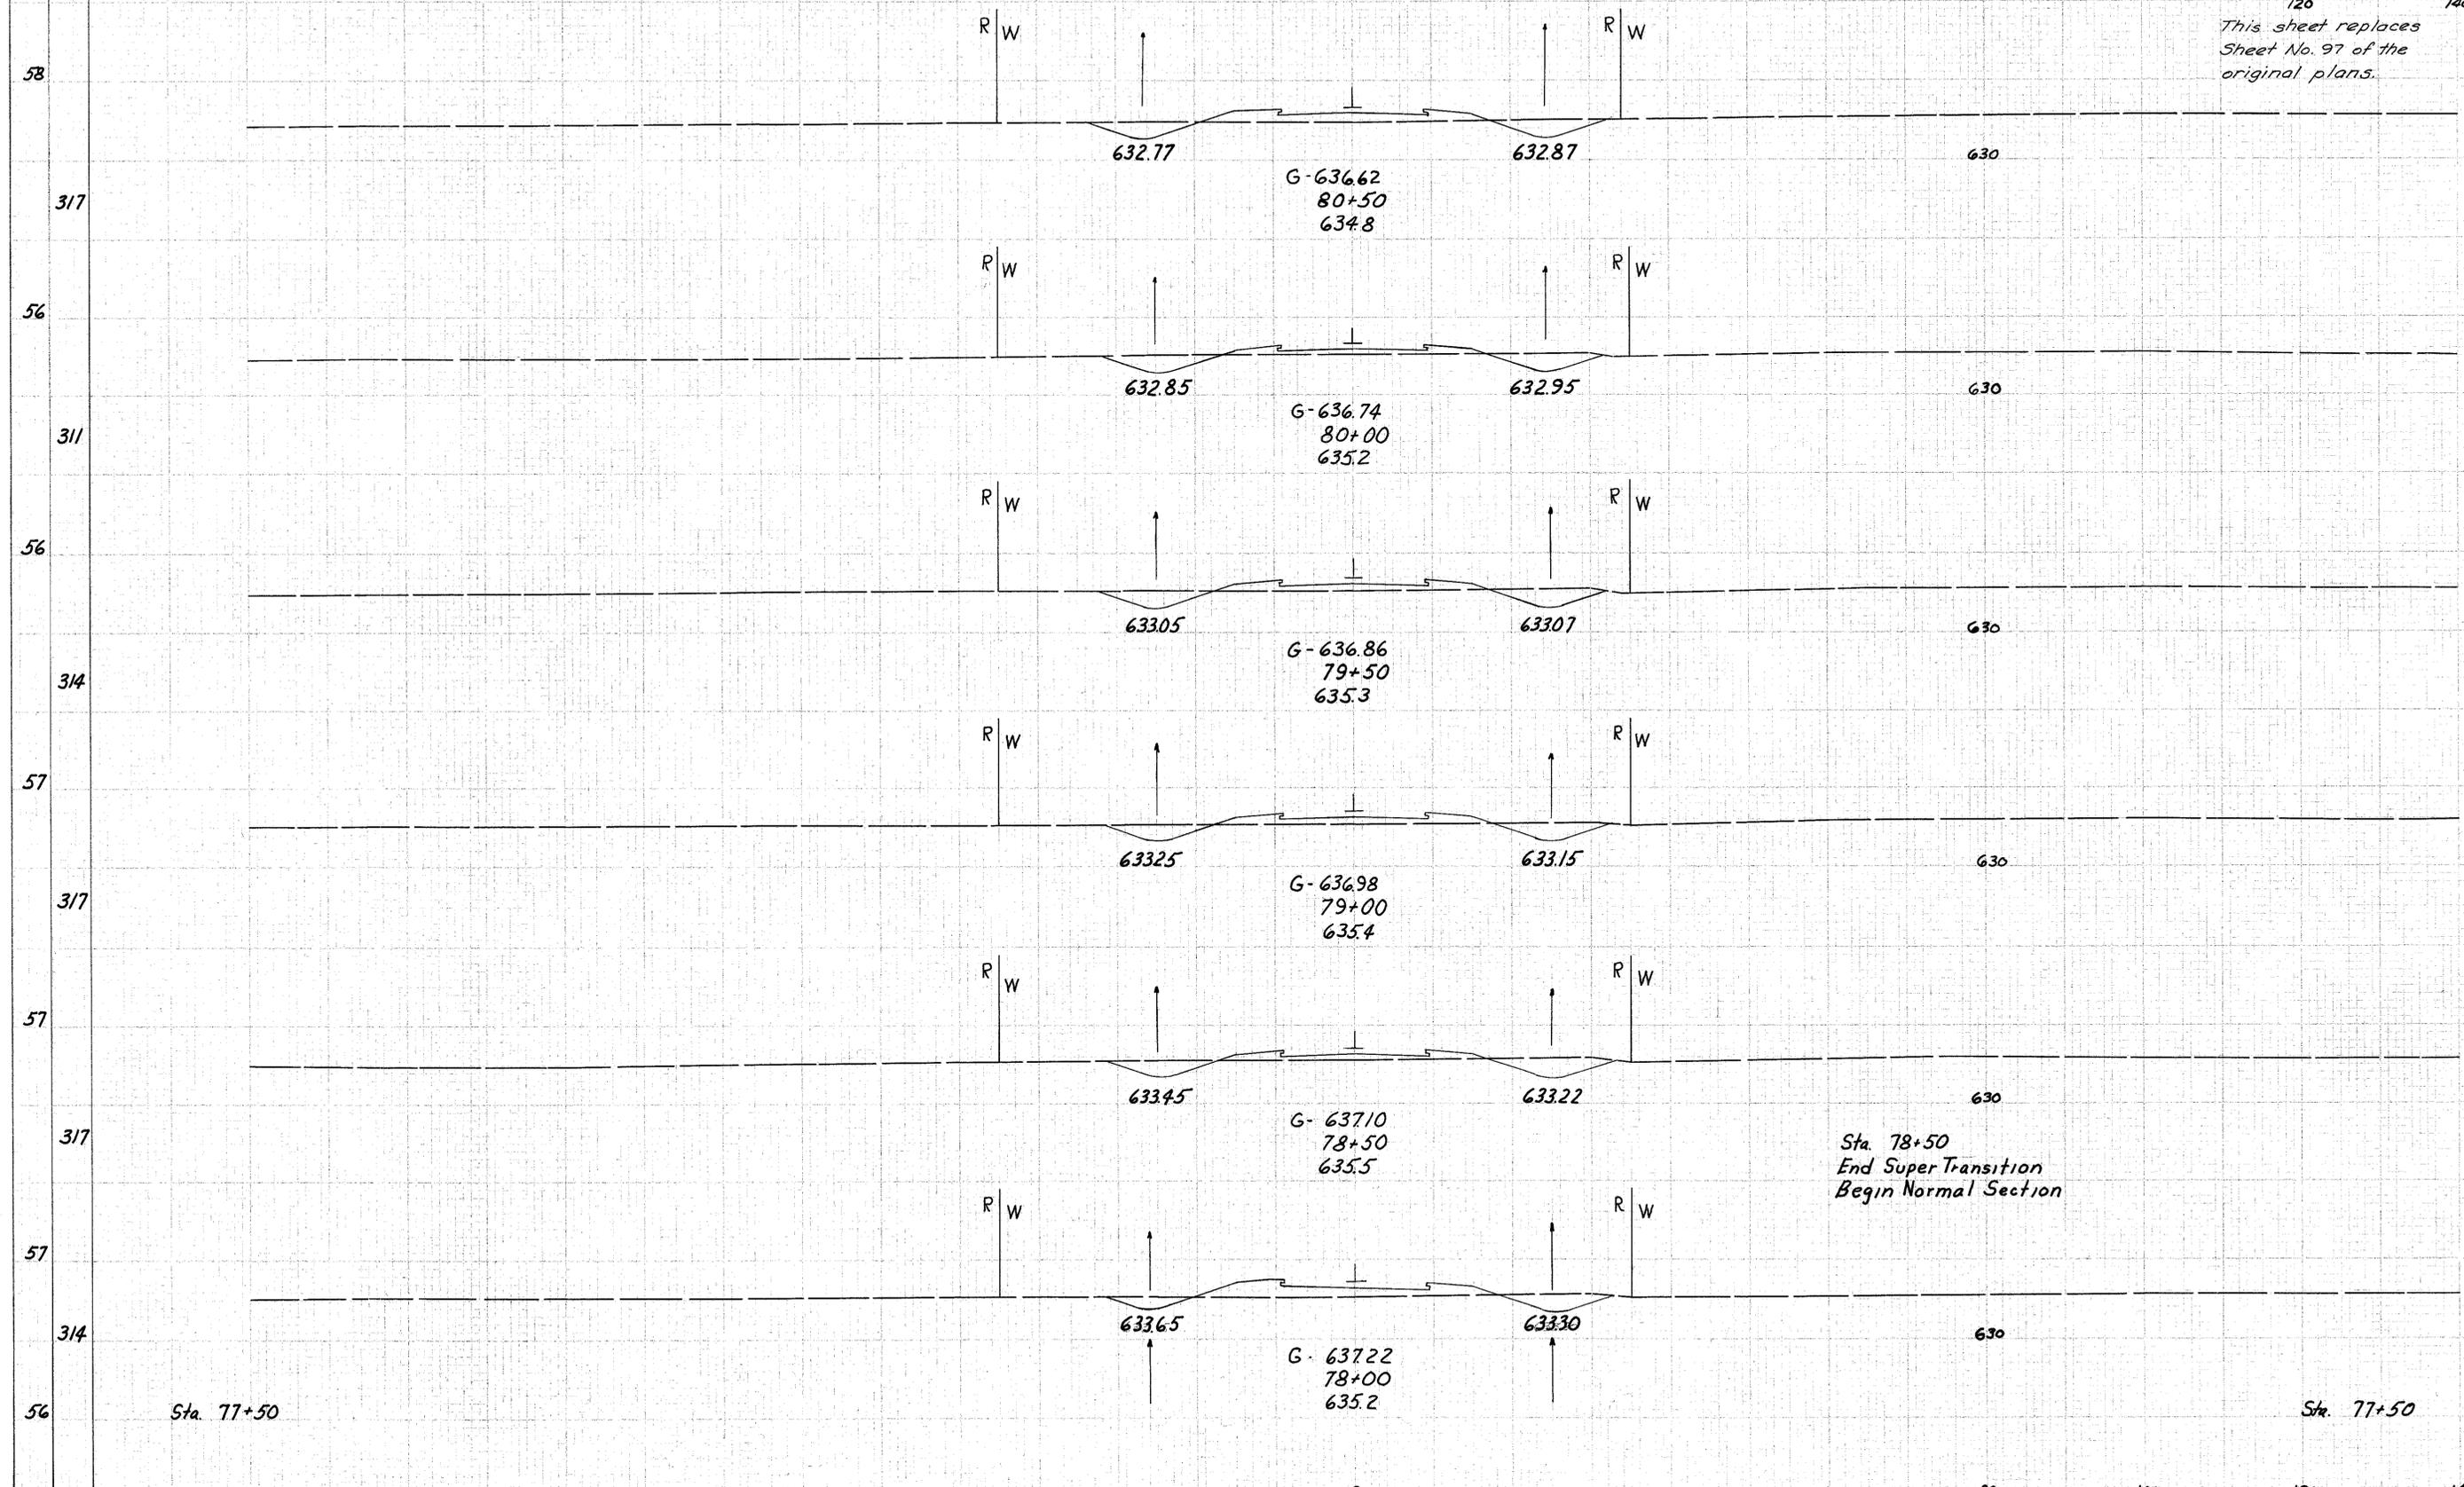

END	AREA CU.		YDS.	
	CUT	FILL	CUT	FILL
38	34	37		
317			65	54
56	36	21		
311			68	44
56	37	27		
314			66	51
57	34	28		
317			69	45
57	40	21		
317			63	62
57	28	46		
314			50	85
56	26	46		

Sta. 77+50

Sta. 77+50

Sta. 78+50
End Super Transition
Begin Normal Section