


SEEDING
END SQ.
WIDTH YDS.

LAKE COUNTY
LAK-2-739
REV. 11-14-58

This sheet replaces
Sheet No. 98 of the
original plans.

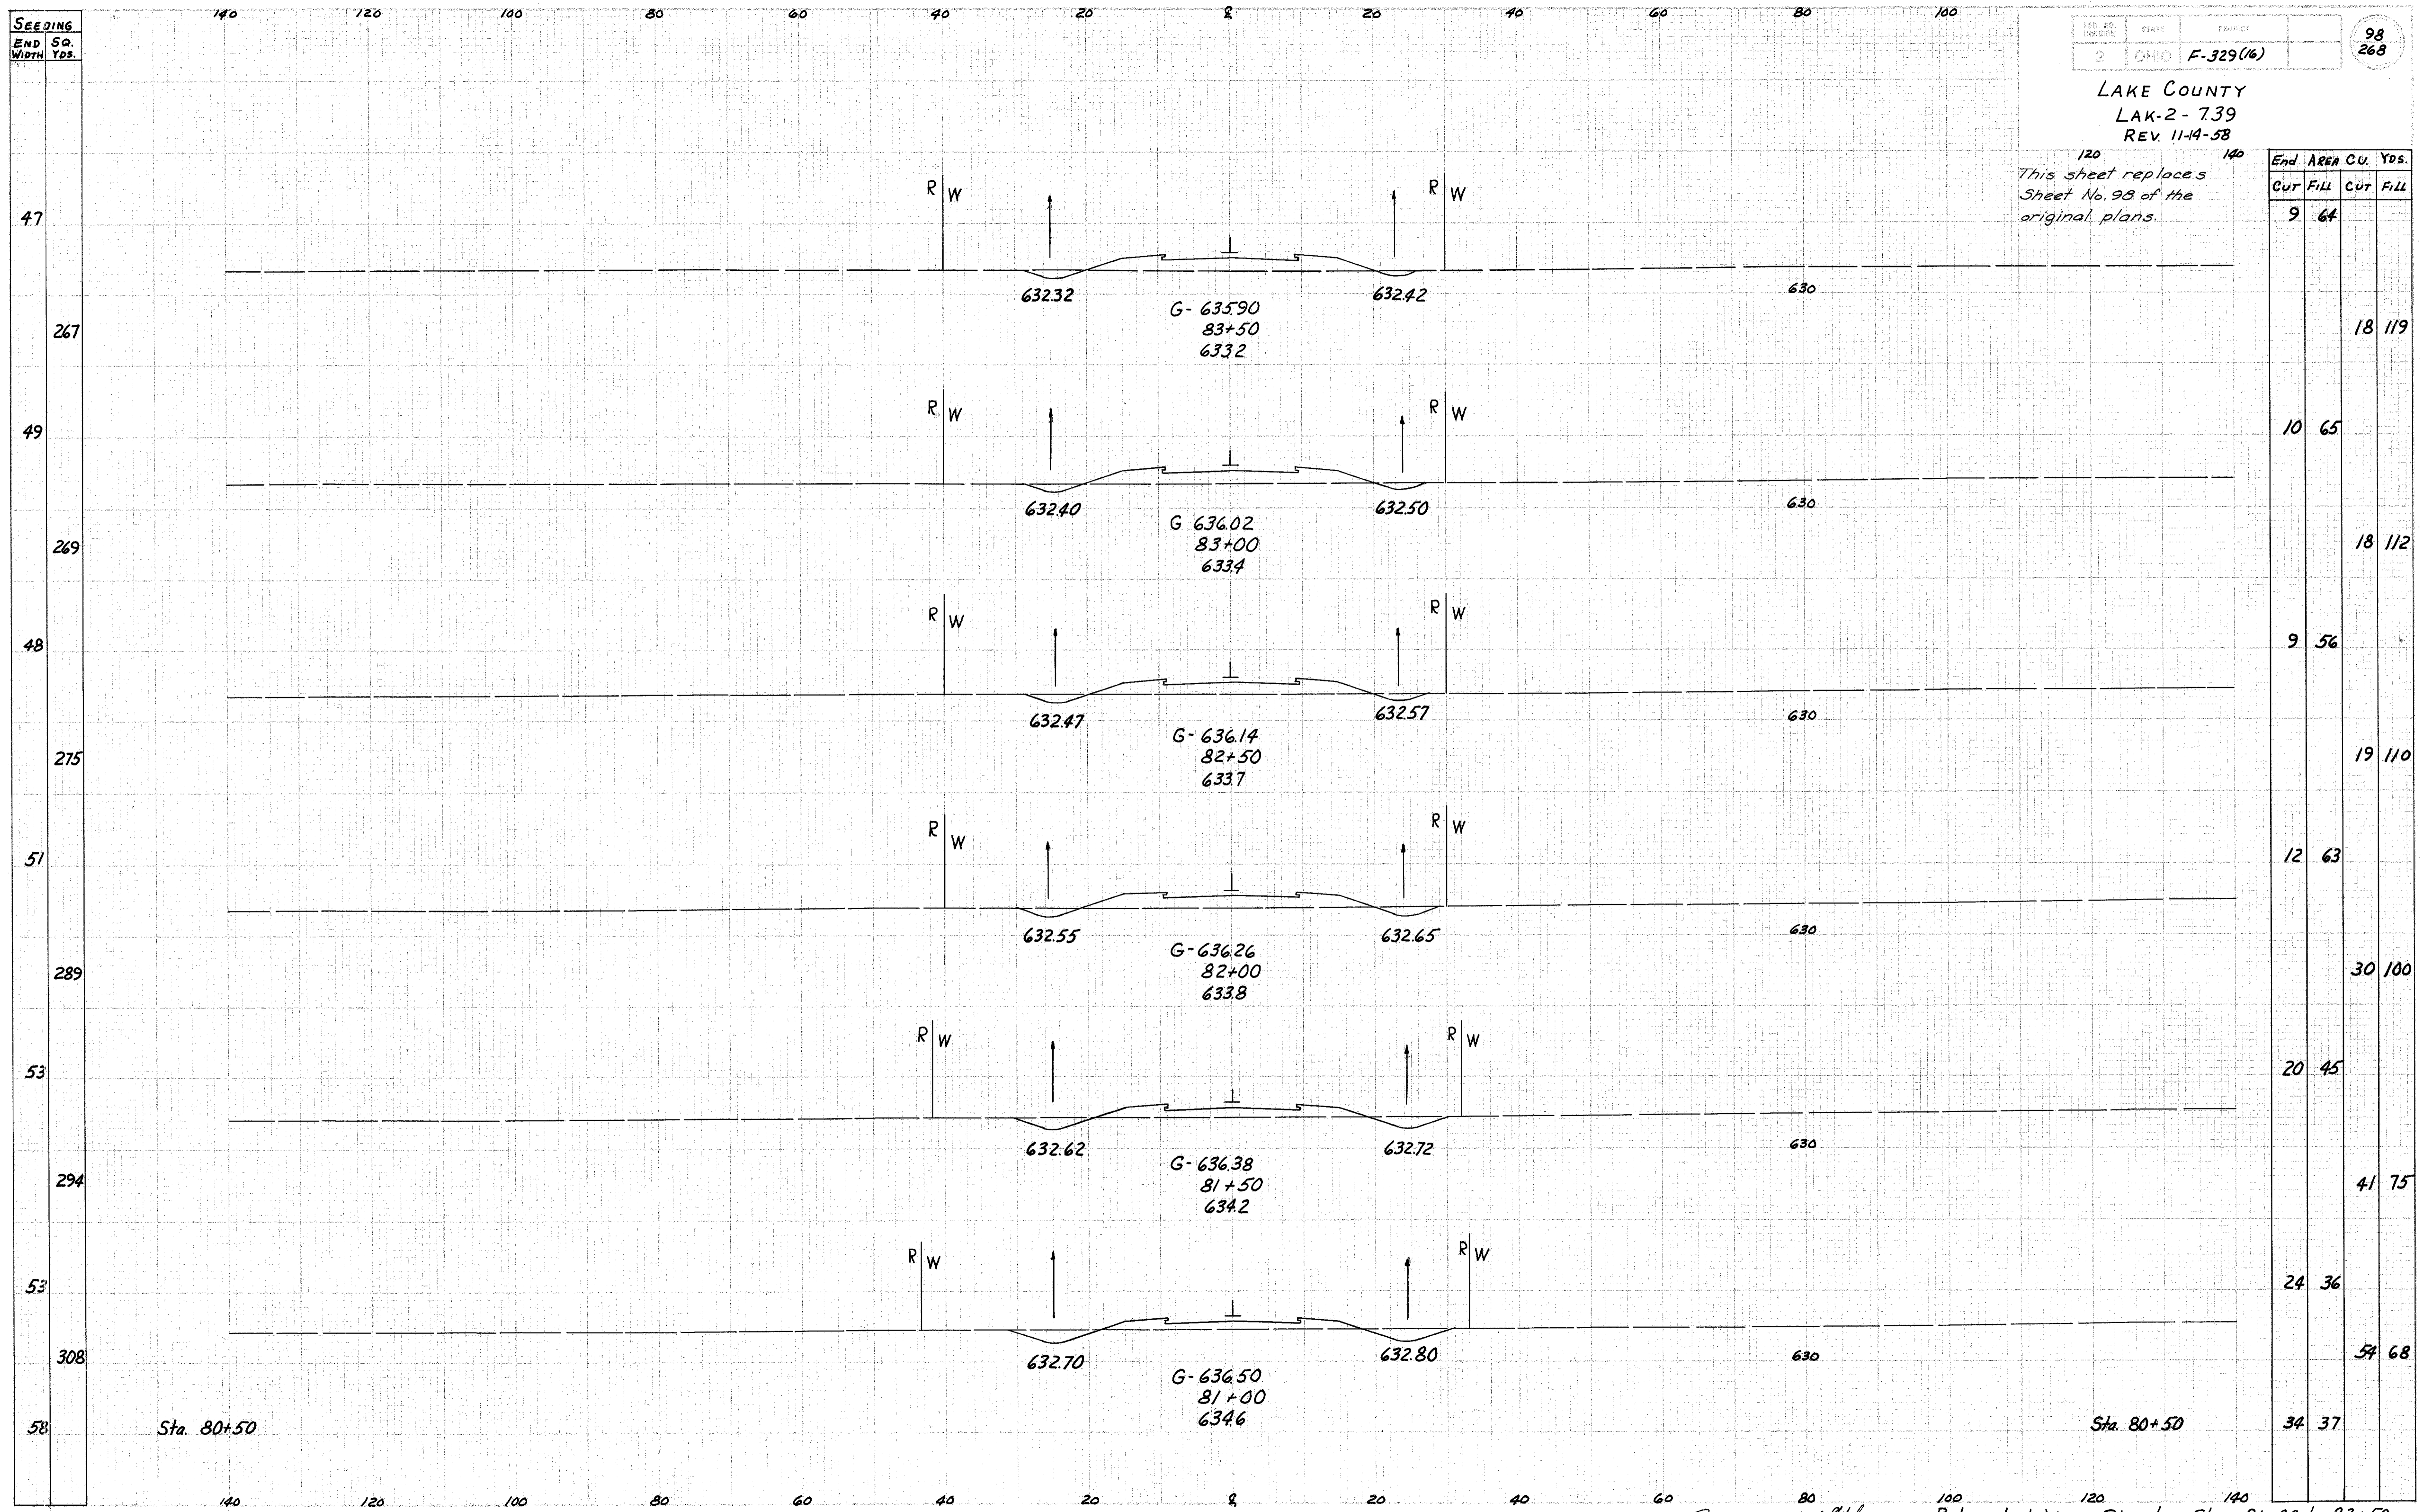

End	AREA	CU.	Yds.
Cut	Fill	Cut	Fill
9	64		
		18	119
10	65		
		18	112
9	56		
		19	110
12	63		
		30	100
20	45		
		41	75
24	36		
		57	68
34	37		

Sta. 80+50

Sta. 80+50