

SEEDING  
END SQ.  
Width Yds.


140 120 100 80 60 40 20 0 20 40 60 80 100

|               |       |           |            |
|---------------|-------|-----------|------------|
| NO. OF SHEETS | STATE | PROJECT   | 100<br>268 |
| 2             | OHIO  | F-329(16) |            |

LAKE COUNTY  
LAK-2-739  
REV 11-14-58

This sheet replaces  
Sheet No. 100 of the  
original plans.

END AREA Cu. Yds.  
CUT FILL CUT FILL

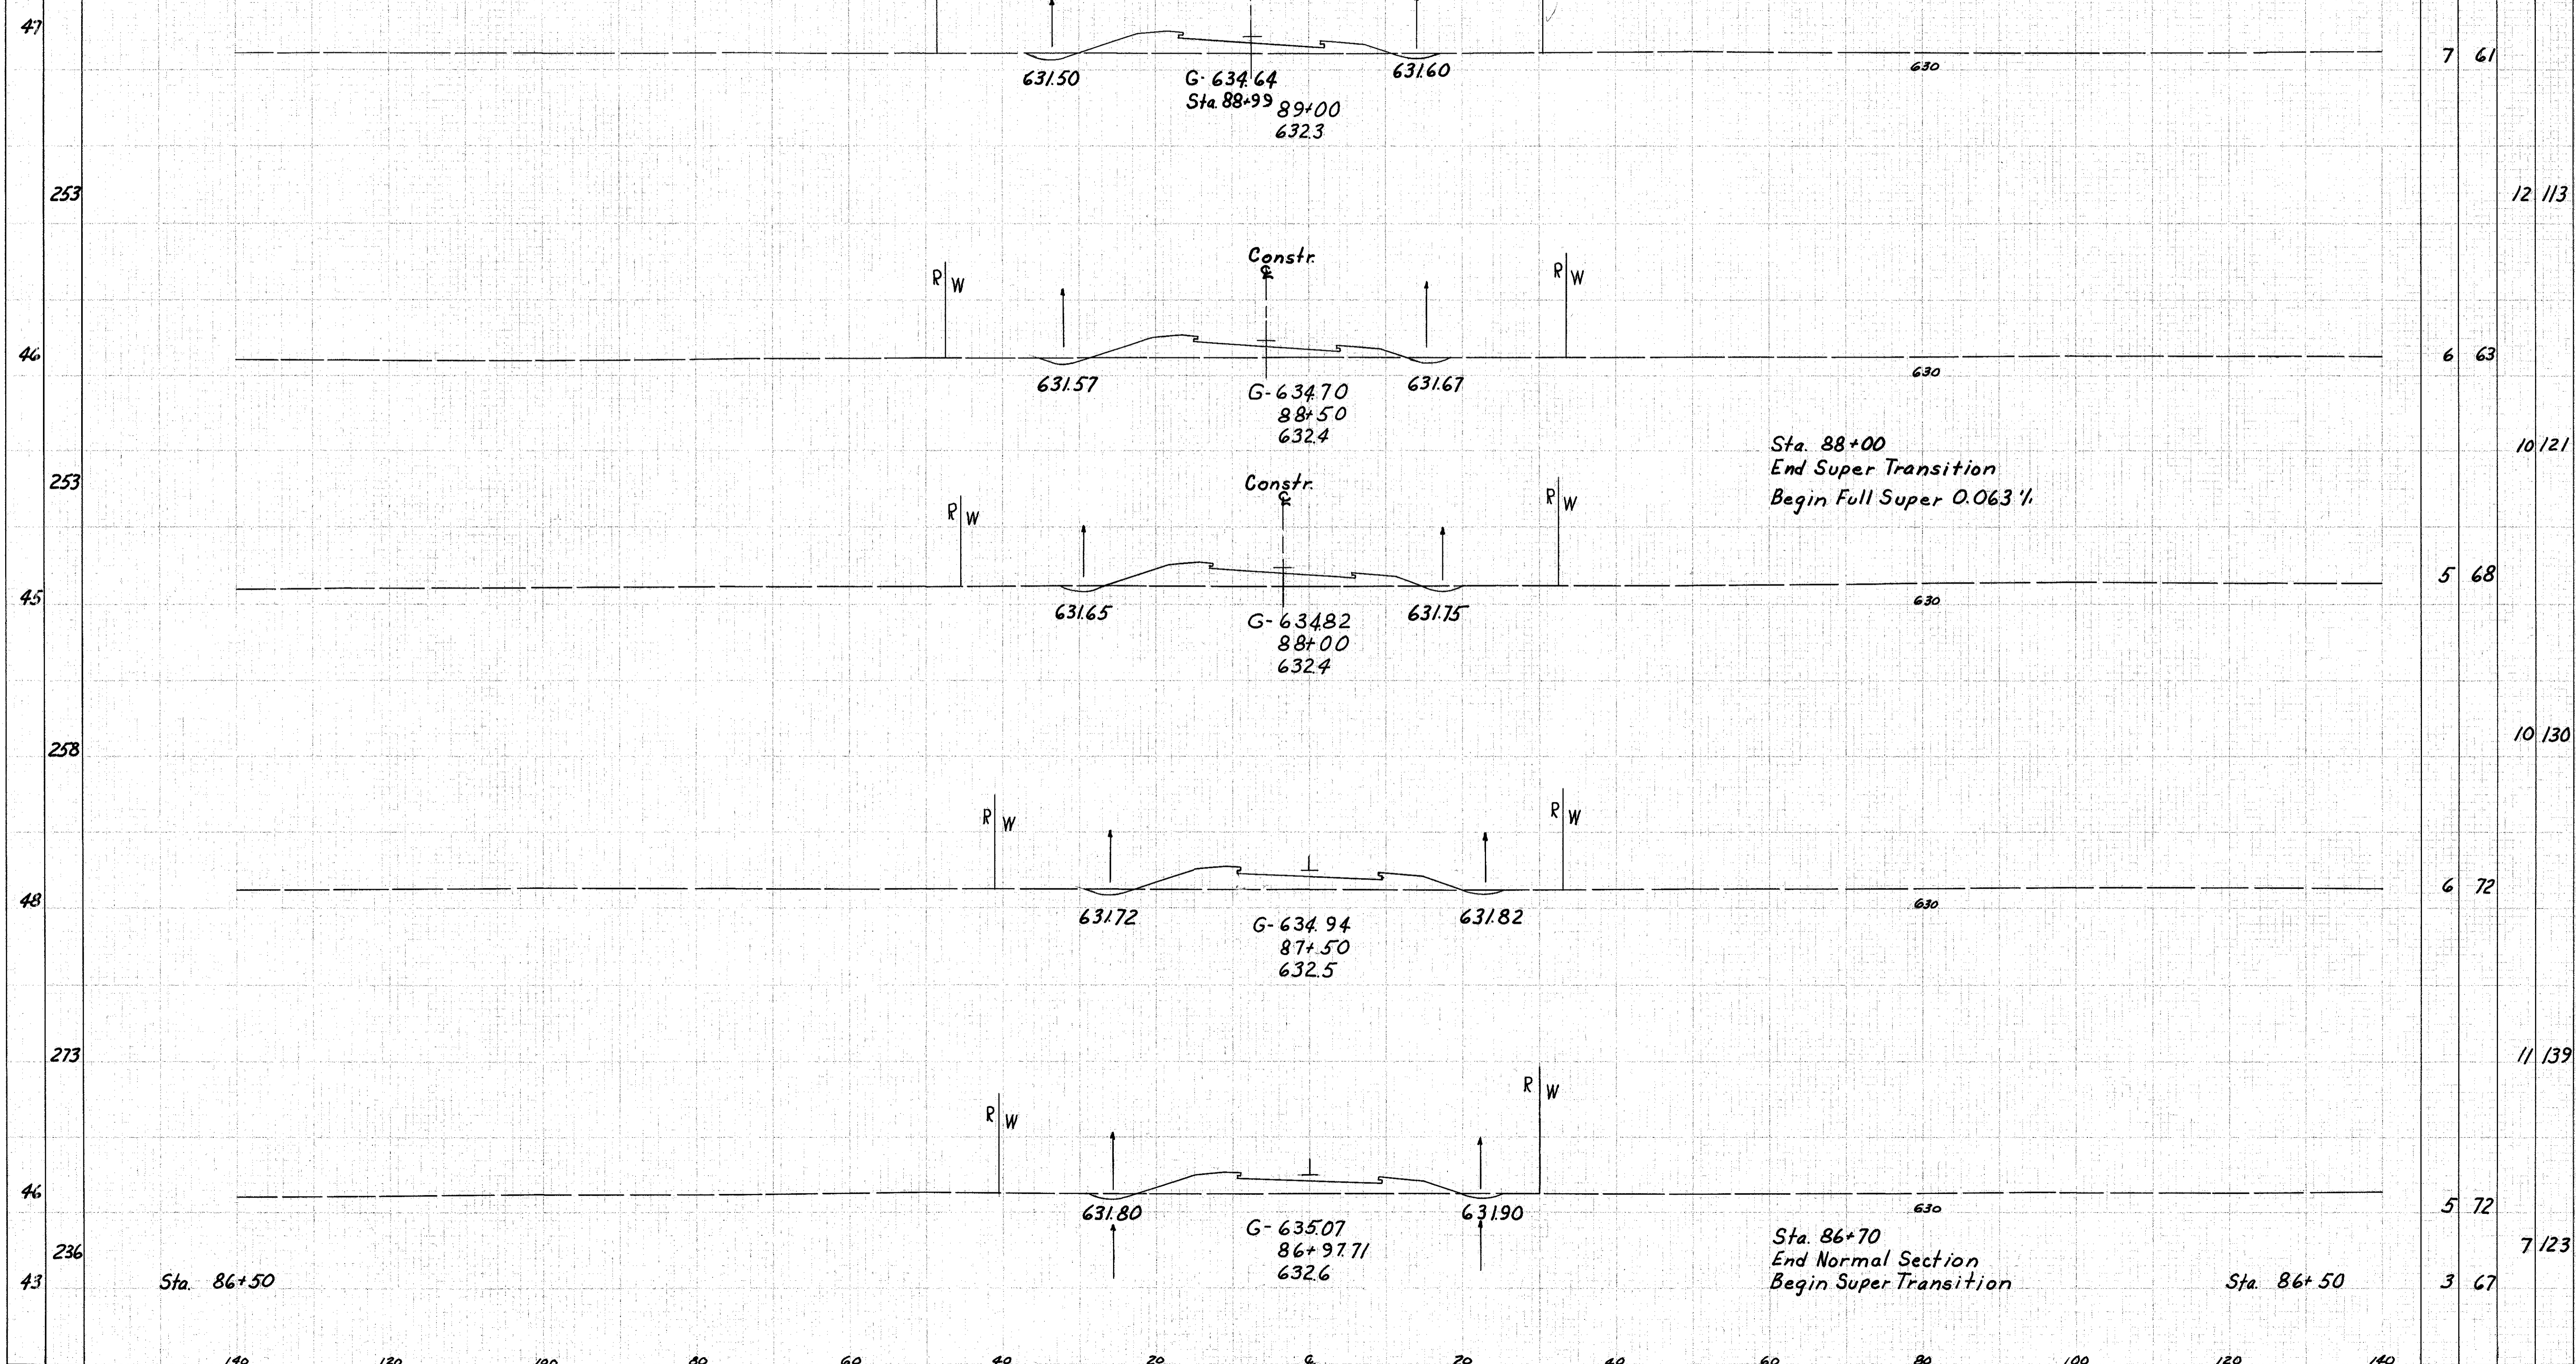

|   |    |    |     |
|---|----|----|-----|
| 7 | 61 |    |     |
|   |    | 12 | 113 |
| 6 | 63 |    |     |
|   |    | 10 | 121 |
| 5 | 68 |    |     |
|   |    | 10 | 130 |
| 6 | 72 |    |     |
|   |    | 11 | 139 |
| 5 | 72 |    |     |
|   |    | 7  | 123 |
| 3 | 67 |    |     |