


SEEDING  
END SO.  
WIDTH YDS.

LAKE COUNTY  
LAK-2-739  
REV. 11-4-58

Equation:  
Constr. & P.T. Sta. 94+50.76 Bk.=  
Survey & Sta. 94+40.91 Ah.

This sheet replaces  
Sheet No. 102 of the  
original plans.

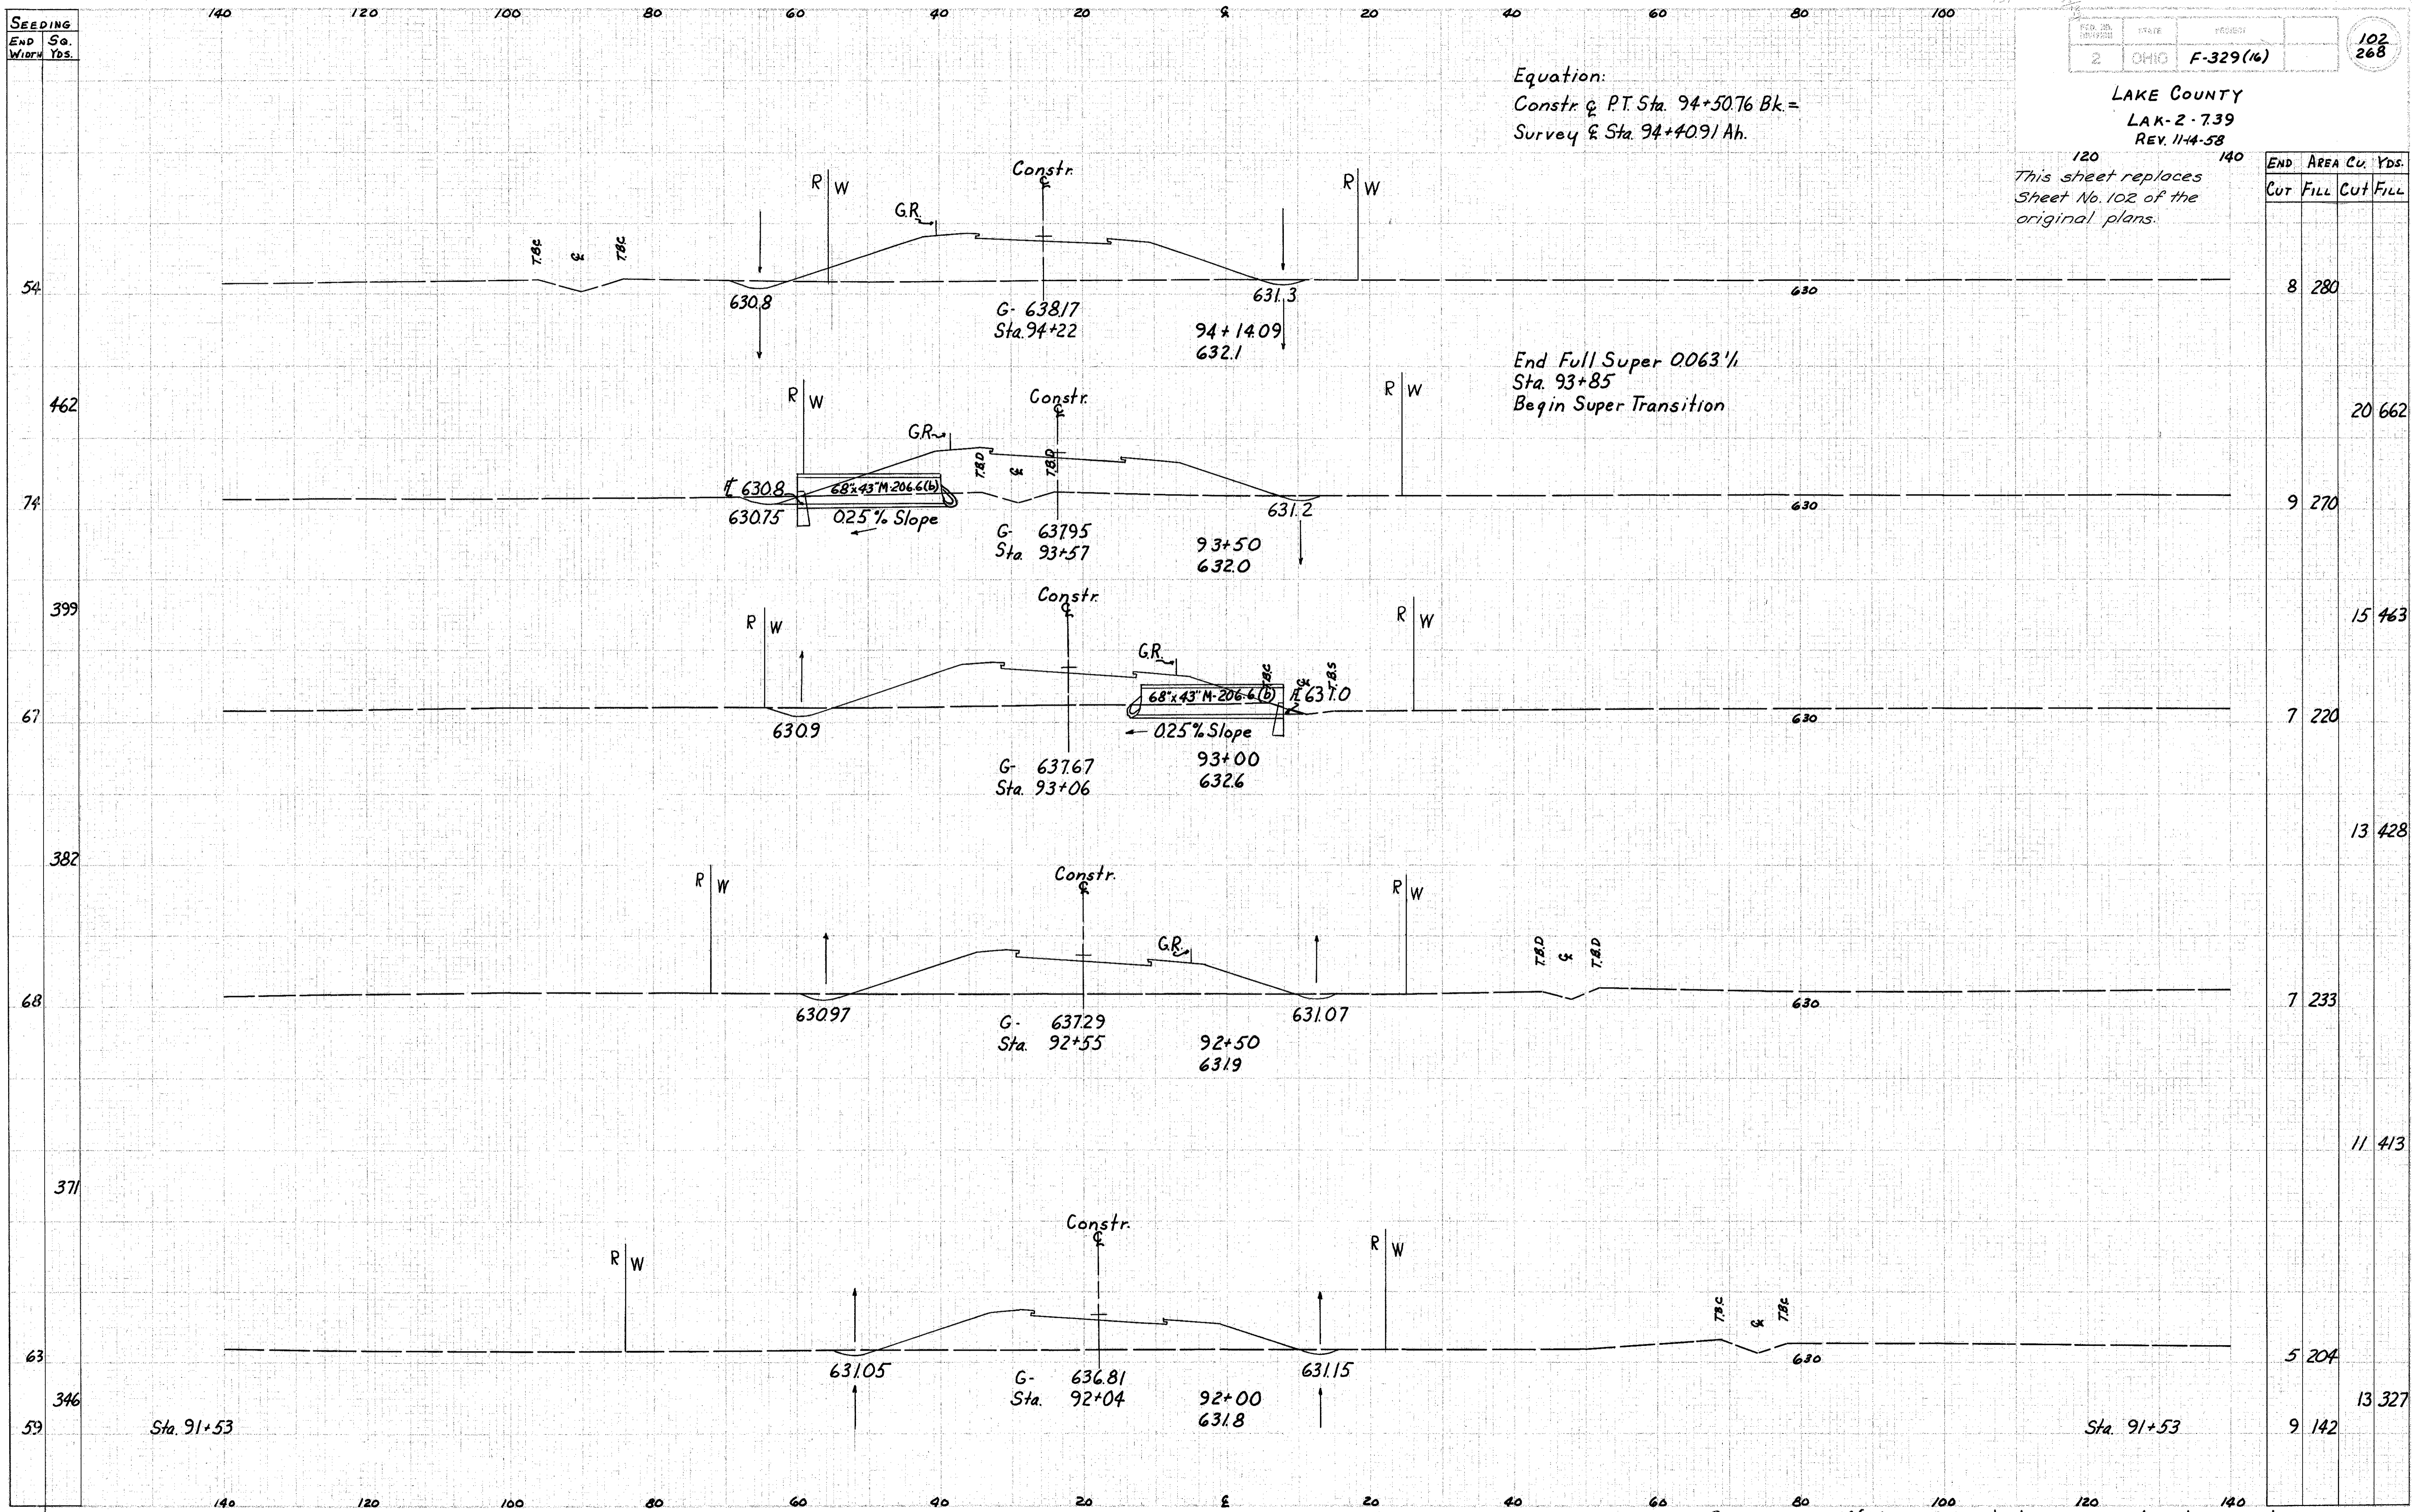

END	AREA	Cu.	YDS.
Cut	Fill	Cut	Fill
8	280		
9	270		
7	220		
7	233		
5	204		
9	142		
		15	463
		13	428
		11	413
		20	662
		13	327