


SEEDING	END SQ.	Width	Yds.
	40		
	450		
	41		
	461		
	42		
	483		
	45		
	511		
	47		
	544		
	51		

PLAN NO.	STATE	PROJECT	105 268
2	OHIO	F-329 (16)	

LAKE COUNTY
LAK-2-739
REV. 11-14-58

120 140
This sheet replaces
Sheet No. 105 of the
original plans.

END	AREA		Cu.	Yds.
	Cut	Fill		
1		50		
22		174		
11		44		
43		154		
12		39		
48		183		
14		60		
67		261		
22		81		
69		415		
15		143		

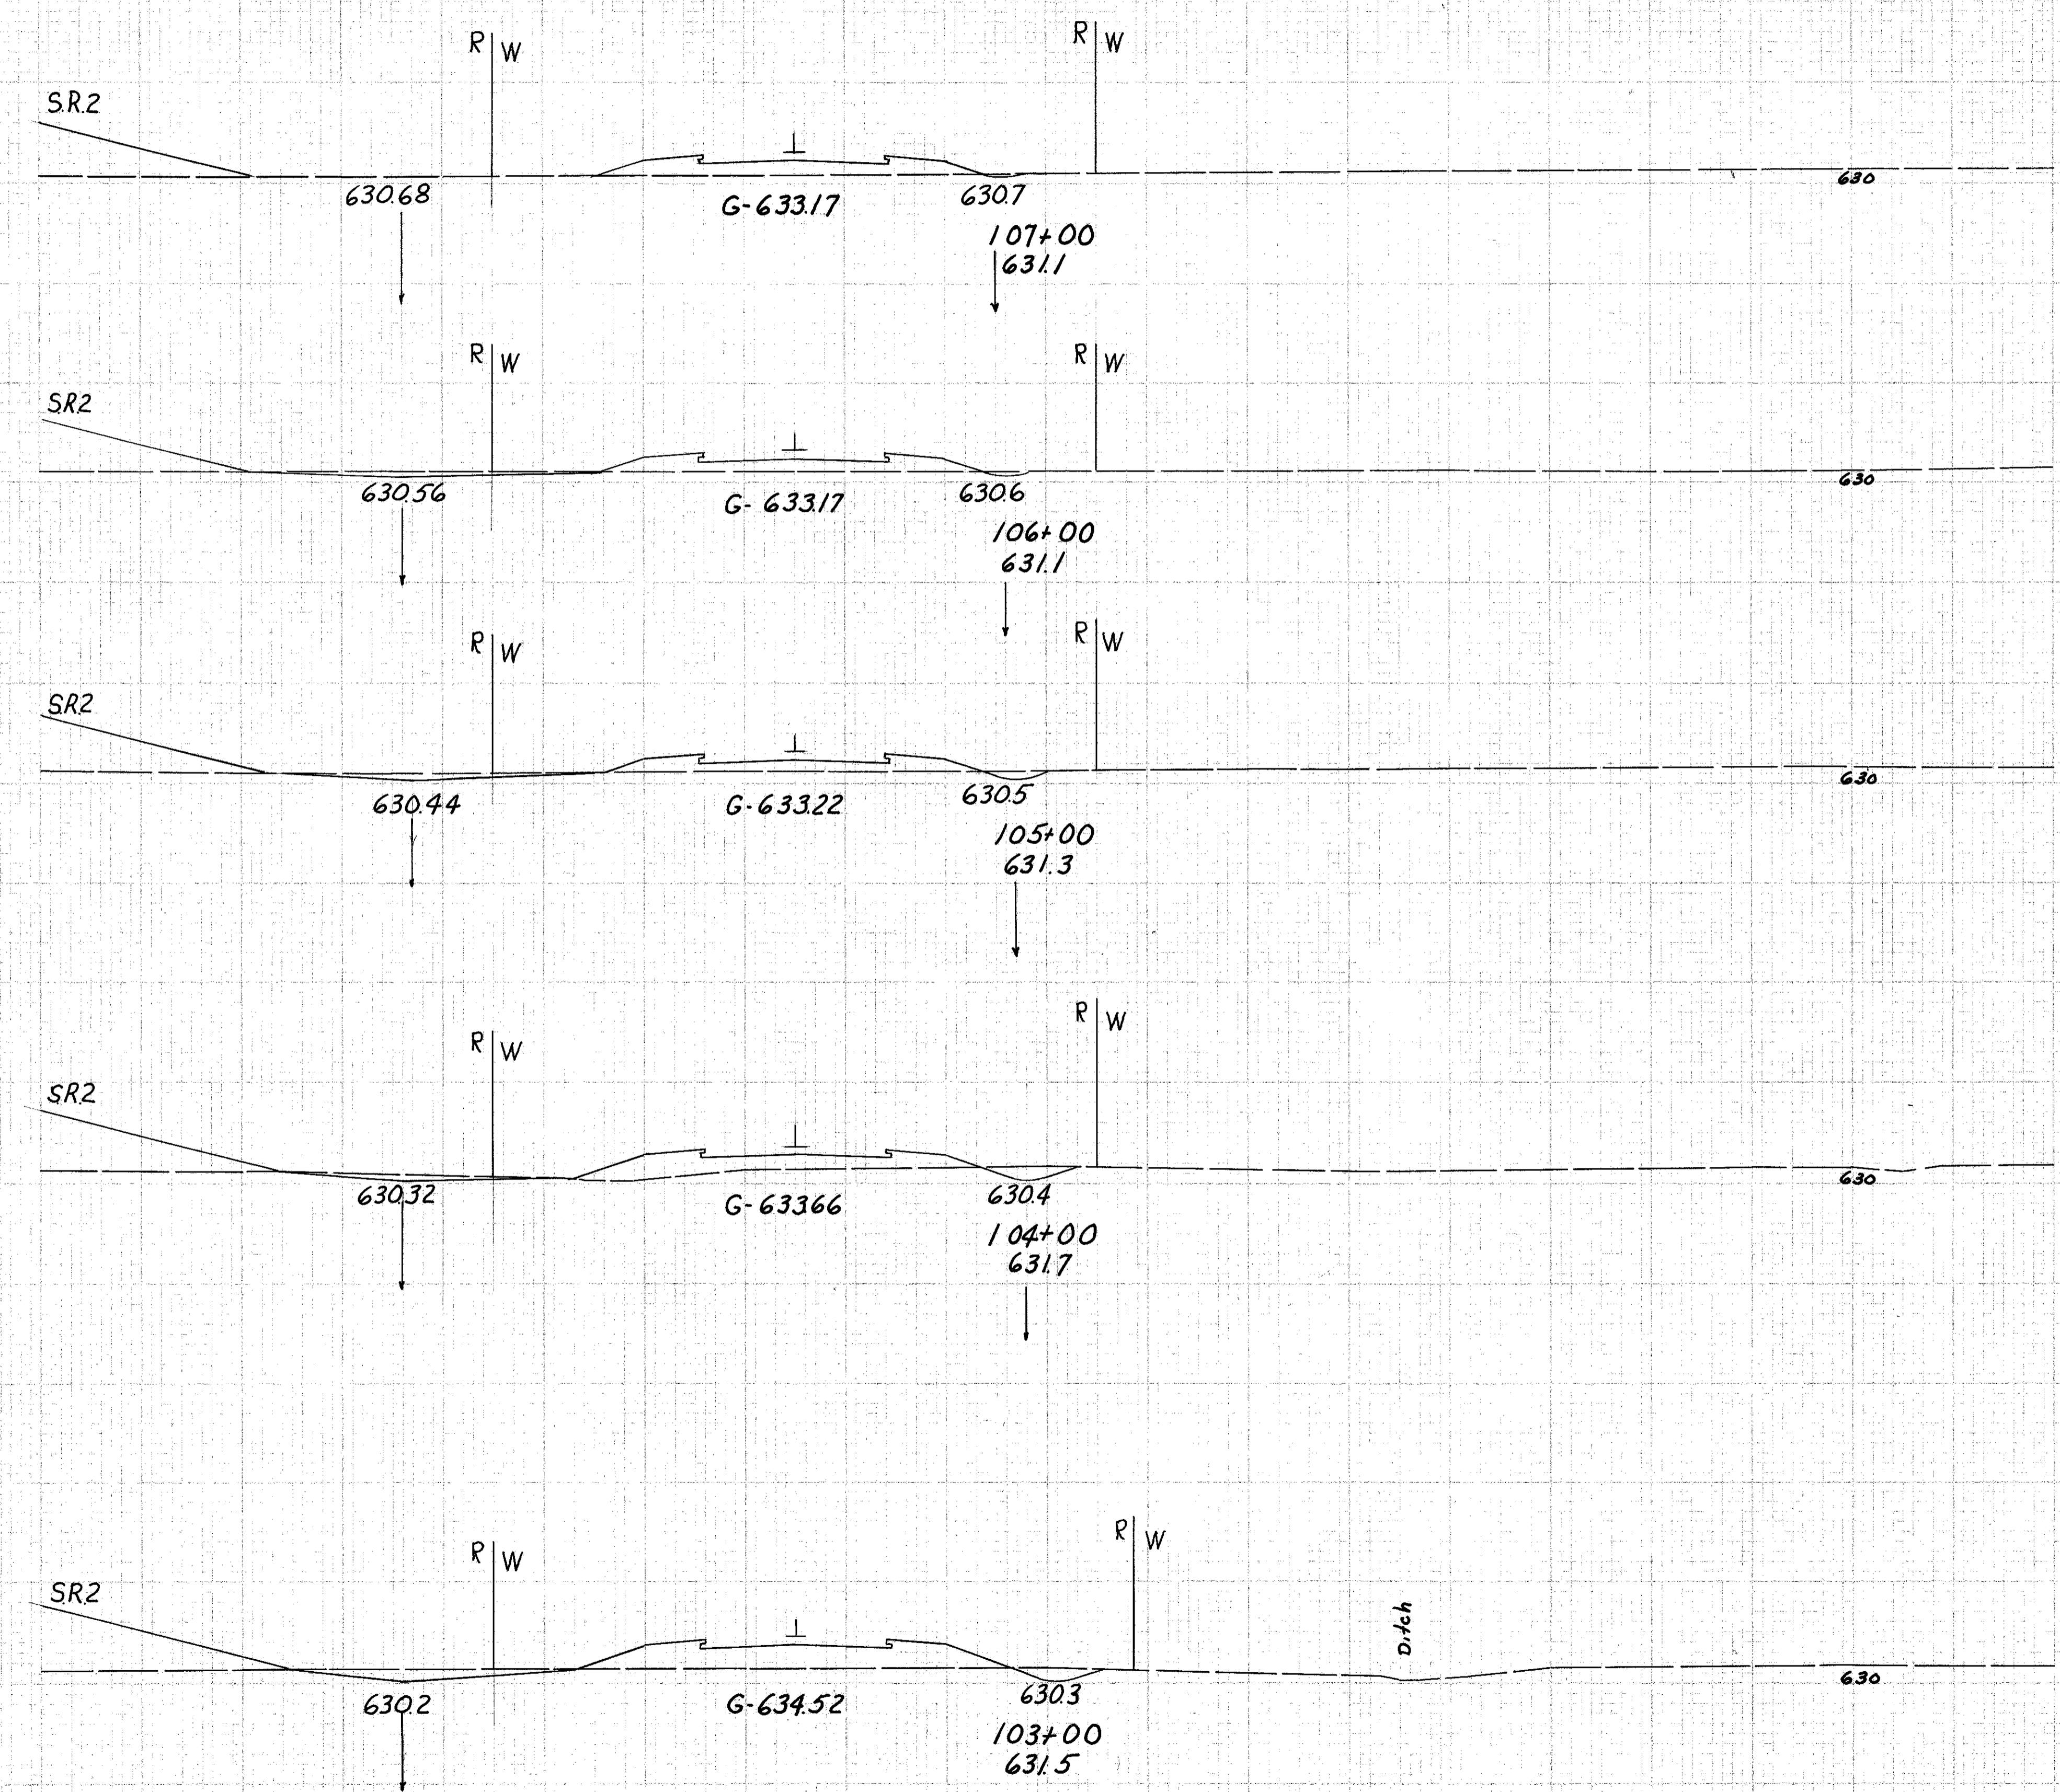

Sta. 102+00

Sta. 102+00

Rev. 11-14-58

Relocated Vine Street Sta. 103+00 to 107+00