

SEEDING
END SO.
WIDTH YDS.

140 120 100 80 60 40 20 0 20 40 60 80 100

Constr. Survey

PROJ. NO.	STATE	PROJECT
2	OHIO	F-329(16)


106
268

LAKE COUNTY
LAK-2-739
REV 11-14-58

This sheet replaces
Sheet No. 106 of the
original plans.

END AREA Cu. YDS.
CUT FILL CUT FILL

41
456
41
433
37
428
40
422
36
422
40

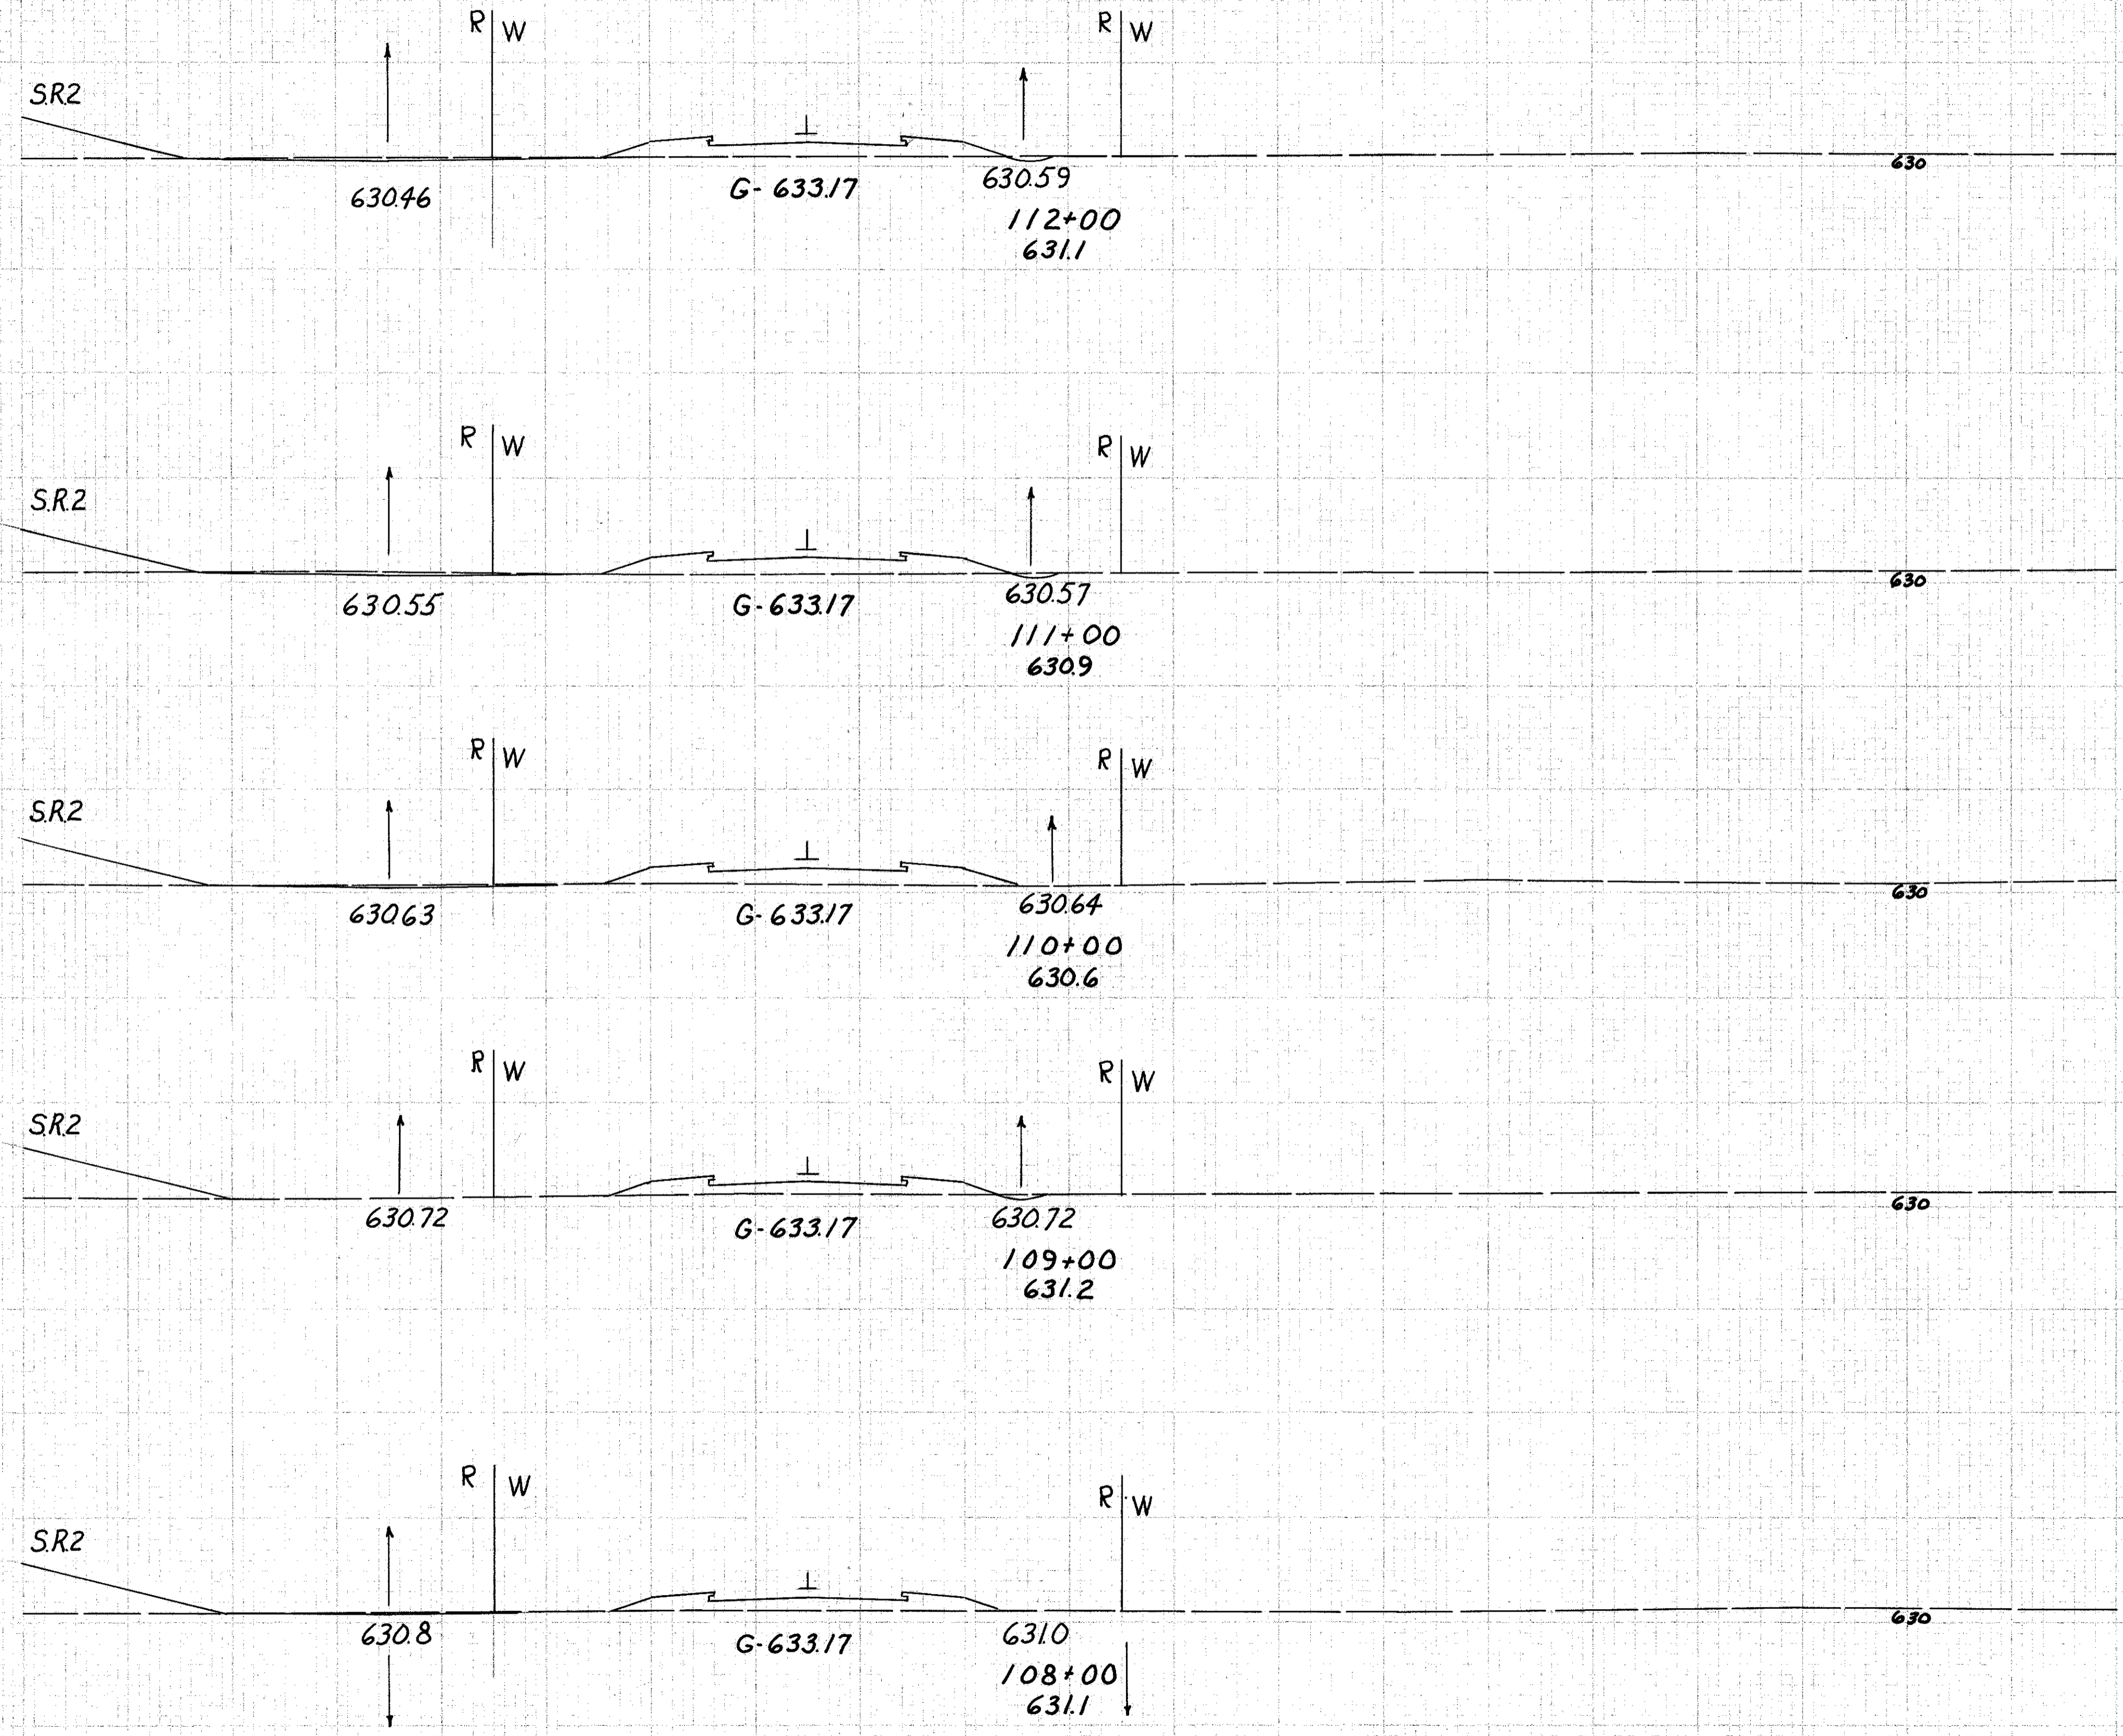

4	47		
		13	189
3	55		
		7	204
1	55		
		4	176
1	40		
		4	148
1	40		
		4	167
1	50		

Sta 107+00

Sta. 107+00

140 120 100 80 60 40 20 0 20 40 60 80 100

Rev 11-14-58

Relocated Vine Street Sta. 108+00 to 112+00