

SEEDING  
END SQ.  
WIDTH YDS.

140 120 100 80 60 40 20 0 20 40 60 80 100

Constn  
20  
Survey  
2


REV. NO.	STATE	PROJECT
2	OHIO	F-329(16)

107  
268

LAKE COUNTY  
Lak-2-739  
REV. 11-4-58

120 140  
This sheet replaces  
Sheet No. 107 of the  
original plans.

END AREA	CUT	FILL	CUT	FILL
----------	-----	------	-----	------

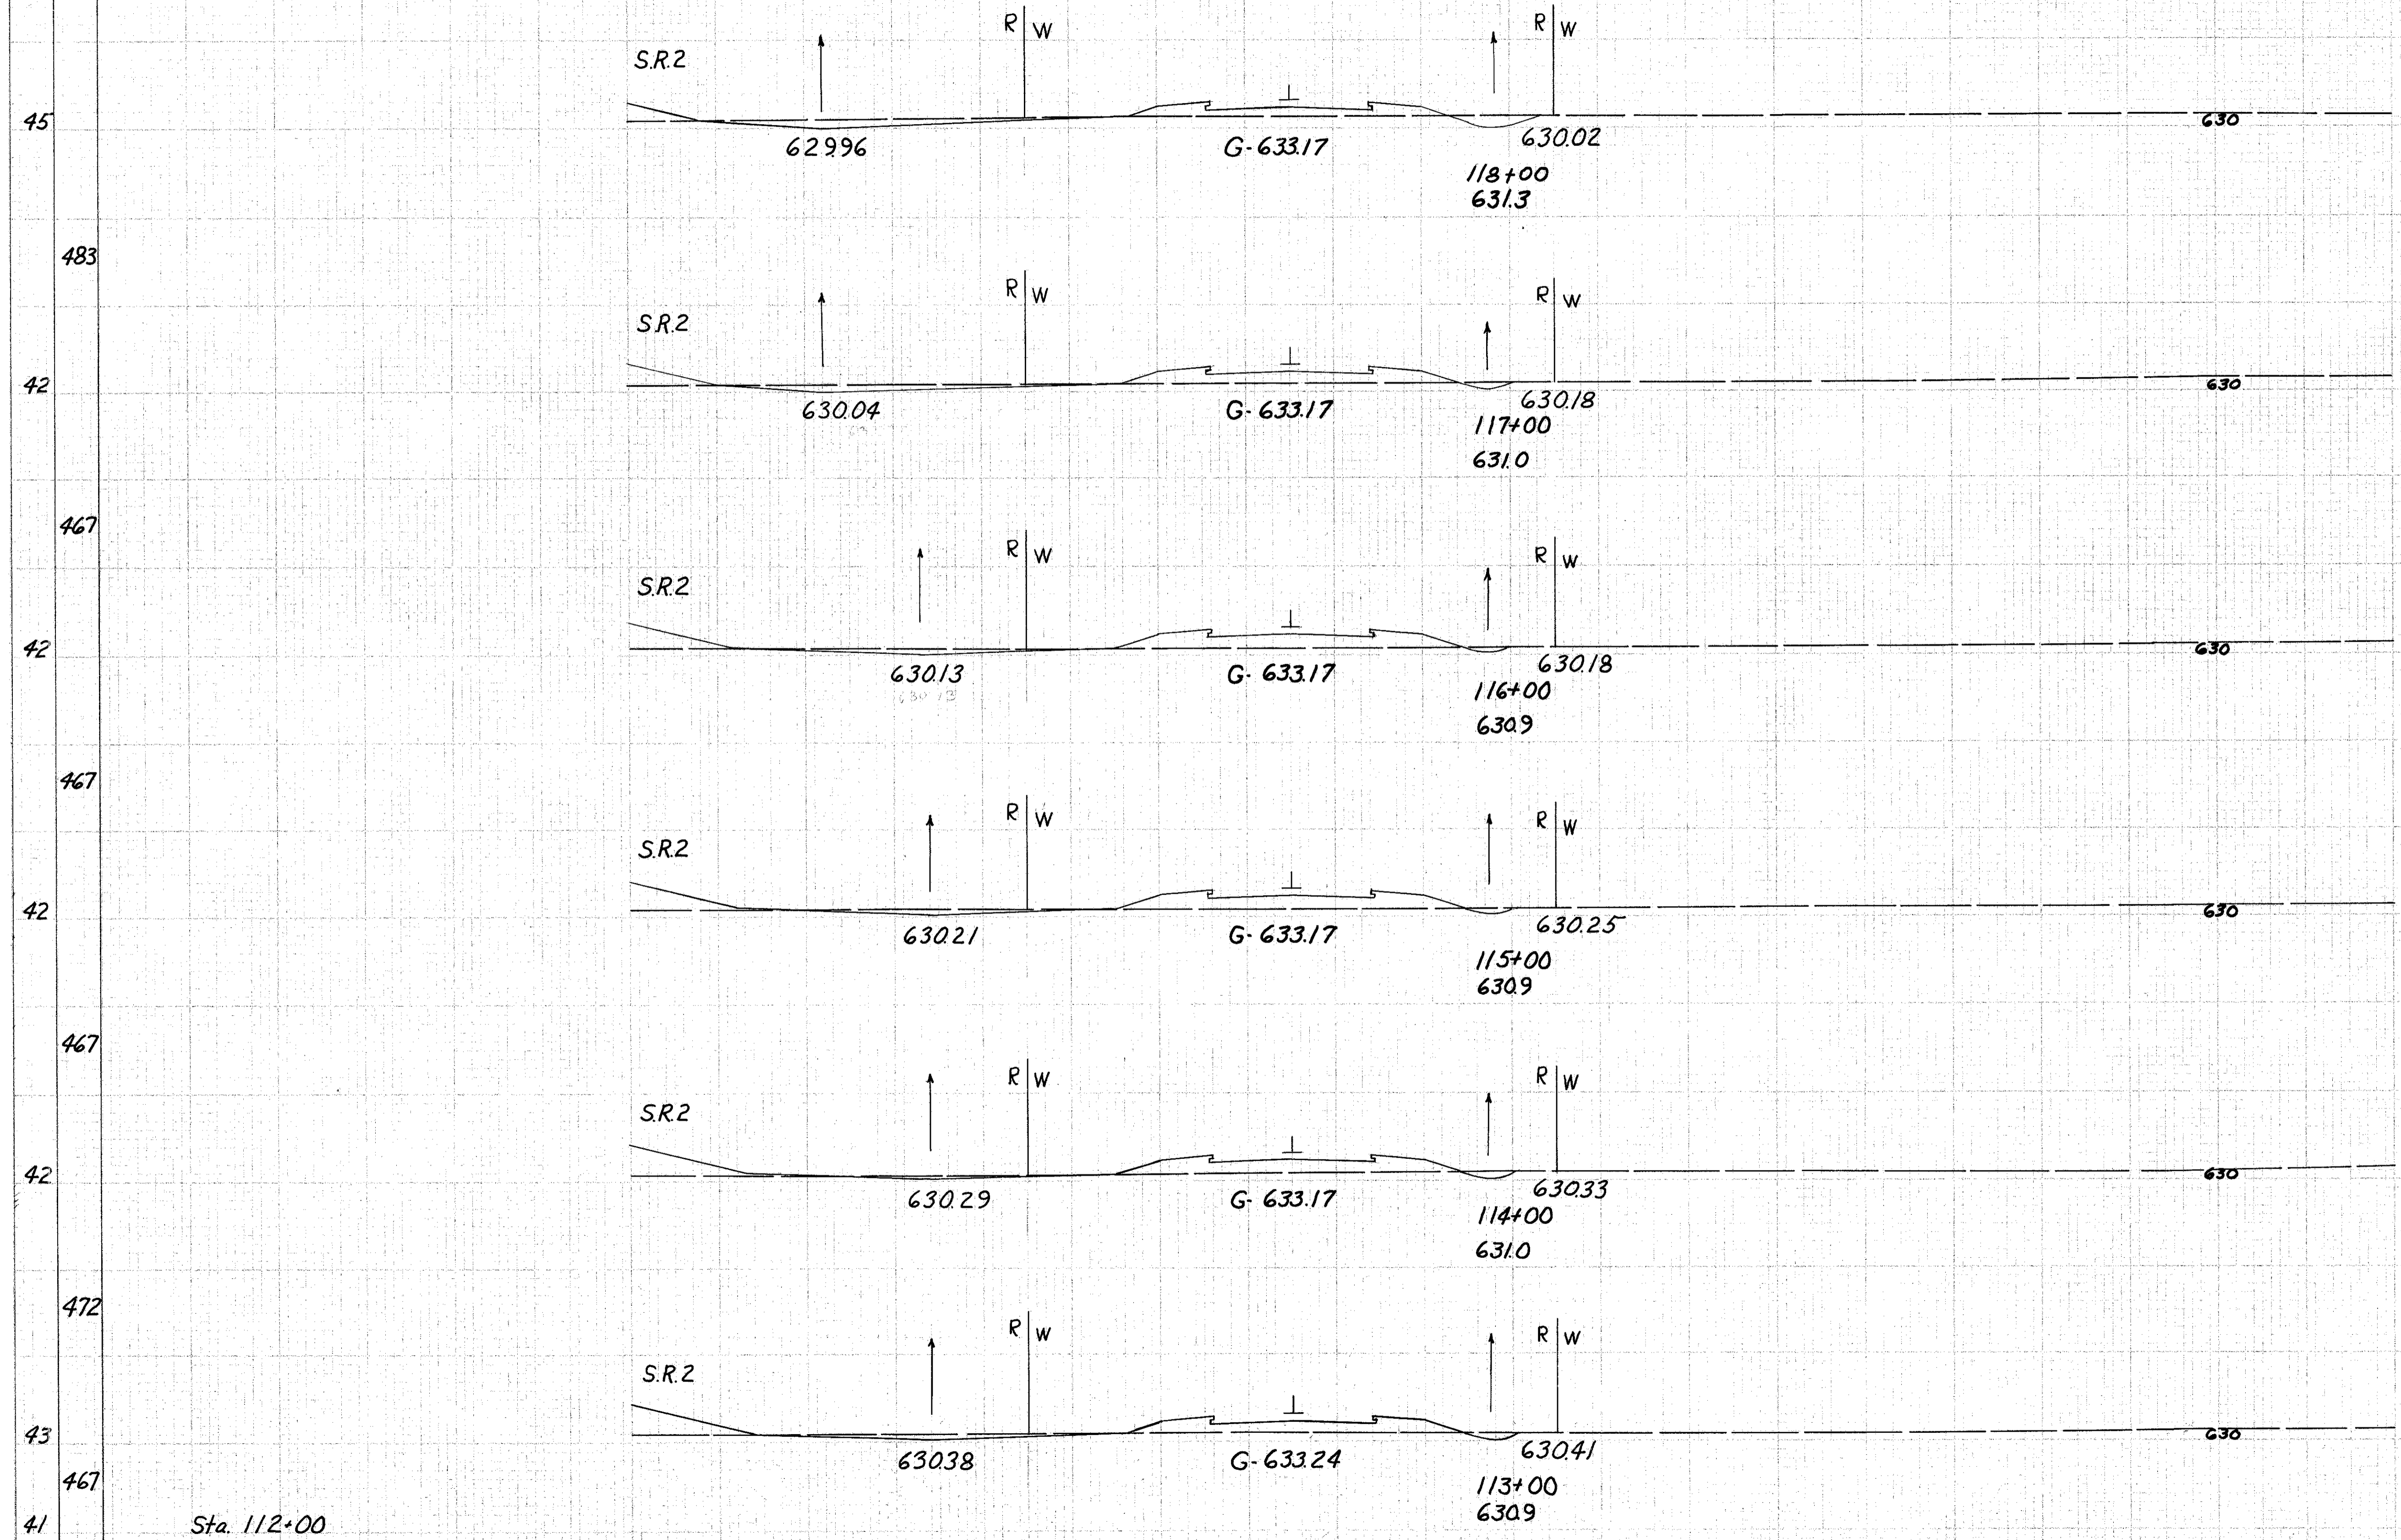

END AREA	CUT	FILL	CUT	FILL
9	33			
		24	152	
4	49			
		13	196	
3	57			
		11	209	
3	56			
		13	204	
4	54			
		15	185	
4	46			
		11	207	
2	66			

Sta. 112+00

Sta. 112+00

Rev. 11-17-51

Relocated Vine Street Sta. 113+00 to 118+00