

SEEDING  
END SQ.  
WIDTH YDS.

140 120 100 80 60 40 20 0 20 40 60 80 100

Const. Survey


PROJECT NUMBER	STATE	NUMBER
2	OHIO	F-329(16)

108  
268

LAKE COUNTY  
LAK-2-739  
REV 11-4-58

This sheet replaces  
Sheet No. 108 of the  
original plans.

45  
500  
45  
506  
46  
500  
44  
489  
44  
511  
48  
517  
45

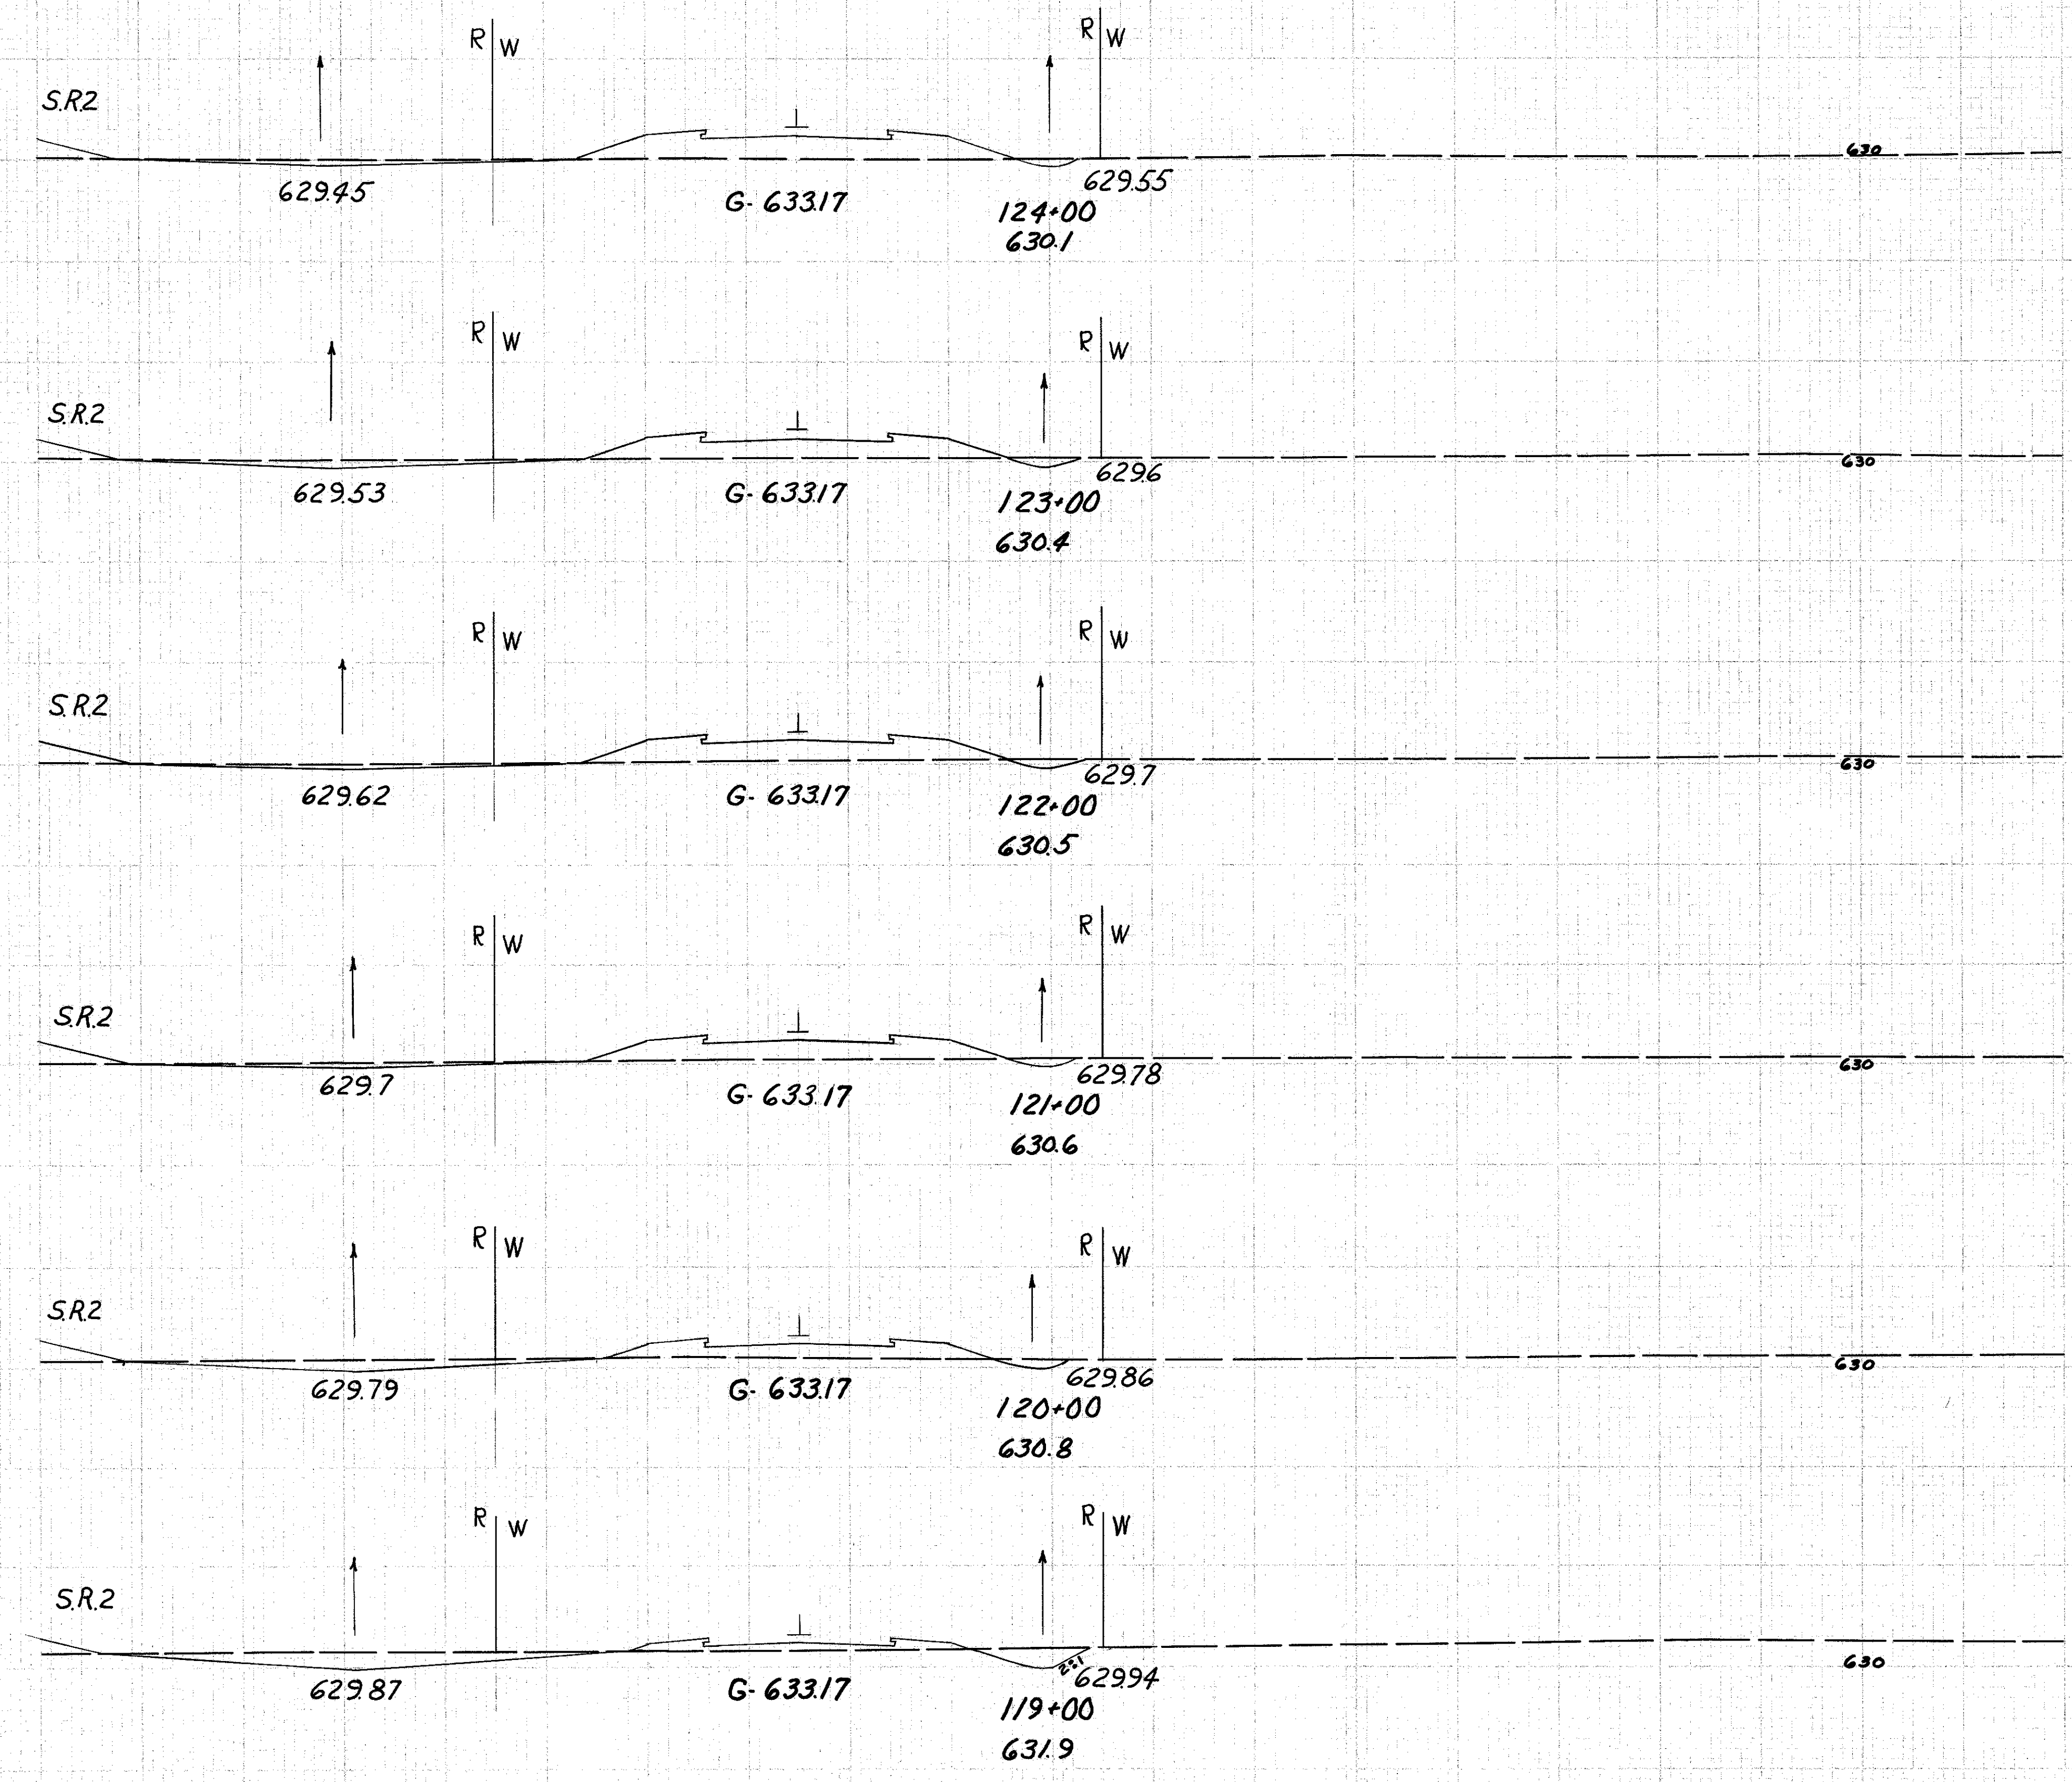

END STA.	AREA		Cu. Yds.	
	Cut	Fill	Cut	Fill
3	83			
5	72			15 287
4	74			17 270
4	69			15 265
7	47			20 215
20	23			50 130
9	33			54 104

Sta. 118+00

Sta. 118+00

Rev. 11-14-58

Relocated Vine Street Sta. 119+00 to 124+00