

SEEDING
END SQ.
WIDTH YDS.


140 120 100 80 60 40 20 0 20 40 60 80 100

NO.	STATE	PROJECT
2	OHIO	F 329 (16)

109
268

LAKE COUNTY
LAK-2-739
REV. 11-14-58

This sheet replaces
Sheet No. 109 of the
original plans.

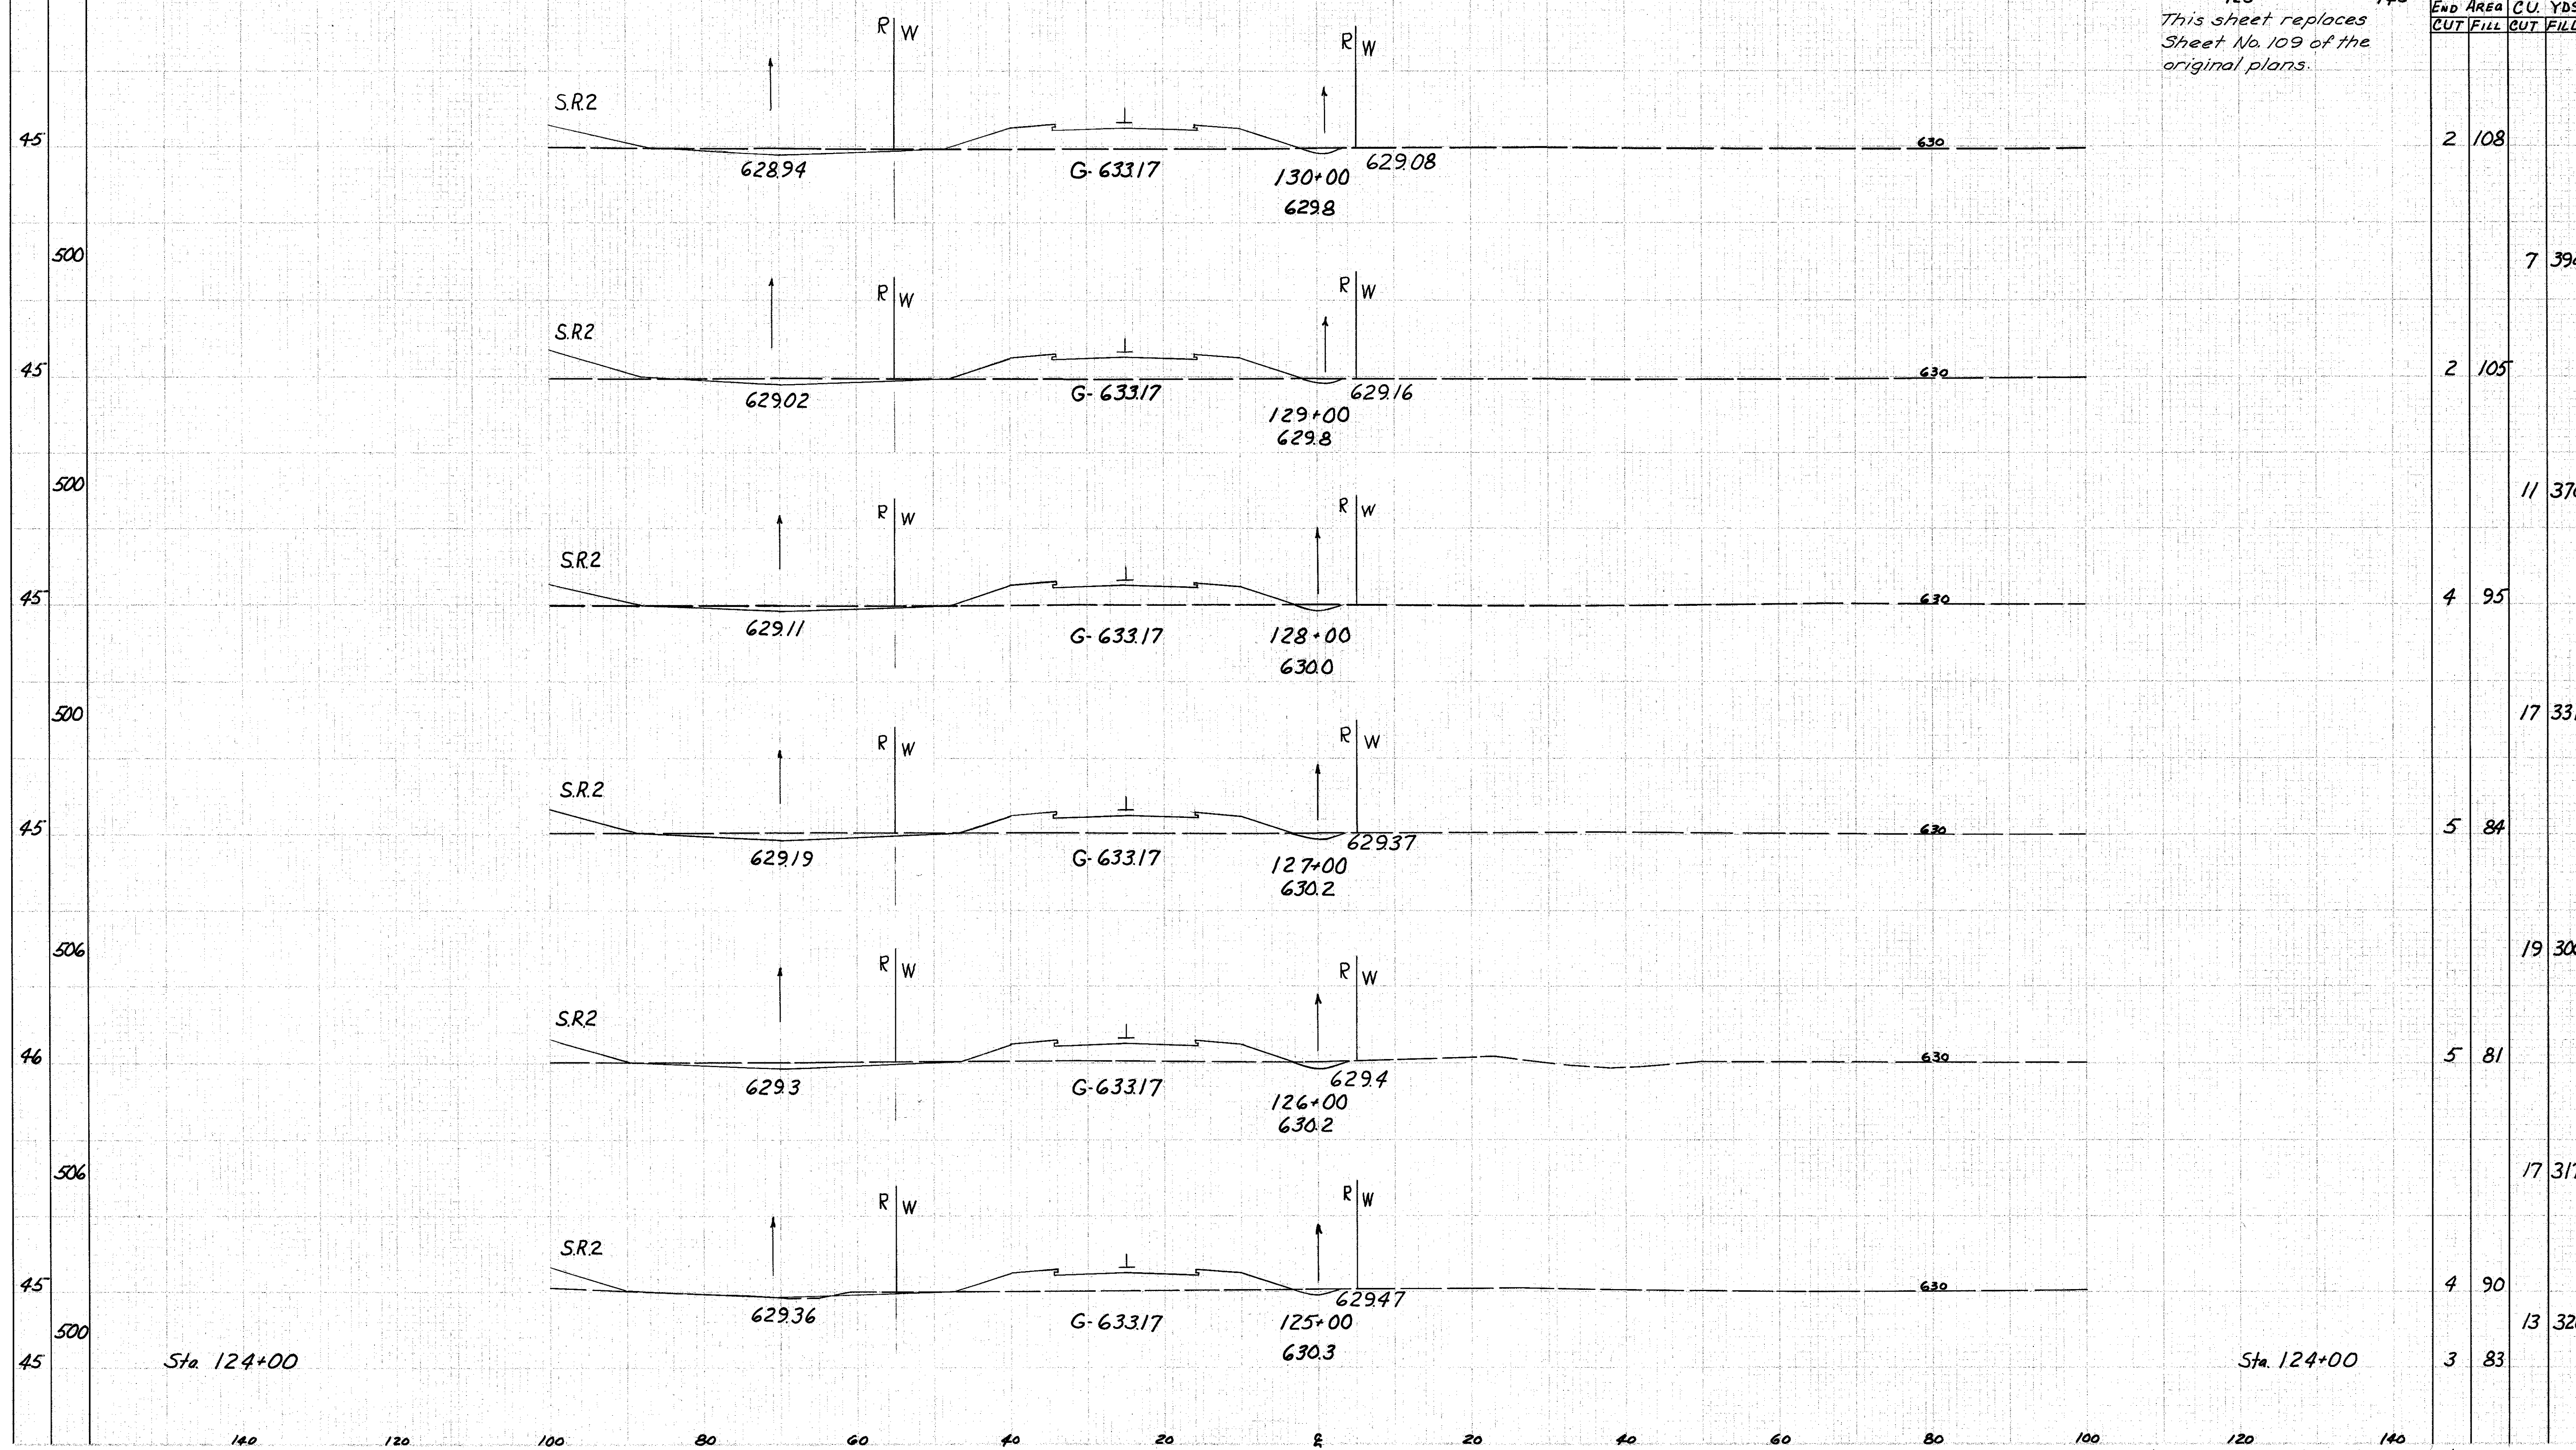

END STA.	AREA		CU. YDS.	
	CUT	FILL	CUT	FILL
130+00	2	108		
129+00			7	394
128+00	2	105		
127+00			11	370
126+00	4	95		
125+00			17	331
124+00	5	84		
123+00			19	306
122+00	5	81		
121+00			17	317
120+00	4	90		
119+00			13	320
118+00	3	83		

Sta. 124+00

Sta. 124+00

Rev. 11-14-58

Relocated Vine Street Sta. 125+00 to 130+00