

SEEDING	END	Se.
Width	Yds.	
51		
600		
57		
628		
55		
583		
50		
539		
47		
511		
45		
500		
45		

140 120 100 80 60 40 20 0 20 40 60 80 100


Const'n Survey

2	OHIO	F-329(16)	110 268
---	------	-----------	------------

LAKE COUNTY
LAK-2-739
REV. 11-14-58

This sheet replaces
Sheet No. 110 of the
original plans.

Sta.	AREA		CU. YDS.	
	CUT	FILL	CUT	FILL
2	224			
9		933		
3	280			
17		926		
6	220			
17		657		
3	135			
11		437		
3	101			
9		374		
2	101			
7		387		
2	108			

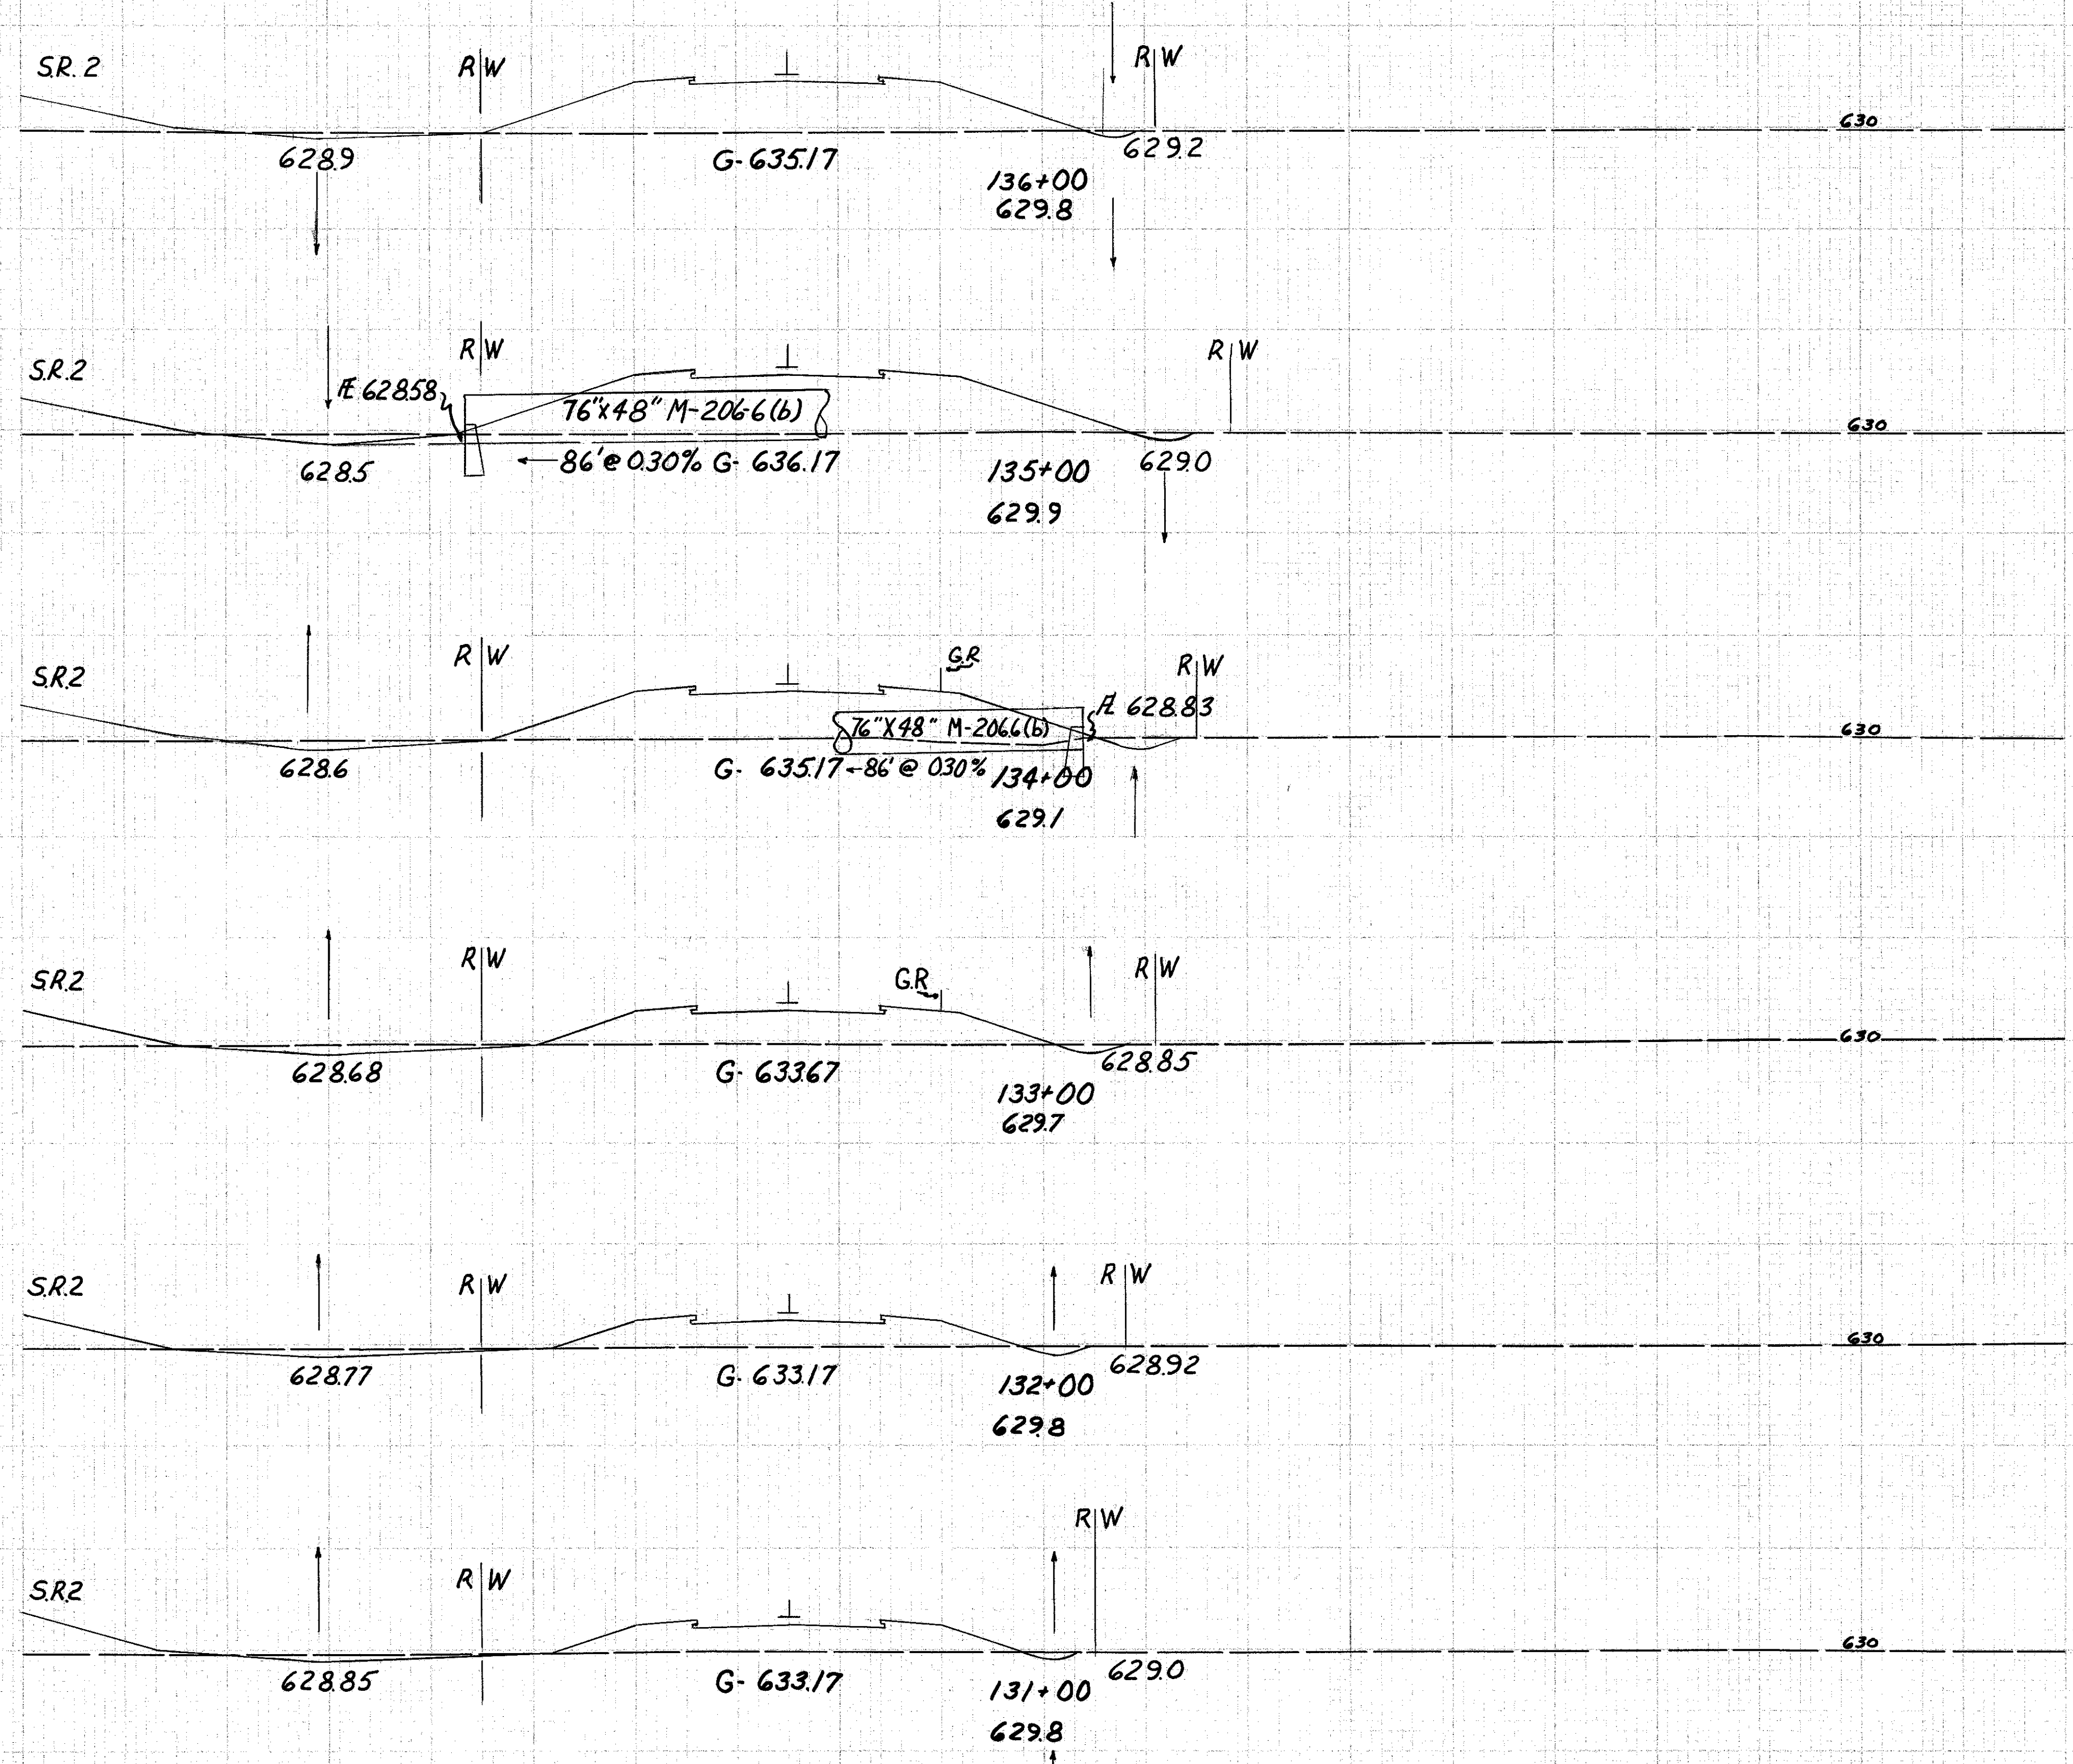

Sta. 130+00

Sta. 130+00

Rev. 11-14-51

Relocated Vine Street Sta. 131+00 to 136+00