

SEEDING
END SQ.
WIDTH YDS.

140 120 100 80 60 40 20 0 20 40 60 80 100


Const. & 20
Survey &

FED. RD. DISTRICT	STATE	PROJECT	111 268
2	OHIO	F-329(16)	

LAKE COUNTY
LAK-2-739
REV. 11-14-58

120 140
This sheet replaces
Sheet No. 111 of the
original plans.

END AREA	Cu. Yds.
CUT	FILL

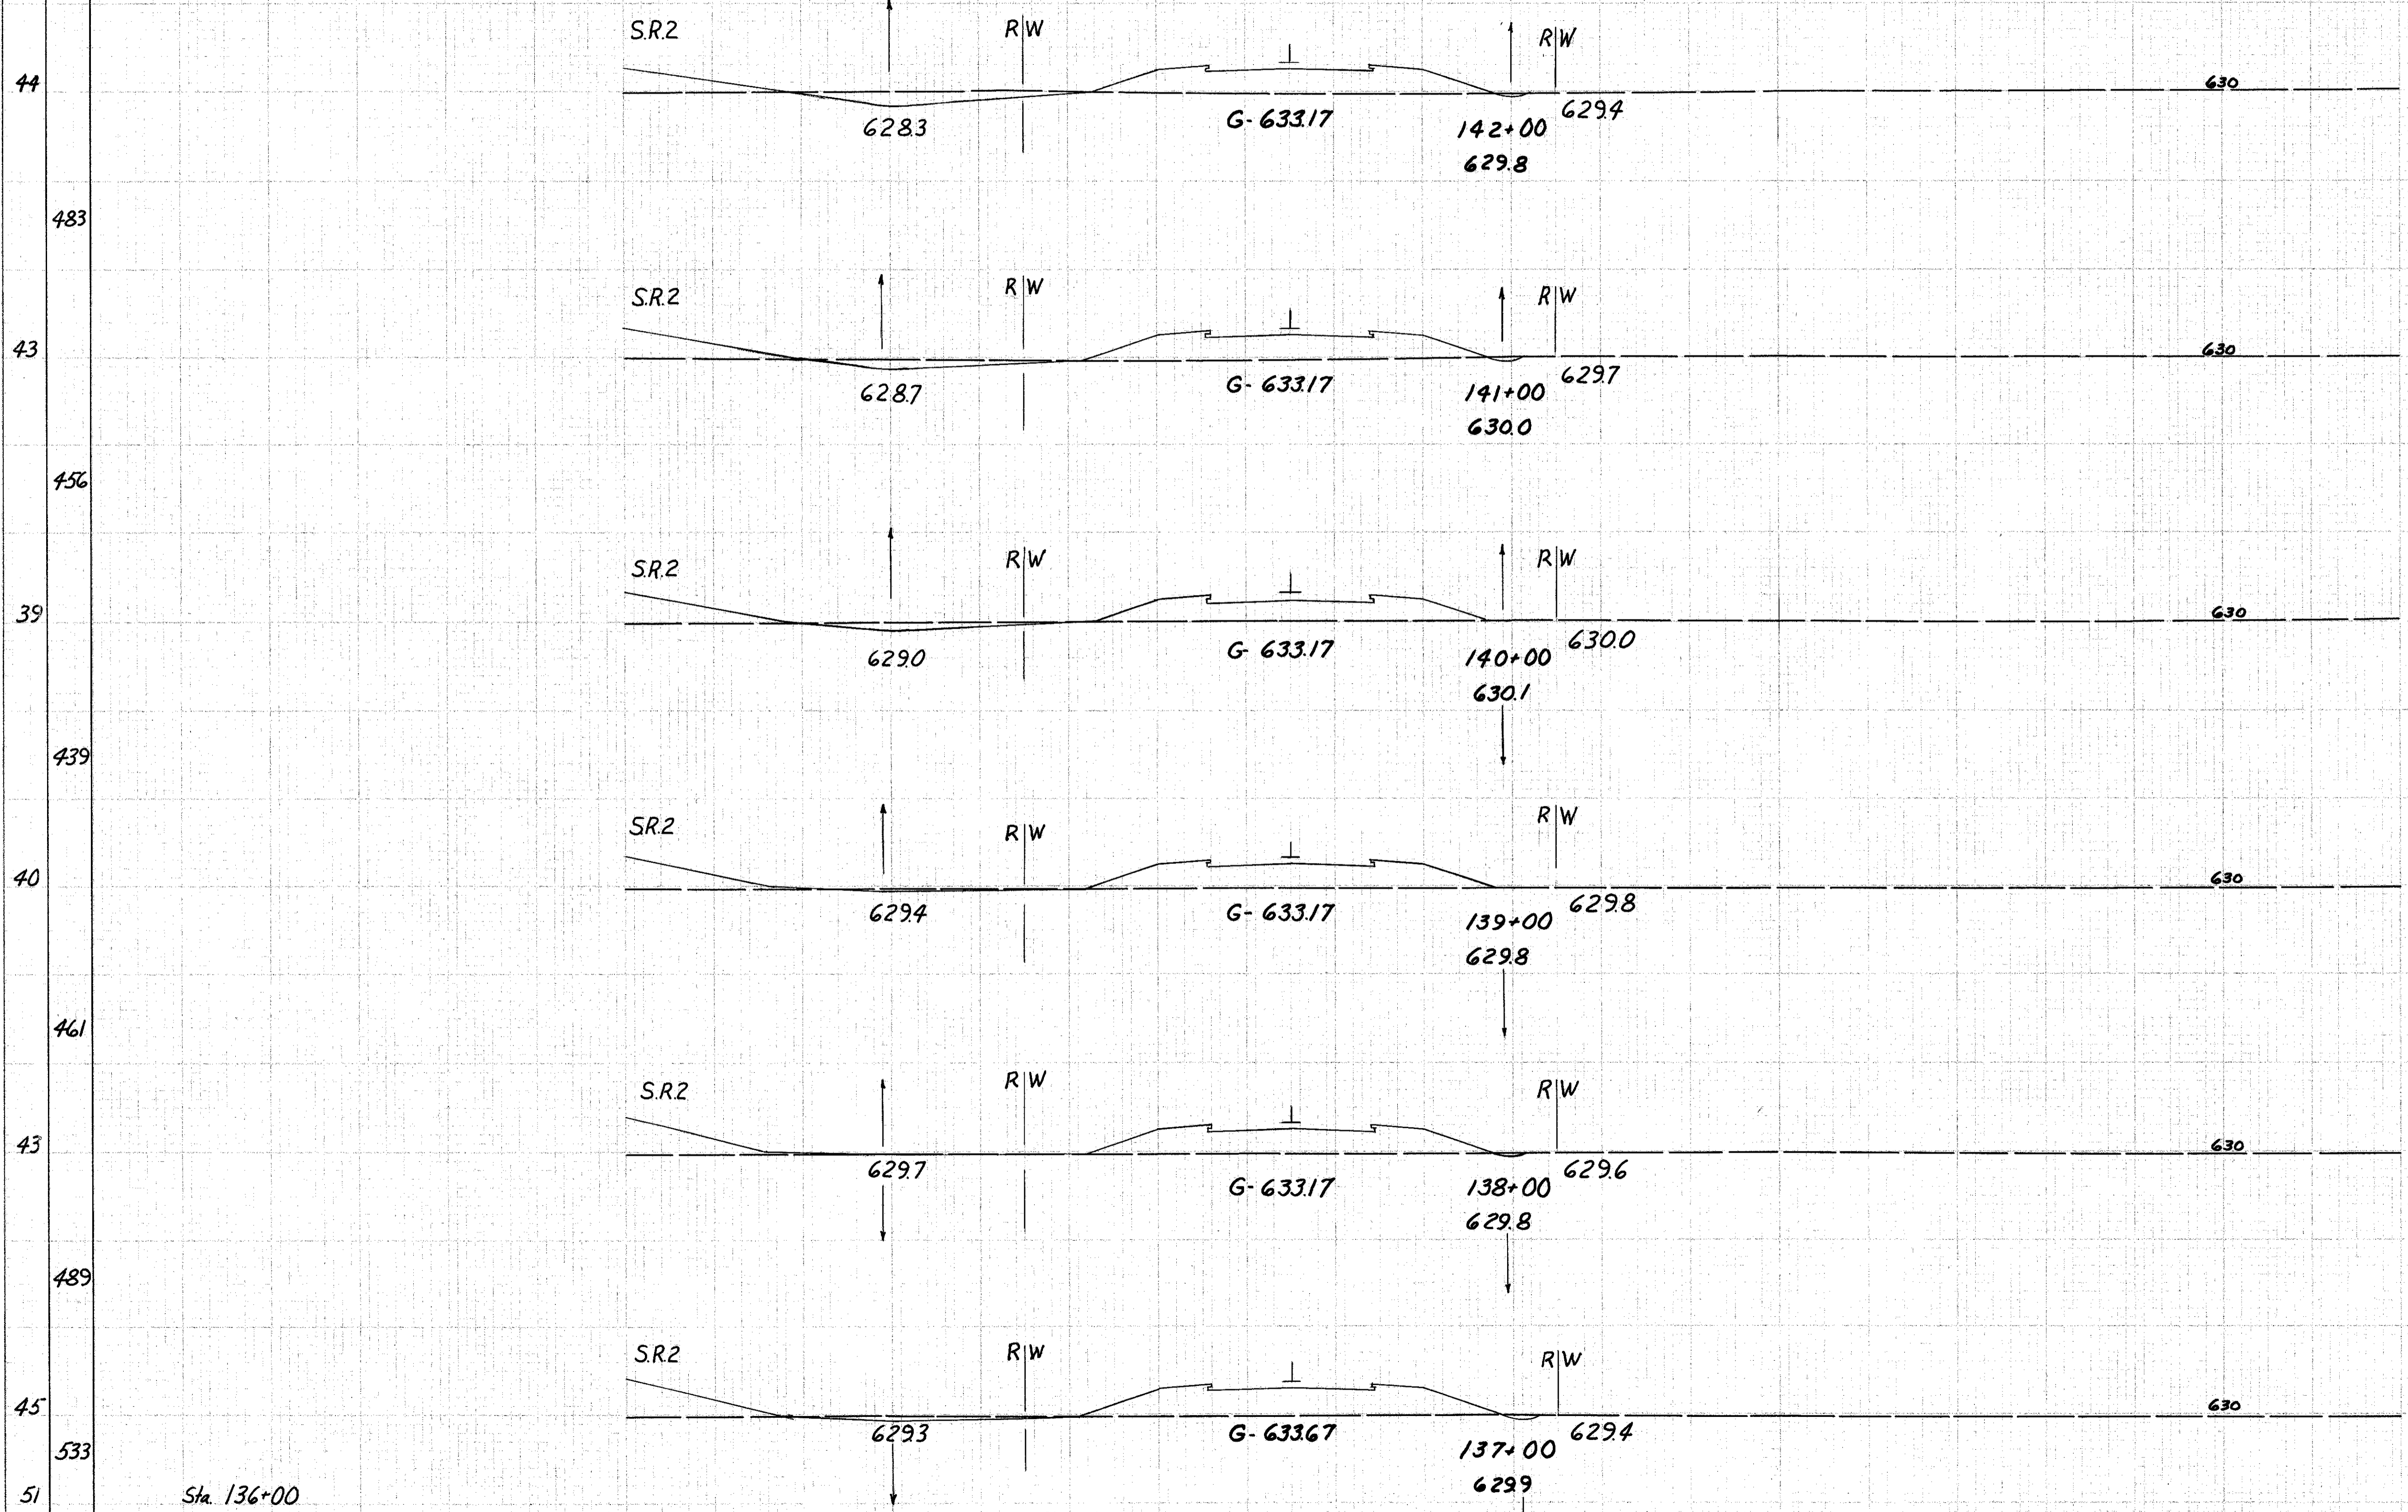

END AREA	Cu. Yds.
CUT	FILL
2	104
	7 389
2	106
	4 365
0	91
	359
0	103
	2 385
1	105
	4 422
1	123
	6 643
2	224

Sta. 136+00

Sta. 136+00

Rev. 11-14-58

Relocated Vine Street Sta. 137+00 to 142+00