


SEEDING
END SQ.
WIDTH YDS.

PROJ. NO.	STATE	PROJECT
2	OHIO	F-329 (16)

112
268

LAKE COUNTY
LAK-2-739
REV. 11-4-58

This sheet replaces
Sheet No. 112 of the
original plans.

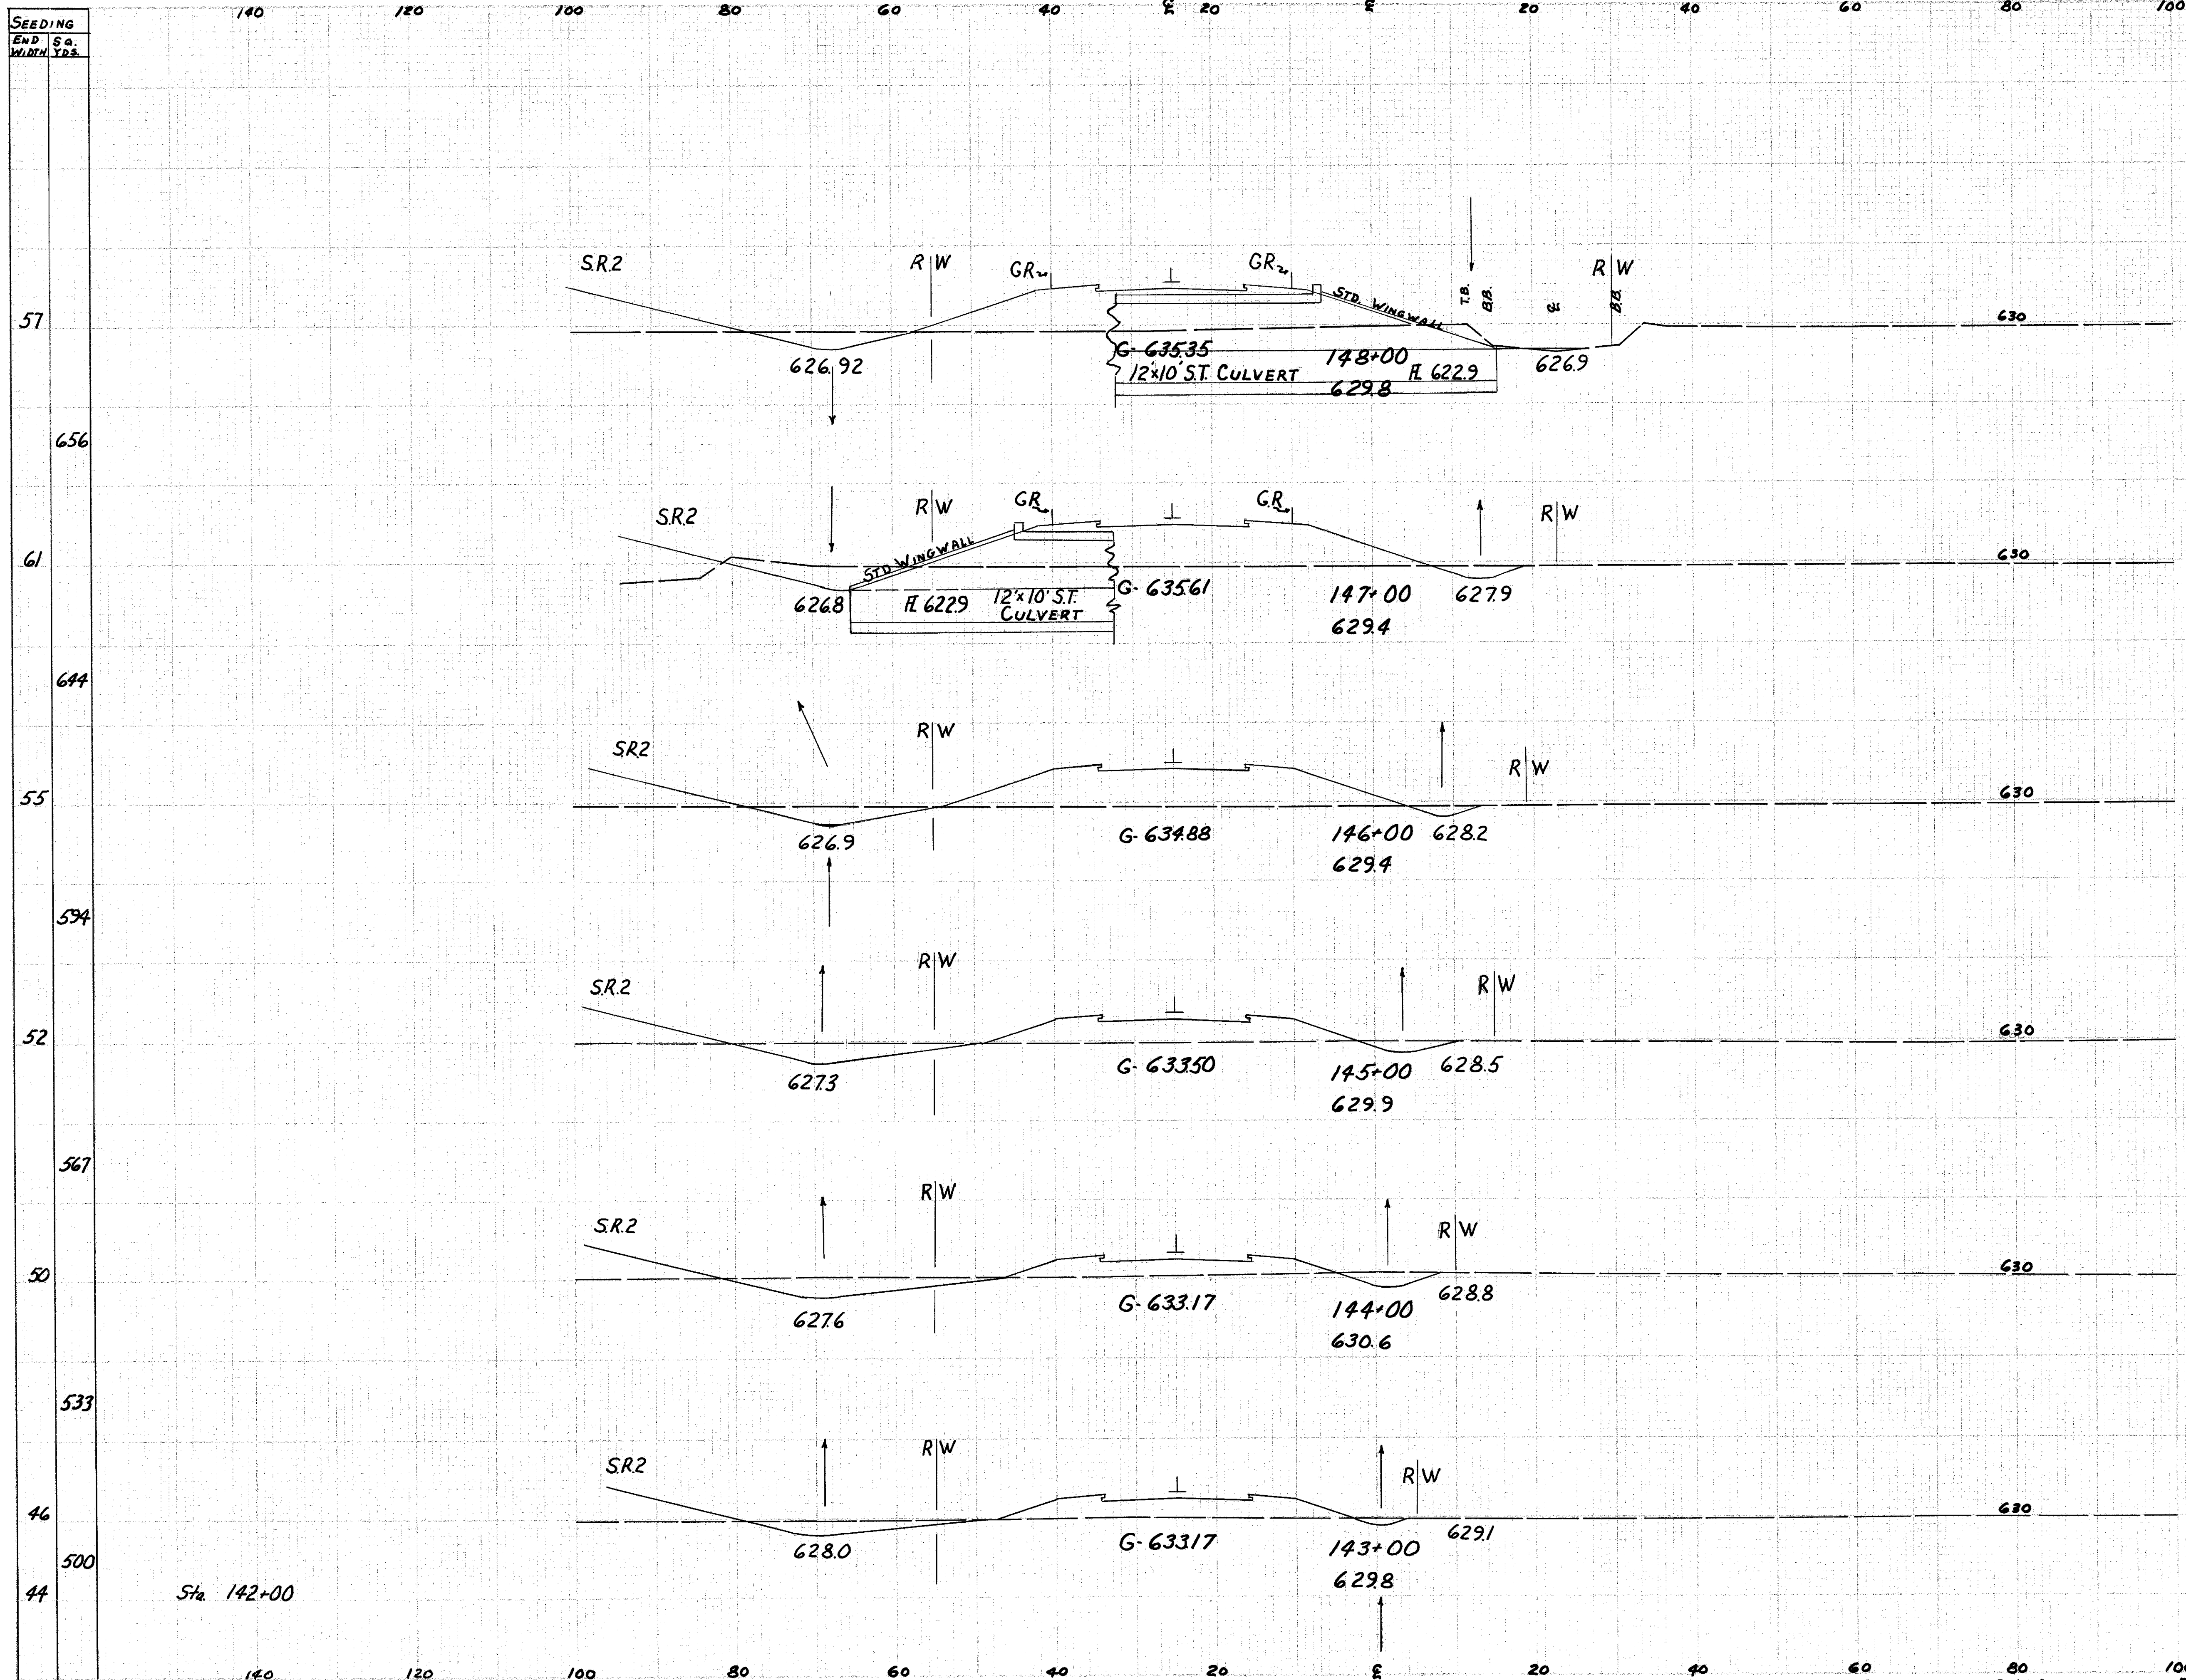

END STA.	AREA		CU. YDS.	
	CUT	FILL	CUT	FILL
142+00	0	243		
143+00			22	920
144+00	12	254		
145+00			35	867
146+00	7	214		
147+00			35	606
148+00	12	113		
149+00			56	350
150+00	18	76		
151+00			43	311
152+00	5	92		
153+00			13	363
154+00	2	104		

Rev. 11-17-58

Relocated Vine Street Sta. 143+00 to 148+00