

9-5


F-12

SEEDING	Sq.
END	YDS.

DATE	SCALE	PROJECT	118
2	CHIC	F-329 (16)	268

LAKE COUNTY
LAK-2-739
REV 11-4-58

NOTE:
This sheet replaces
Sheet No. 118 of the
original plans.

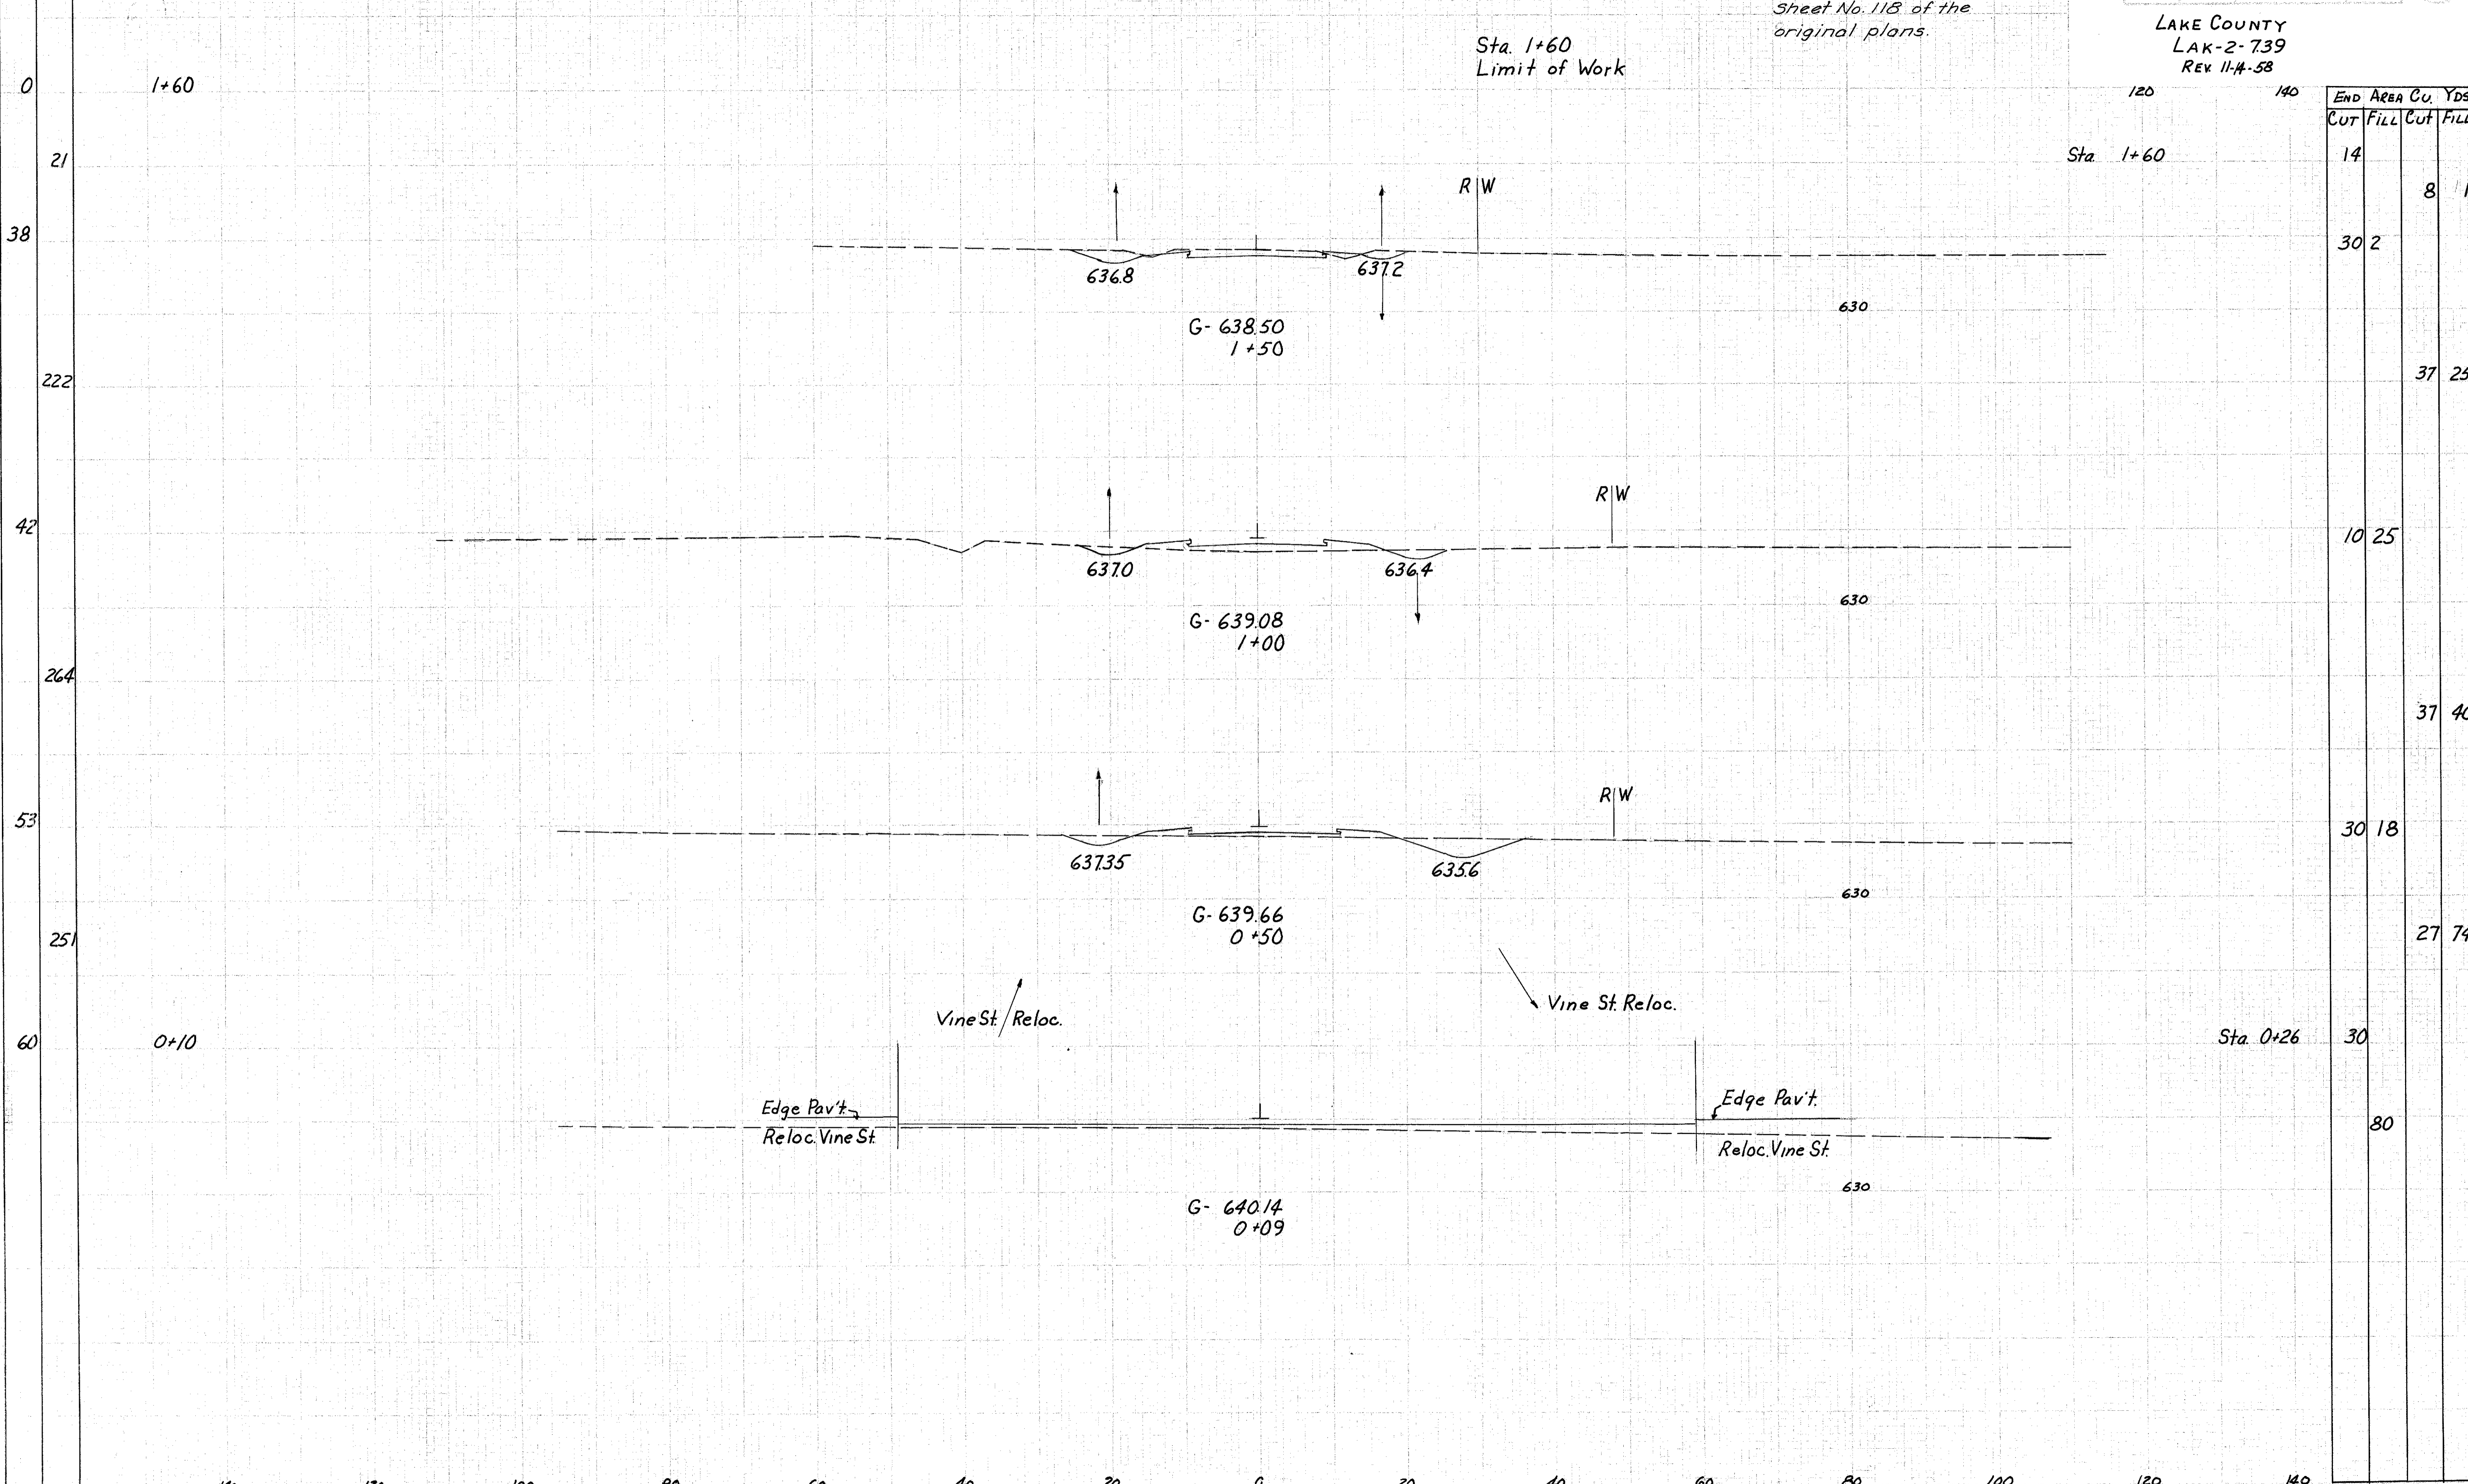

END STA.	AREA		CU. YDS.	
	CUT	FILL	CUT	FILL
14			8	1
30	2			
37			25	
42	10		25	
53			40	
60	30		18	
74			74	
80				

Sta. 1+60
Limit of Work

Sta. 1+60

Sta. 0+26

Reloc. Clover Ave. Sta. 0+09 to 1+50

Rev. 11-19-58