


SEEDING
END WIDTH
SR YDS.

PER. NO. 2
STATE OHIO
PROJECT NO. F-329(16)

128
268

LAKE COUNTY
LAK-2-7.39

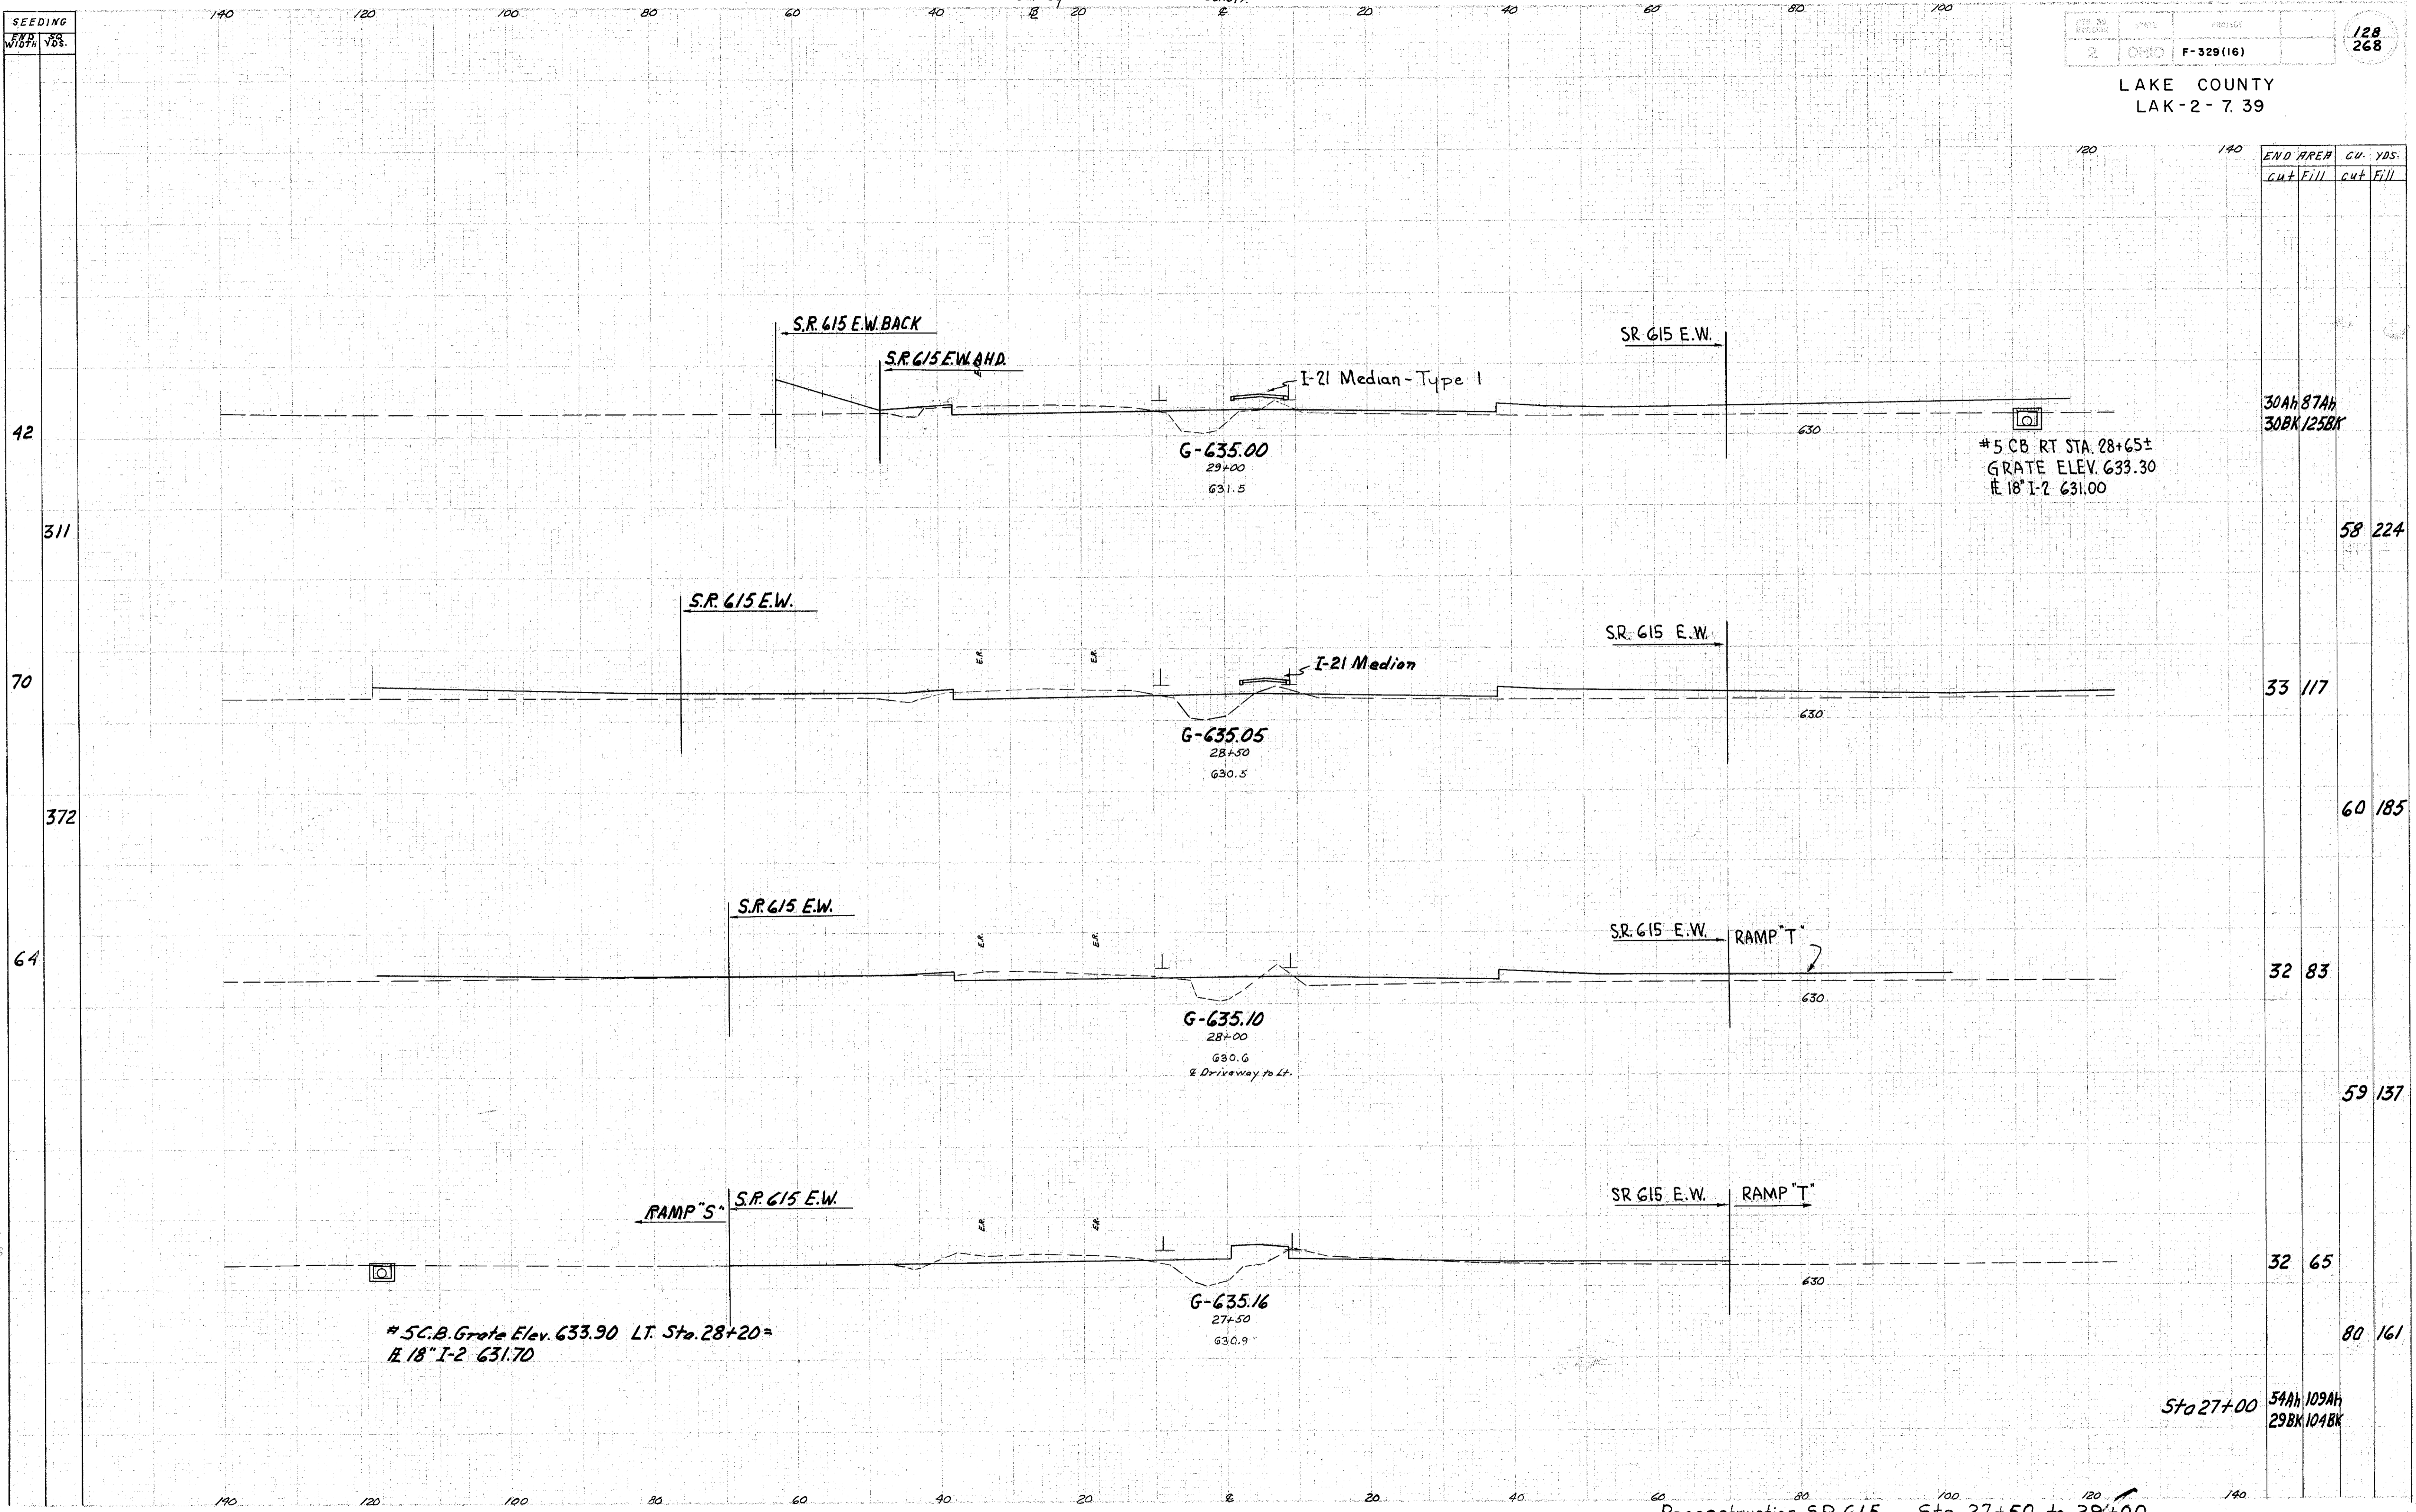

END AREA		CU. YDS.	
Cut	Fill	Cut	Fill
30Ah	87Ah		
30Bk	125Bk		
		58	224
		33	117
		60	185
		32	83
		59	137
		32	65
		80	161
		54Ah	109Ah
		29Bk	104Bk

Plans for 3/25/58
DM 9-17-58
Revised Grade C.
2.4.58
V.D.F. - 6-23-58
R. on - 9/1/58

5 C.B. Grate Elev. 633.90 LT. Sta. 28+20±
E 18" I-2 631.70

Sta 27+00
54Ah 109Ah
29Bk 104Bk

Reconstruction SR 615 Sta. 27+50 to 29+00