


SEEDING
FERTILIZER

PROJECT NO. F-329 (16)

183
268

LAKE COUNTY
LAK-2-7.39

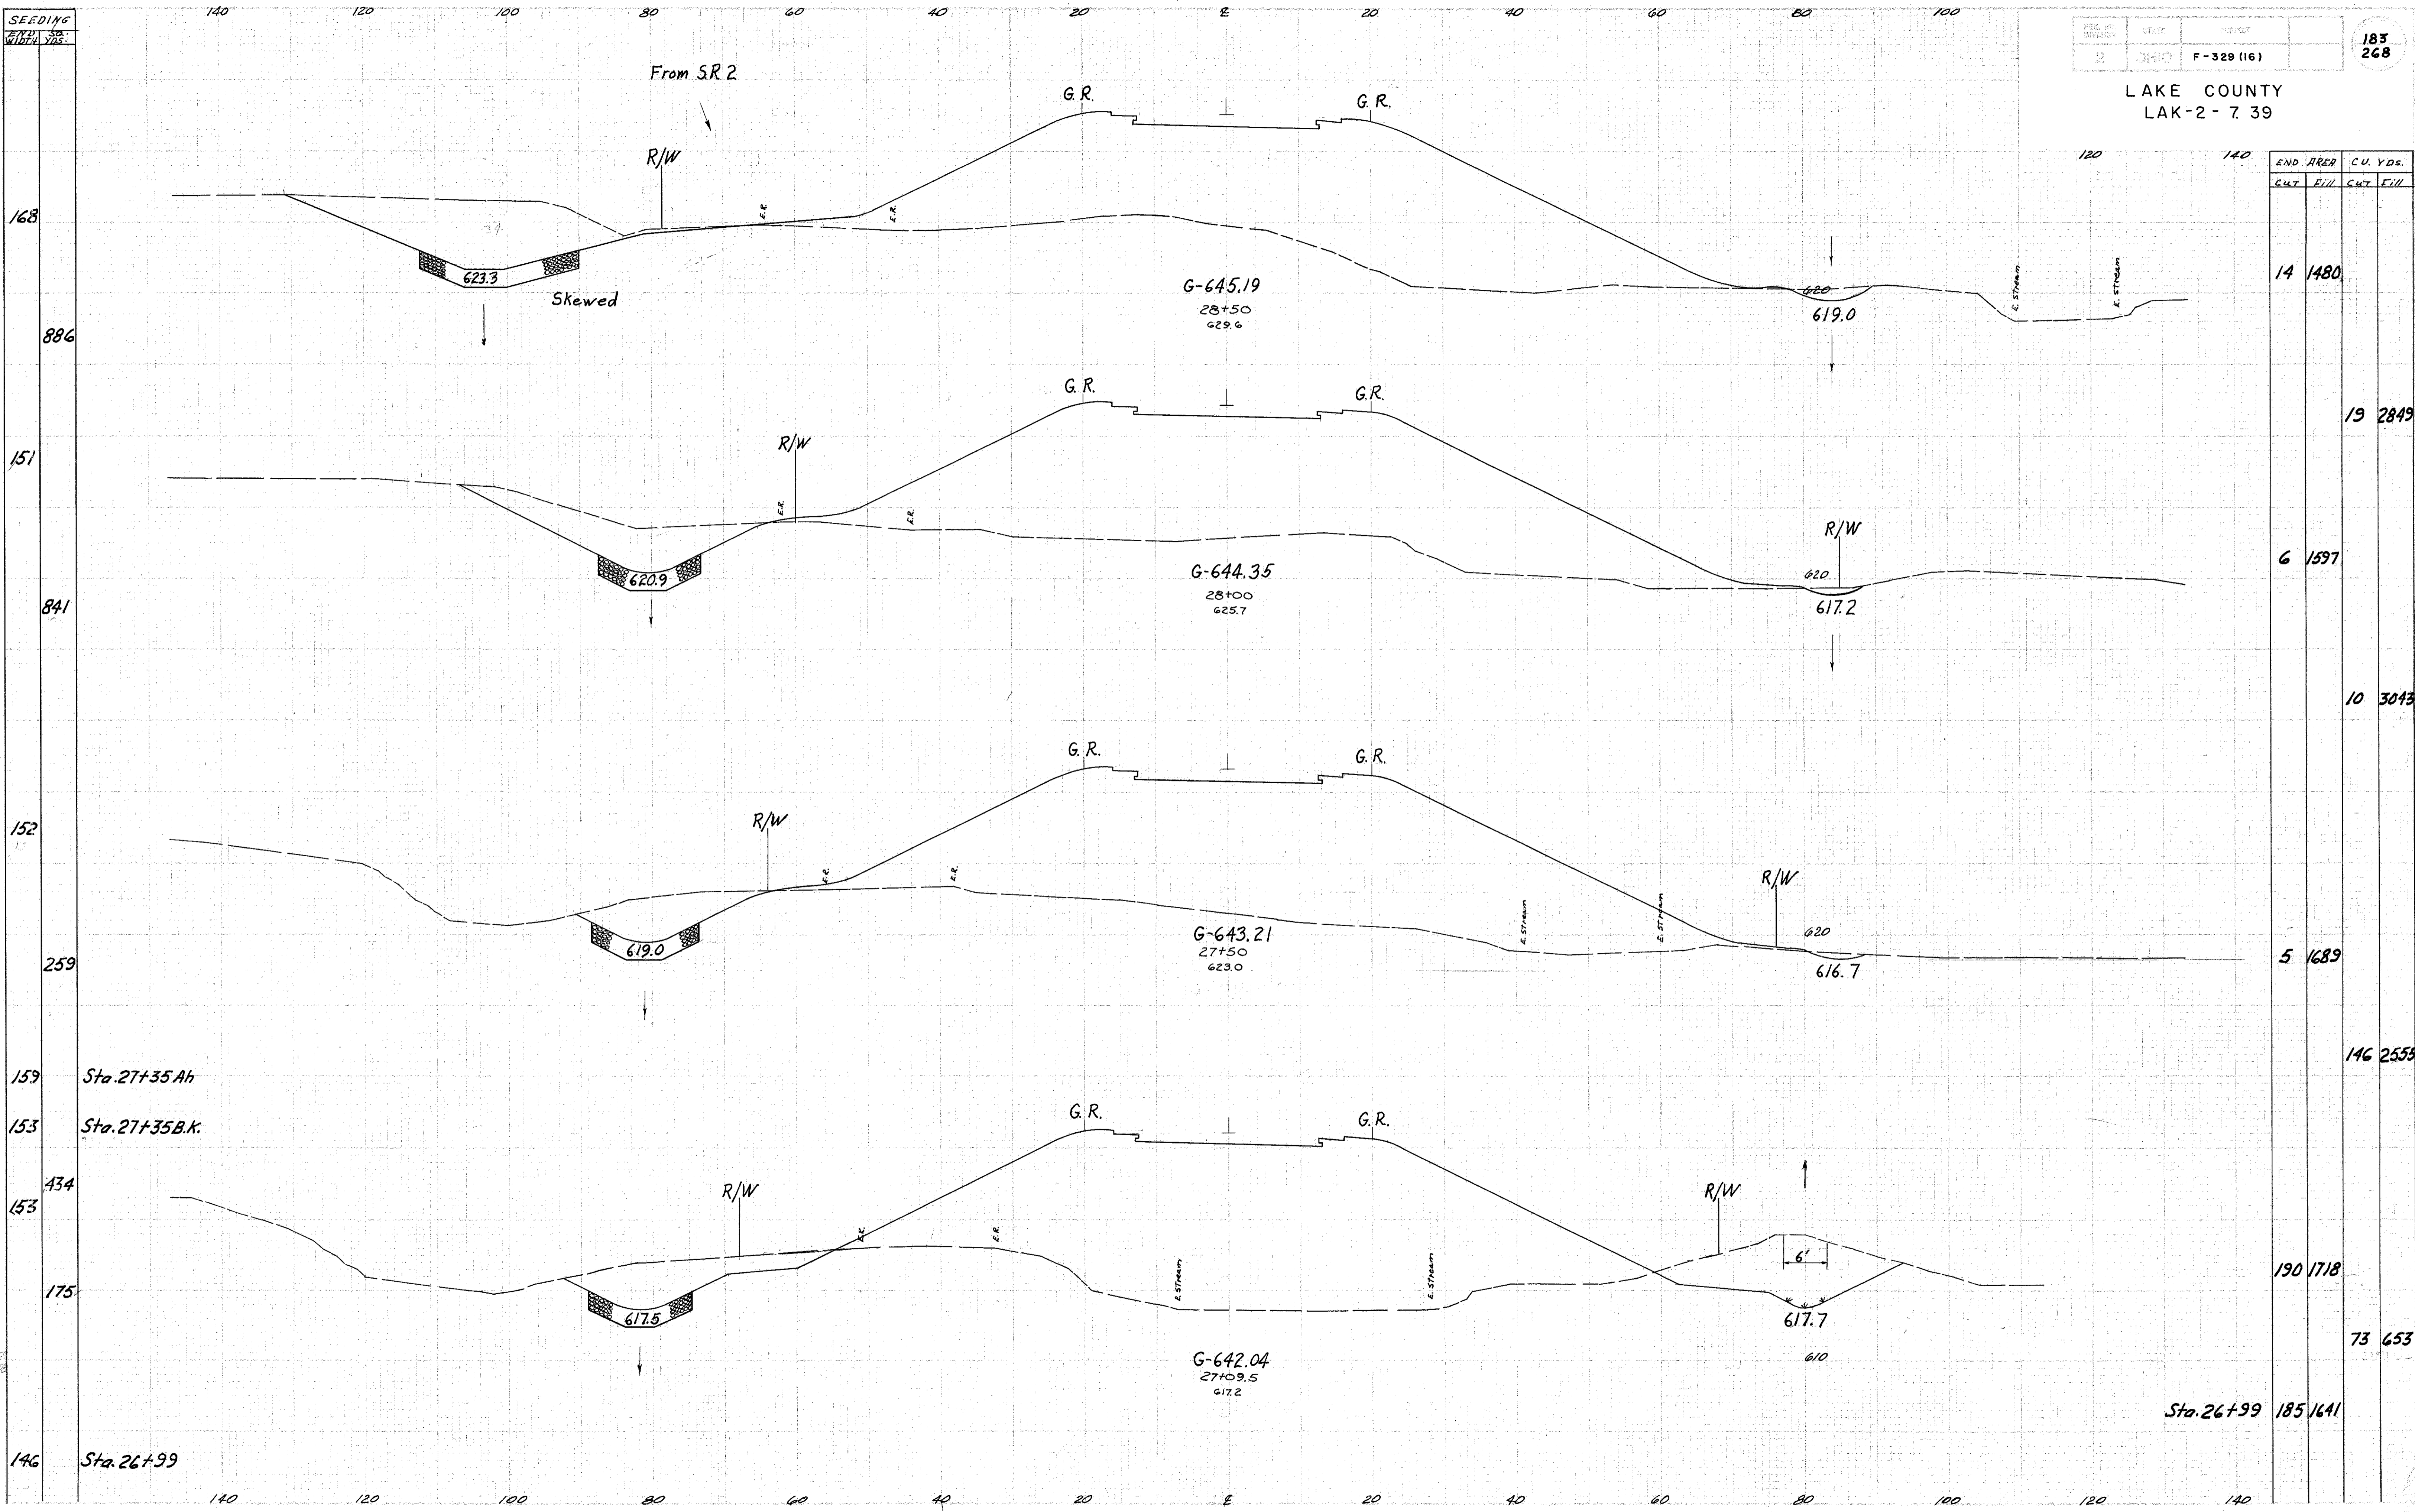

PUTTING S&L 1/2" x 1/2" plates in place Meas. 11.4' x 11.4' J.M. 7-2-39

Reconstruction Munson Road Sta. 27+09.5 to 28+50