


LAKE COUNTY
LAK-2-7.39


MICROFIL
DEC 5 1988

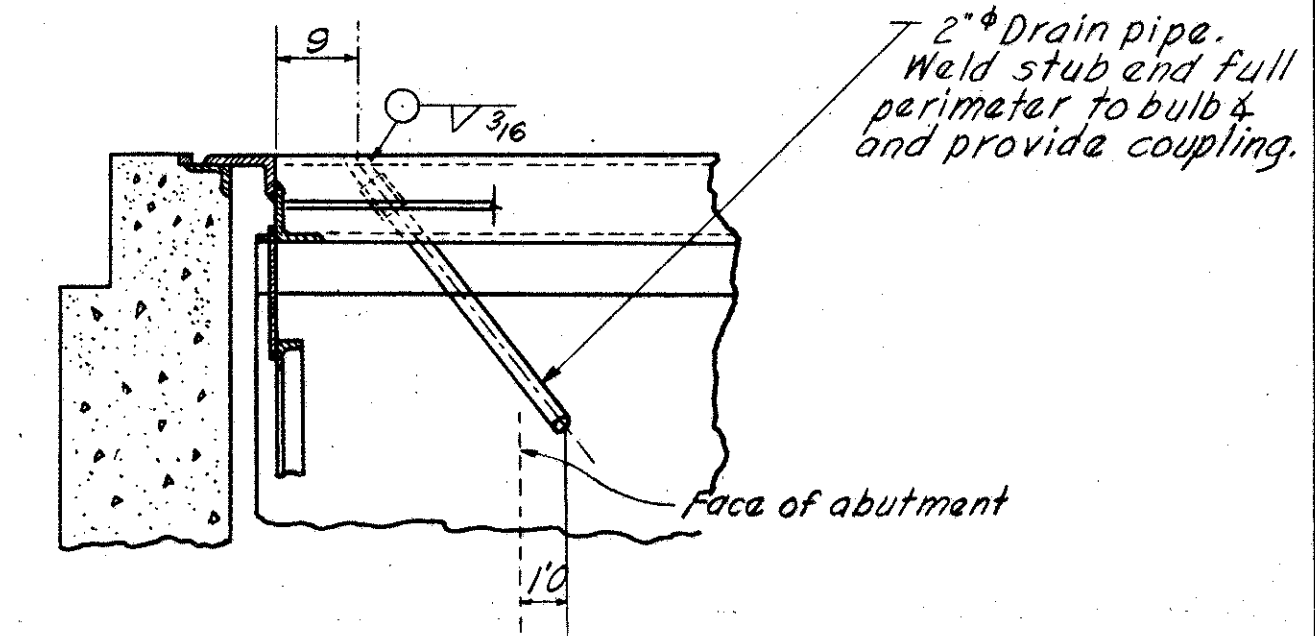

SCUPPER DETAIL AT END FINISH

SUPERSTRUCTURE										
Mark	No.	Length	Type	A	B	C	D	E	Weight	
S501	326	8'-7"	1	17	13	29	15		2915	
S502	326	4'-6"	2	6	2'0"				1530	
S601	326	37'-0"	Str.						18120	
S602	366	42'-7"	Str.	6 sets @ G1 = 366						23450
S603	72	30'-0"	Str.						3245	
S701	326	37'-0"	Str.						24650	
									73910	

RAILING									
Mark	No.	Length	Type	A	B	C	D	E	Weight
RA01	326	2'-6"	2	6	1'0"				*
RA02	326	17'-6"	Str.						*
RA03	16	14'-3"	Str.						*

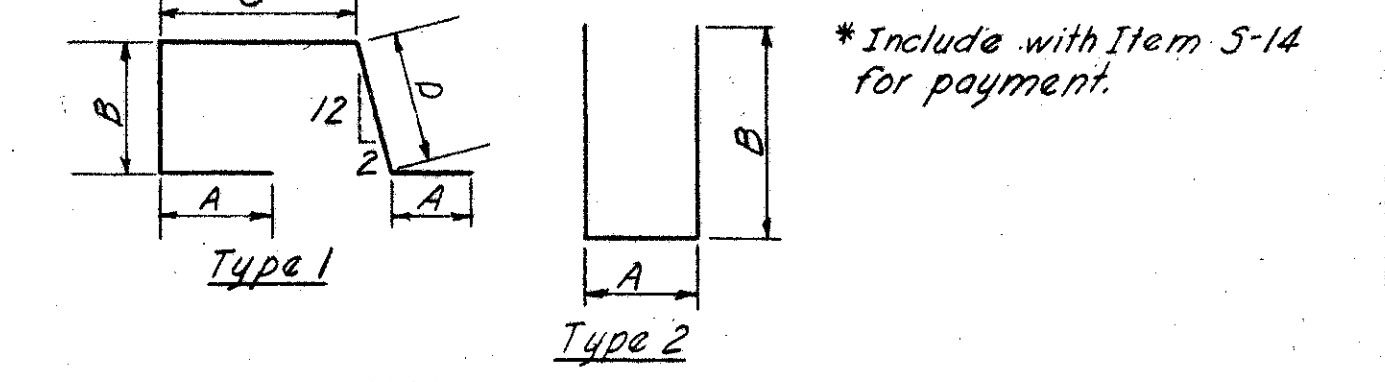

REPLACEMENT BARS					
MARK	NO.	SIZE	LENGTH	TYPE	WEIGHT
RP 4	2	4	5'-3"	Str.	
RP 5	4	5	5'-7"	Str.	
RP 6	4	6	5'-11"	Str.	
RP 7	4	7	6'-3"	Str.	
RP 8	2	8	6'-6"	Str.	
RP 9	2	9	6'-10"	Str.	
RP 11	4	11	7'-7"	Str.	
RP 4L	1	4	5'-3"	B	

REPLACEMENT BARS: If reinforcing bars are fabricated from stock which has previously been tested and approved by the Ohio Highway Testing Laboratory, test samples as provided in Sec. 4.02 need not be furnished and replacement bars will not be required.


SEC. L-32 FED. AID PROJ. NO. F-329 (16)

STATE OF OHIO
DEPARTMENT OF HIGHWAYS
DIVISION OF DESIGN AND CONSTRUCTION
BUREAU OF BRIDGES

STEEL FRAMING
BRIDGE NO. LAK-2-1025
S. R. 2 UNDER MUNSON ROAD
LAKE COUNTY


STA. 441+28.08

DESIGNED	DRAWN	TRACED	CHECKED	REVISED	DATE	REVISED
M			P			4-1-59

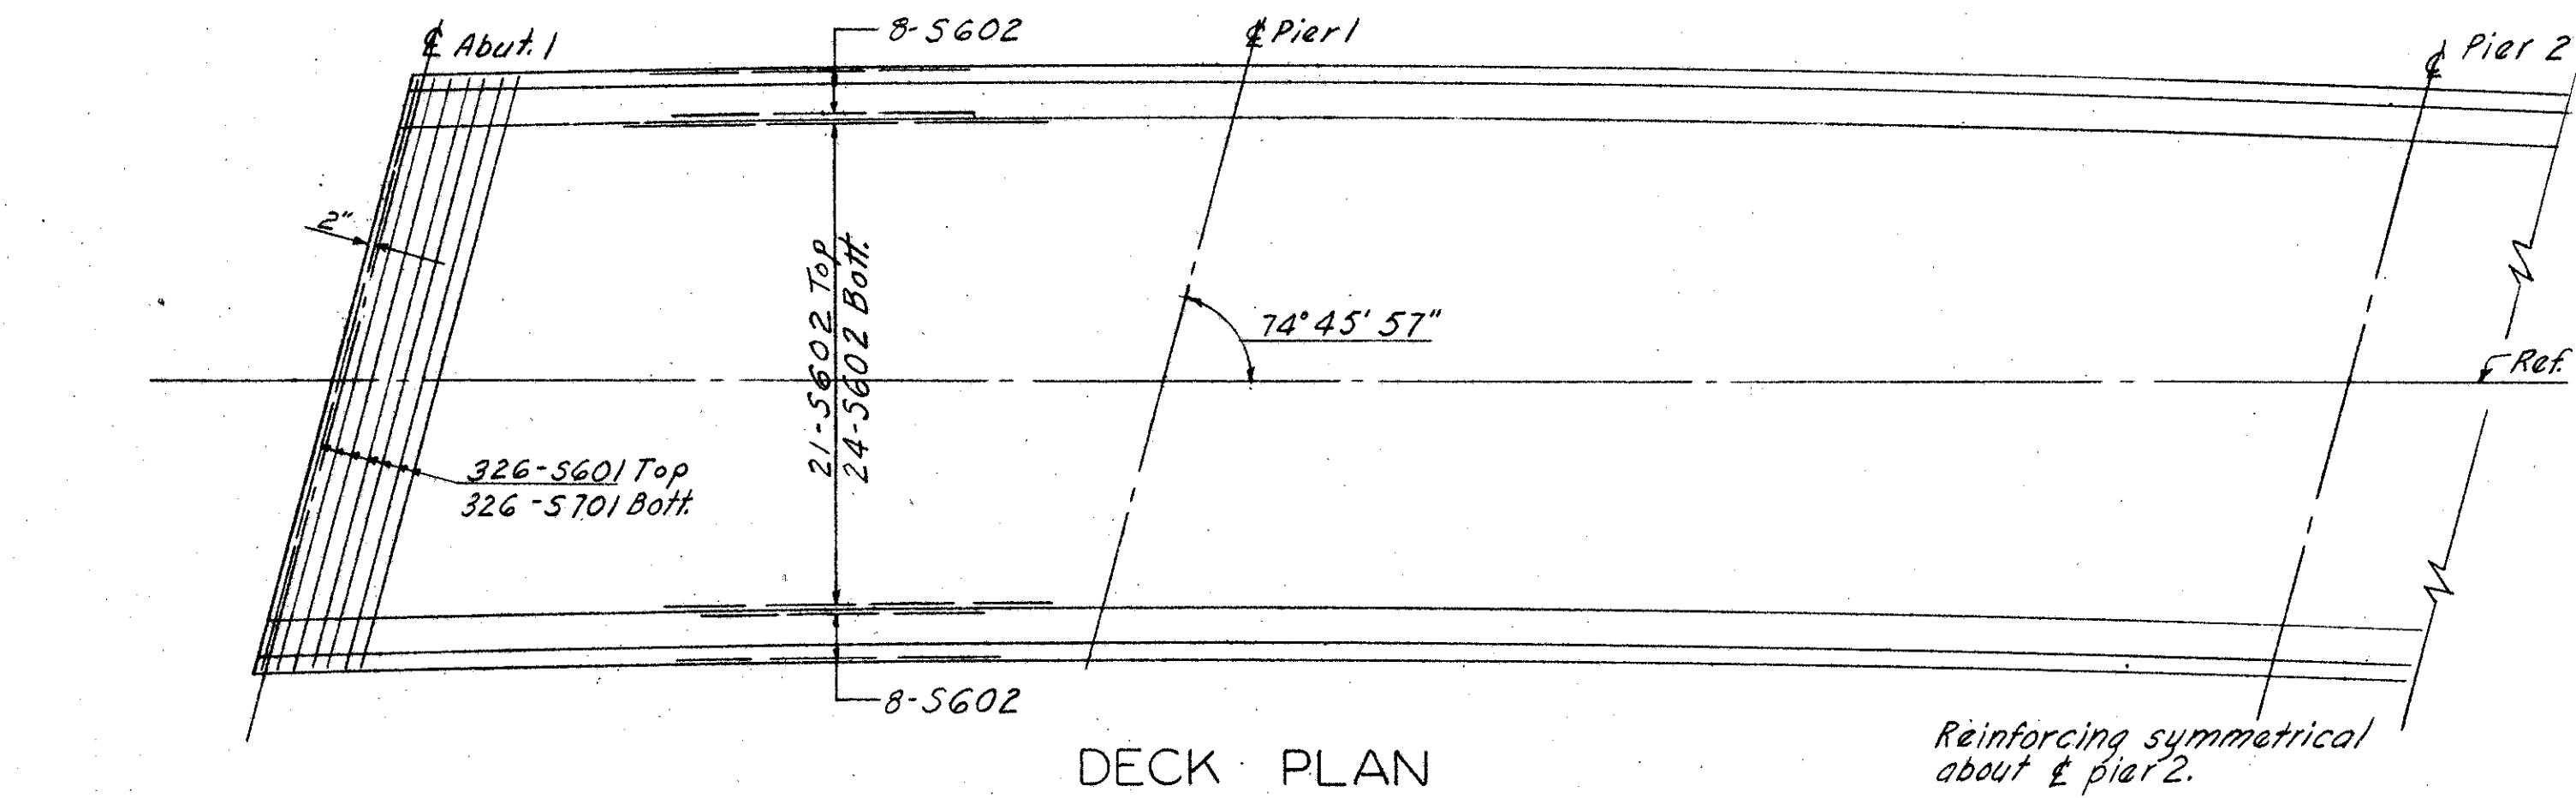


DECK PLAN

Reinforcing symmetrical about Pier 2.

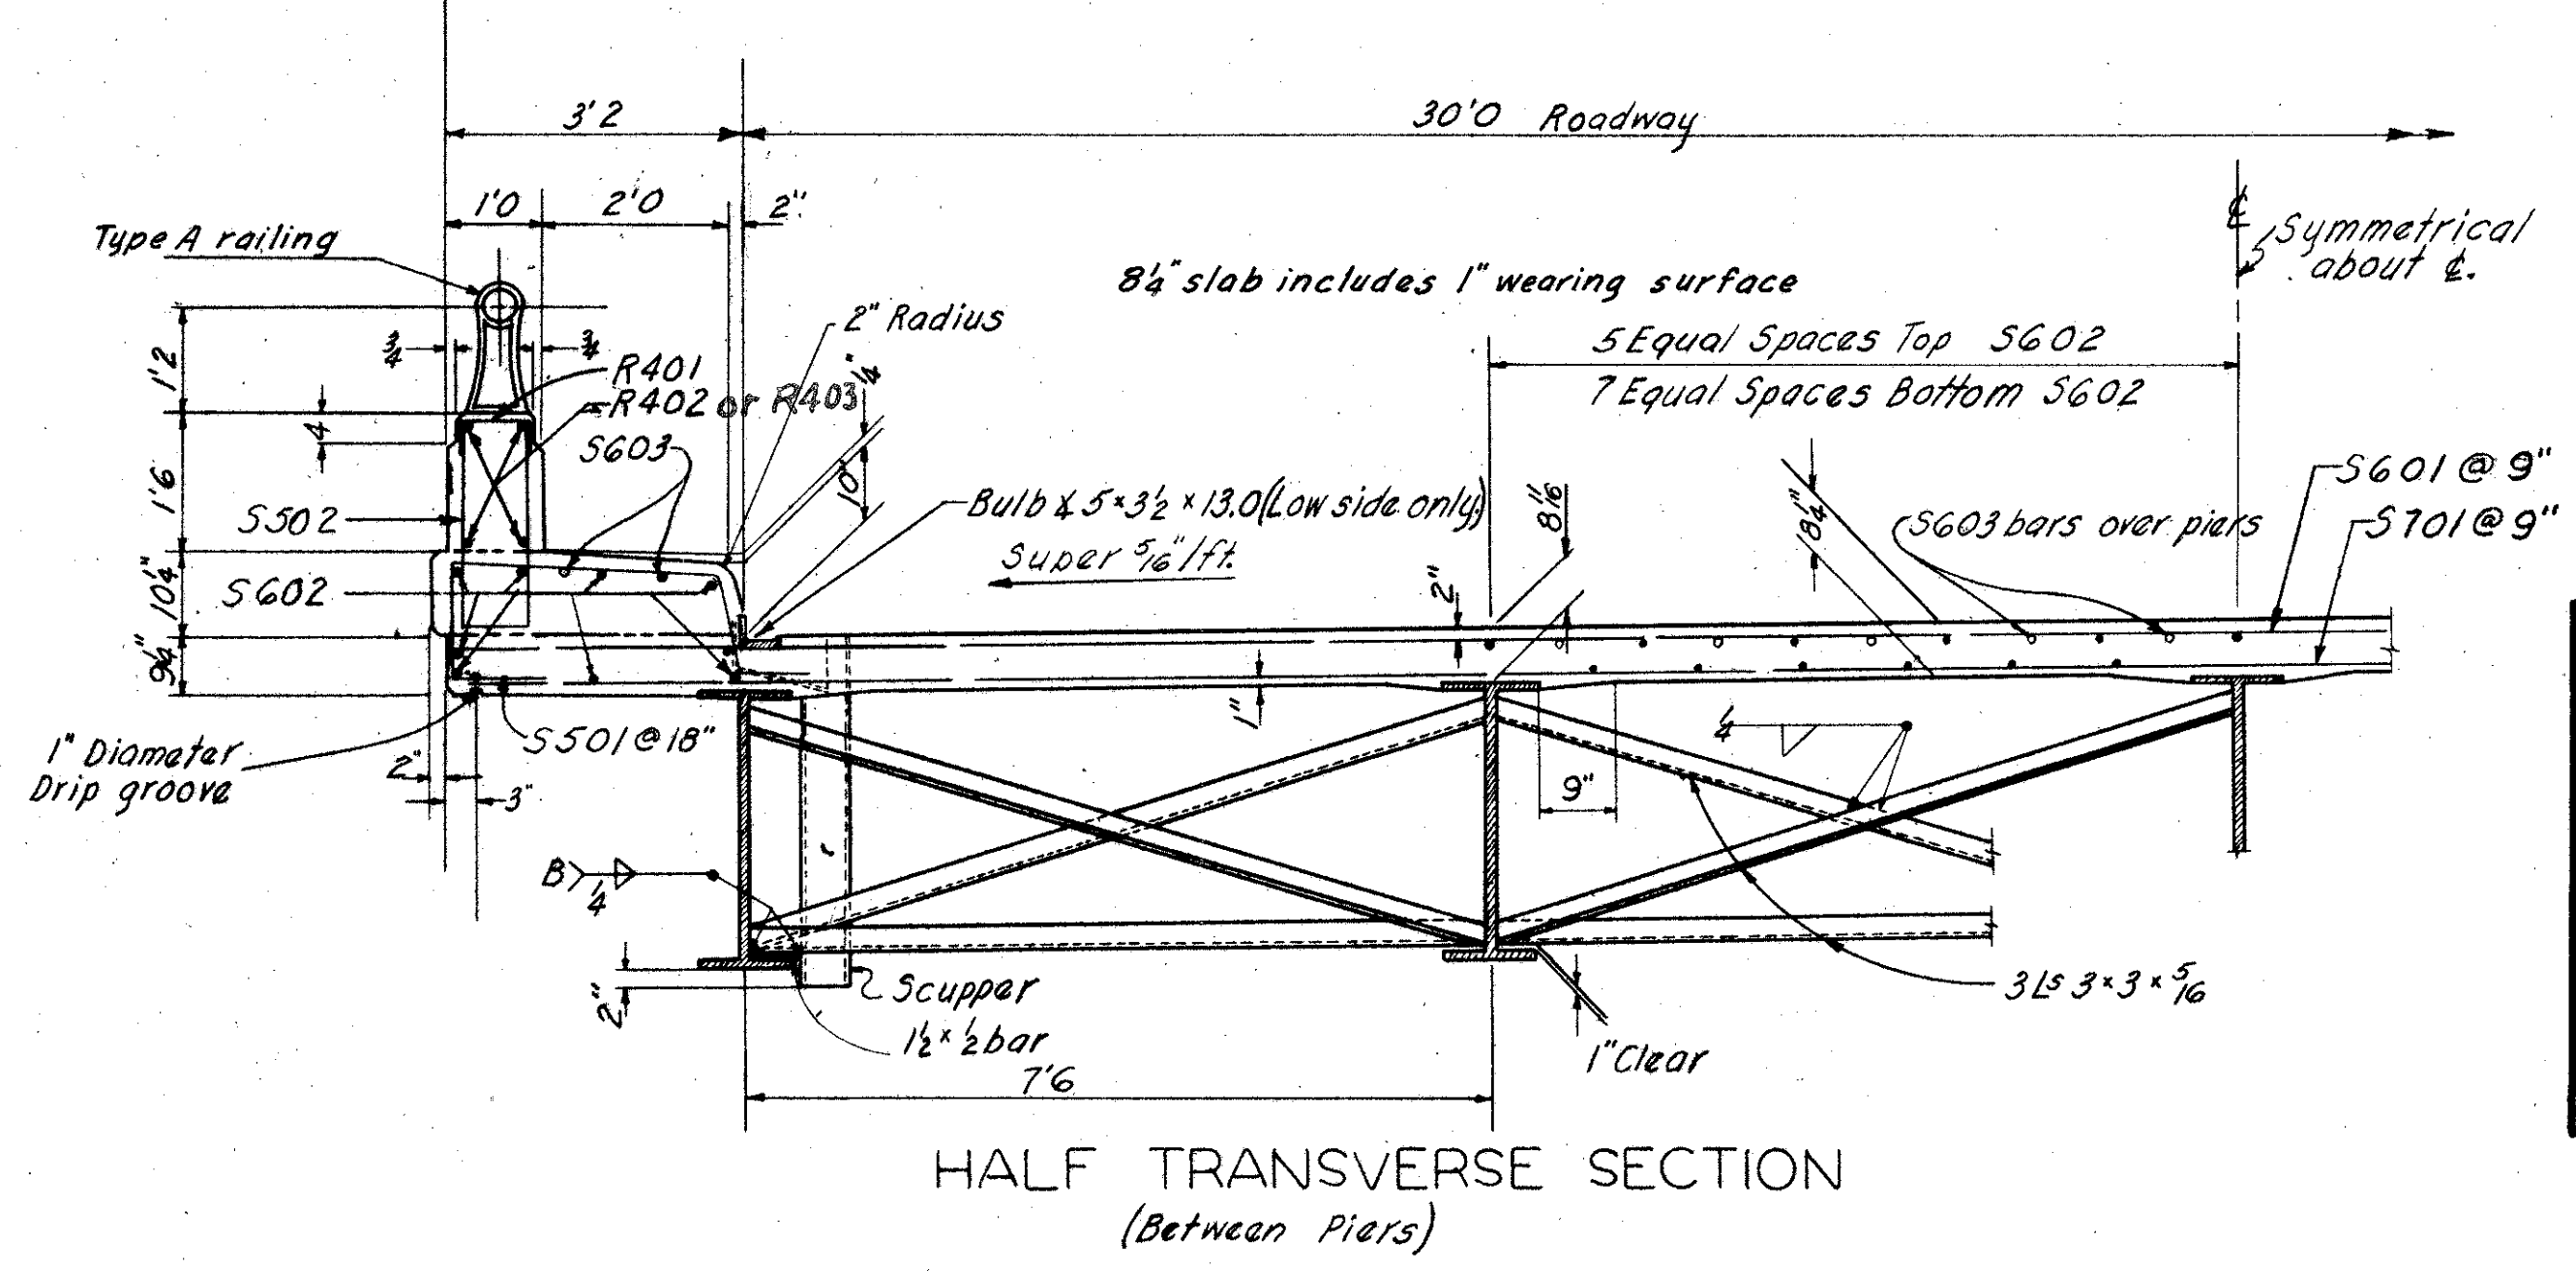

HALF TRANSVERSE SECTION
(Between Piers)

DEFLECTION AND CAMBER				
LOCATION	OUTSIDE BEAMS		INSIDE BEAMS	
	END SPANS	MIDDLE SPANS	END SPANS	MIDDLE SPANS
DEFLECTION DUE TO WEIGHT OF STEEL	1/8"	1/8"	1/8"	1/8"
DEFLECTION DUE TO REMAINING DEAD LOAD	1/2"	0/8"	0/8"	0/8"
CONVEXITY REQUIRED FOR VERTICAL CURVE	1/4"	2/8"	4/8"	1/8"
SUM OF DEFLECTION AND CONVEXITY	7/8"	1 1/2"	5/8"	1"
REQUIRED CAMBER	1"	1"	1"	1"

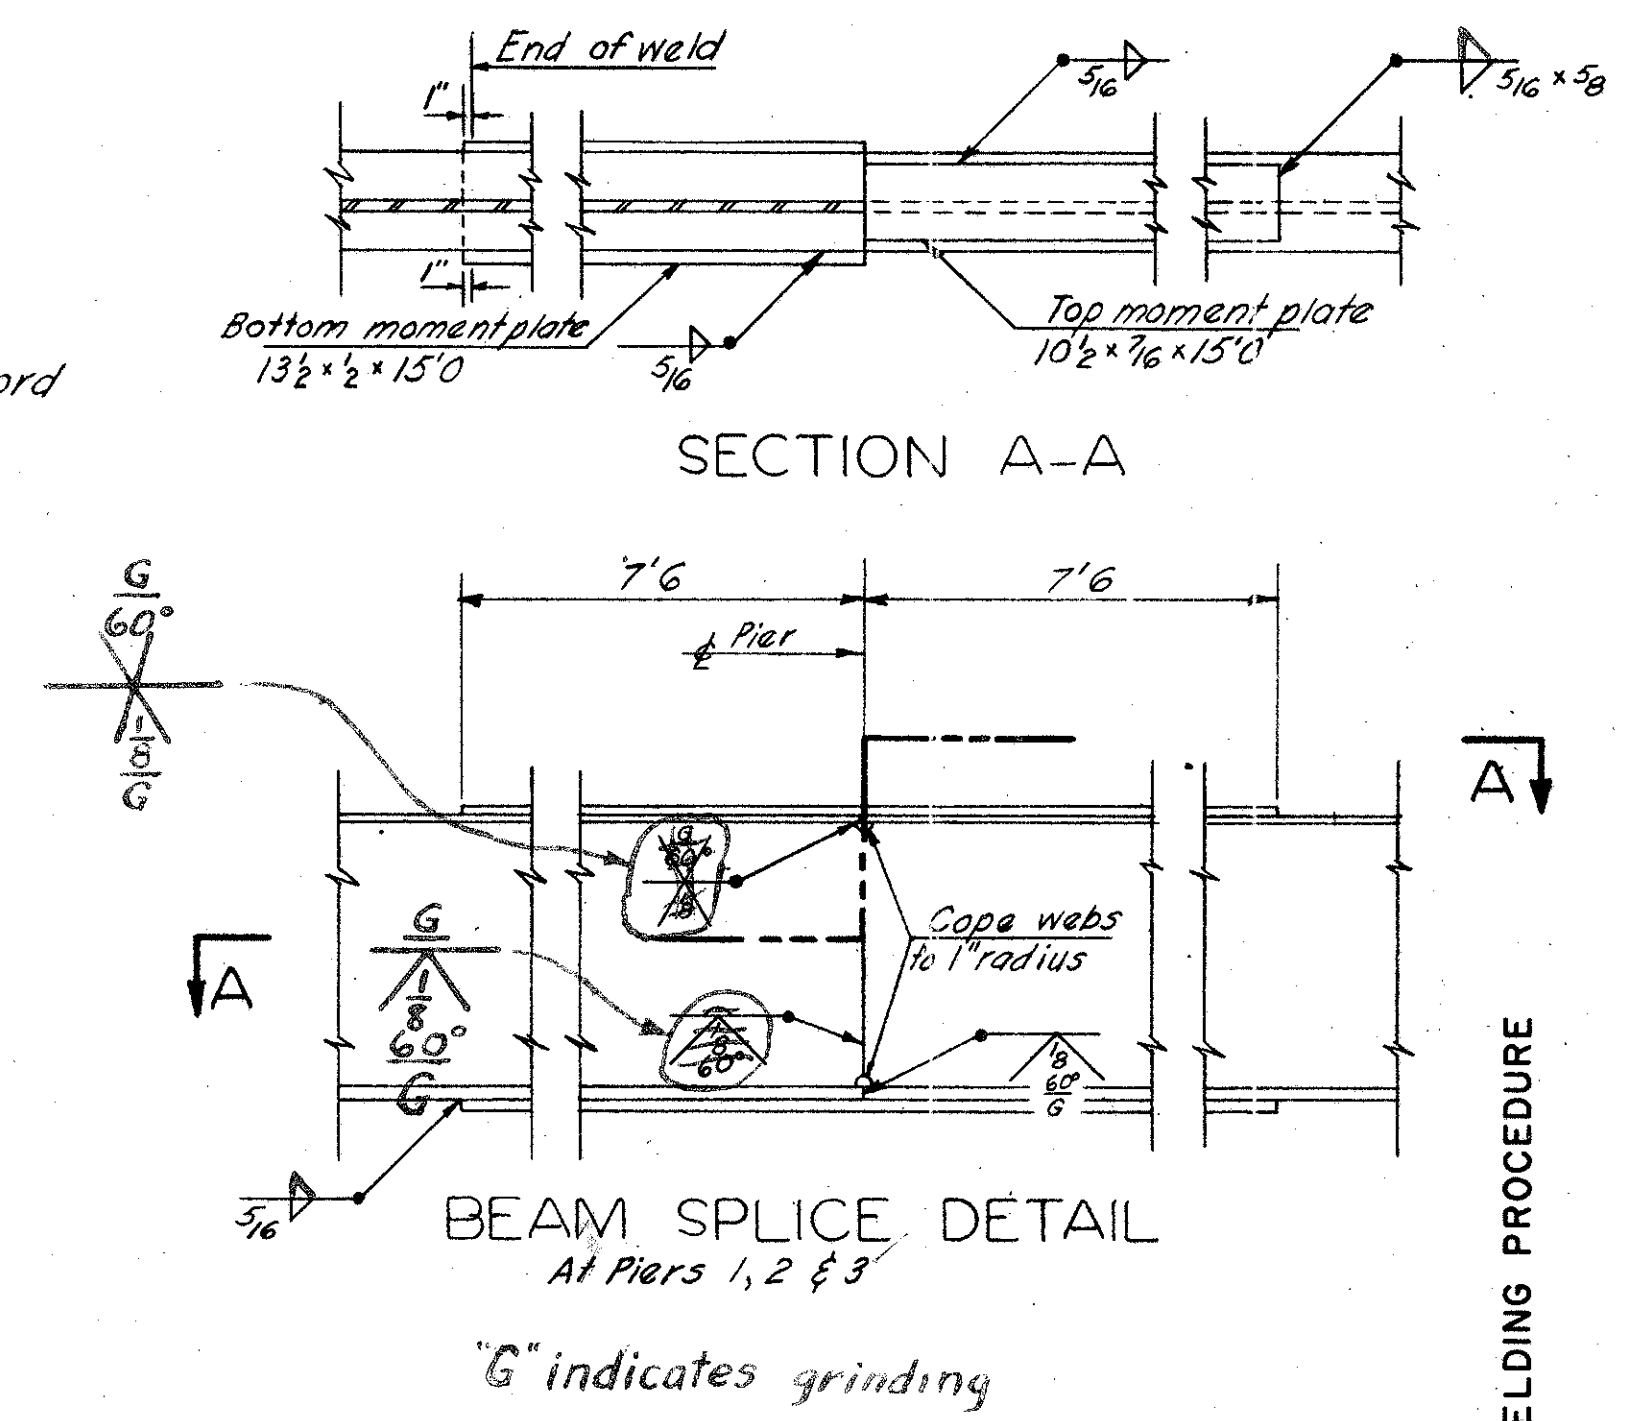


BEAM SPLICE DETAIL
At Piers 1, 2 & 3

"G" indicates grinding

BEAM SPLICE WELDING PROCEDURE

1. Raise end of beam at rear pier 2 3/4".
2. Buff weld beam flanges and web at center pier using the following sequence: make one pass on each flange, then one on the web; repeat until welds are complete.
3. Weld top and bottom flange moment plate at center pier.
4. Lower end of beam at rear pier.
5. Make beam splice at rear pier in same manner raising abutment end of beam 1 3/4".
6. Make beam splice at forward pier in same manner raising abutment end of beam 1 3/4".

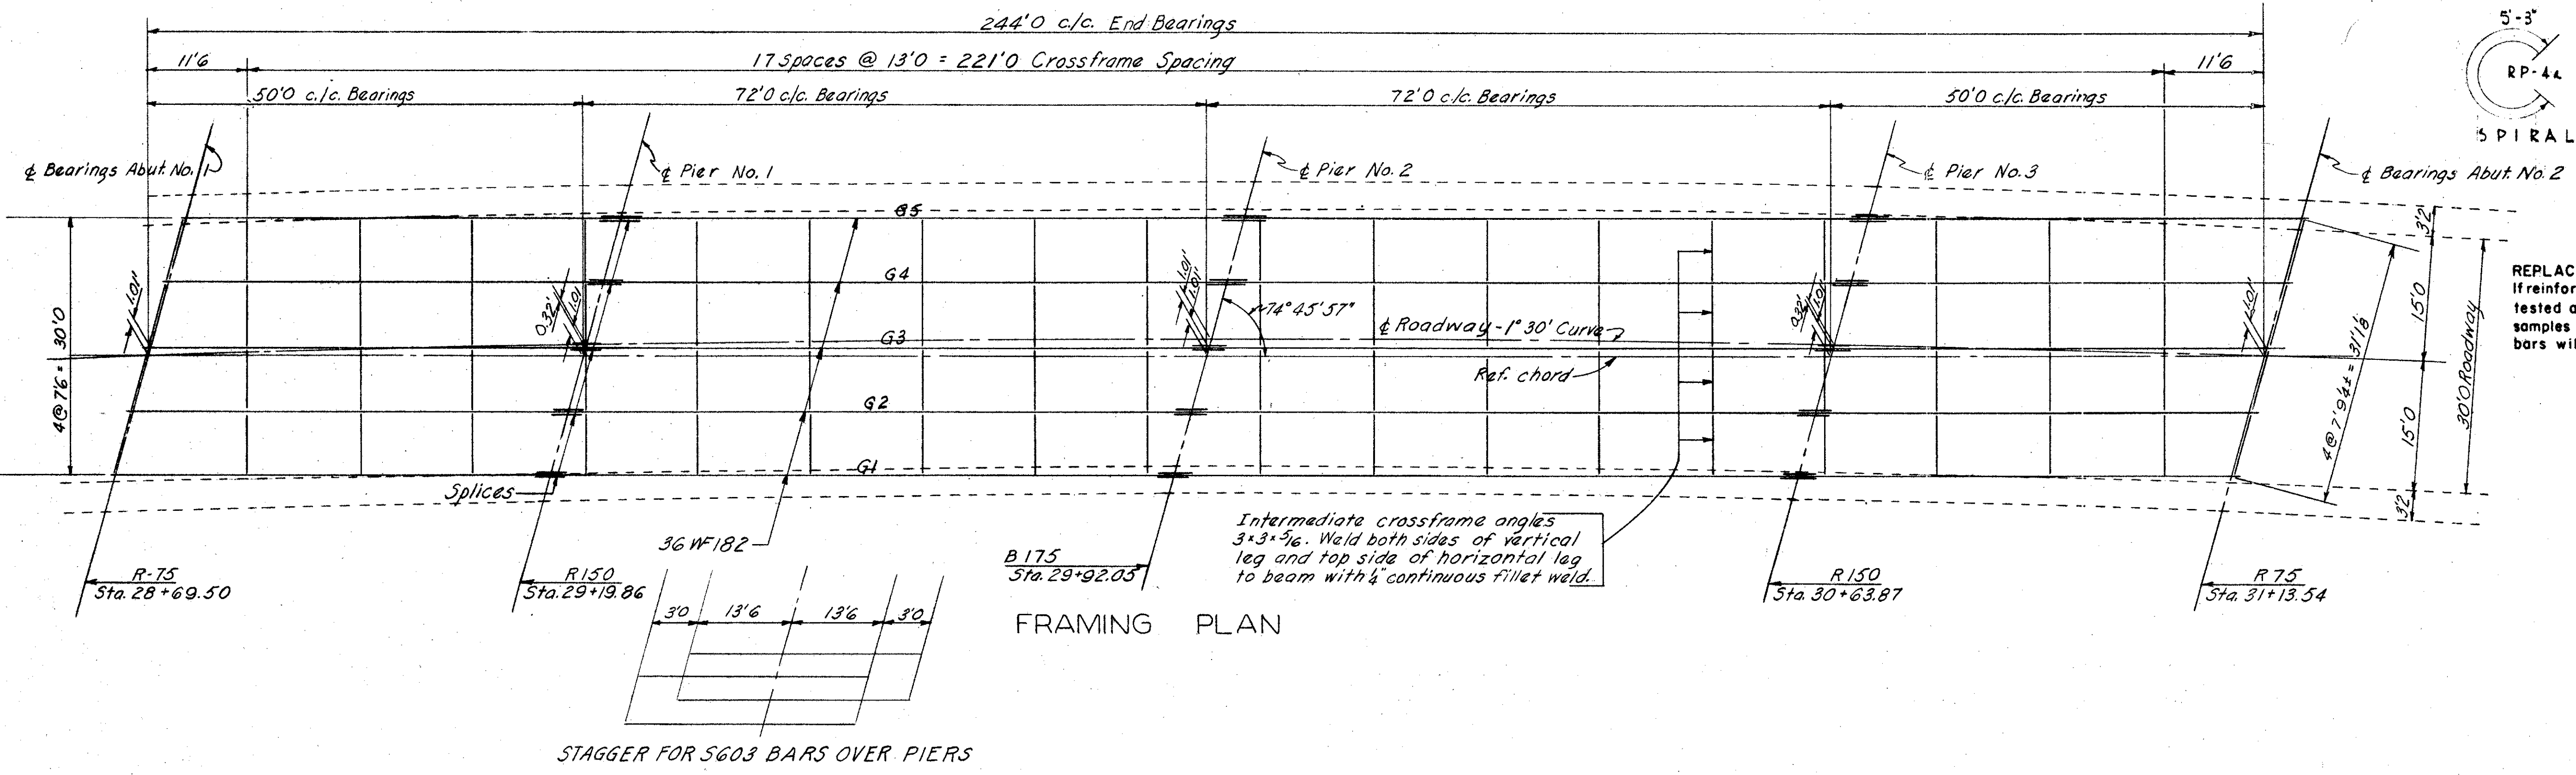

FRAMING PLAN

STAGGER FOR 5603 BARS OVER PIERS