


FED. RD. DIVISION	STATE	PROJECT
2	OHIO	F-329 (16)

270
268


LAK - 2 - 7.39
R/W PLAN
LIMITED ACCESS

15
15

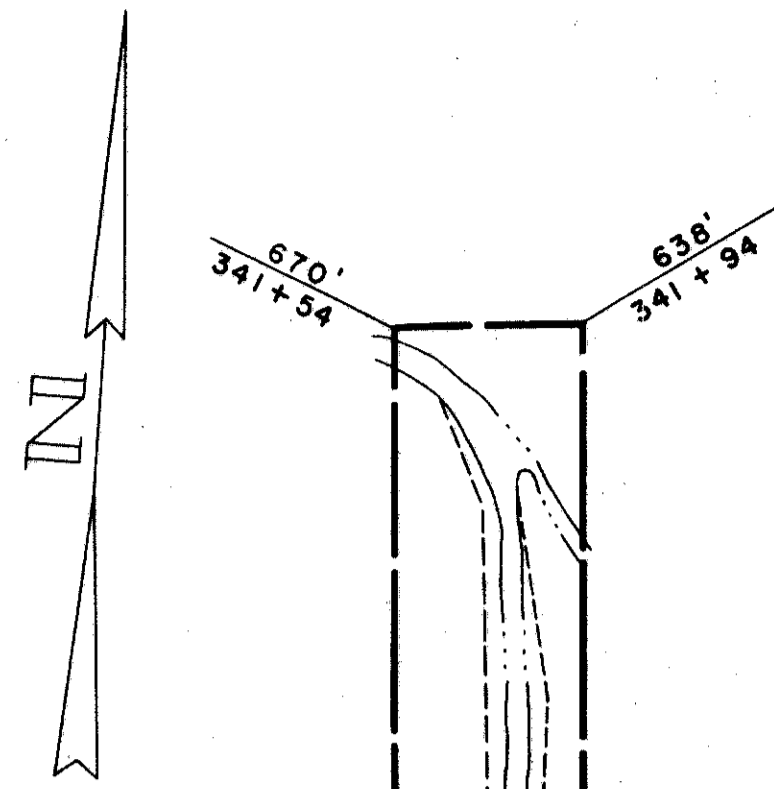

NEW YORK CENTRAL DEVELOPMENT CORPORATION
6X Cont. 0.82 Ac.

HUNTINGTON LOT
TRACT 5

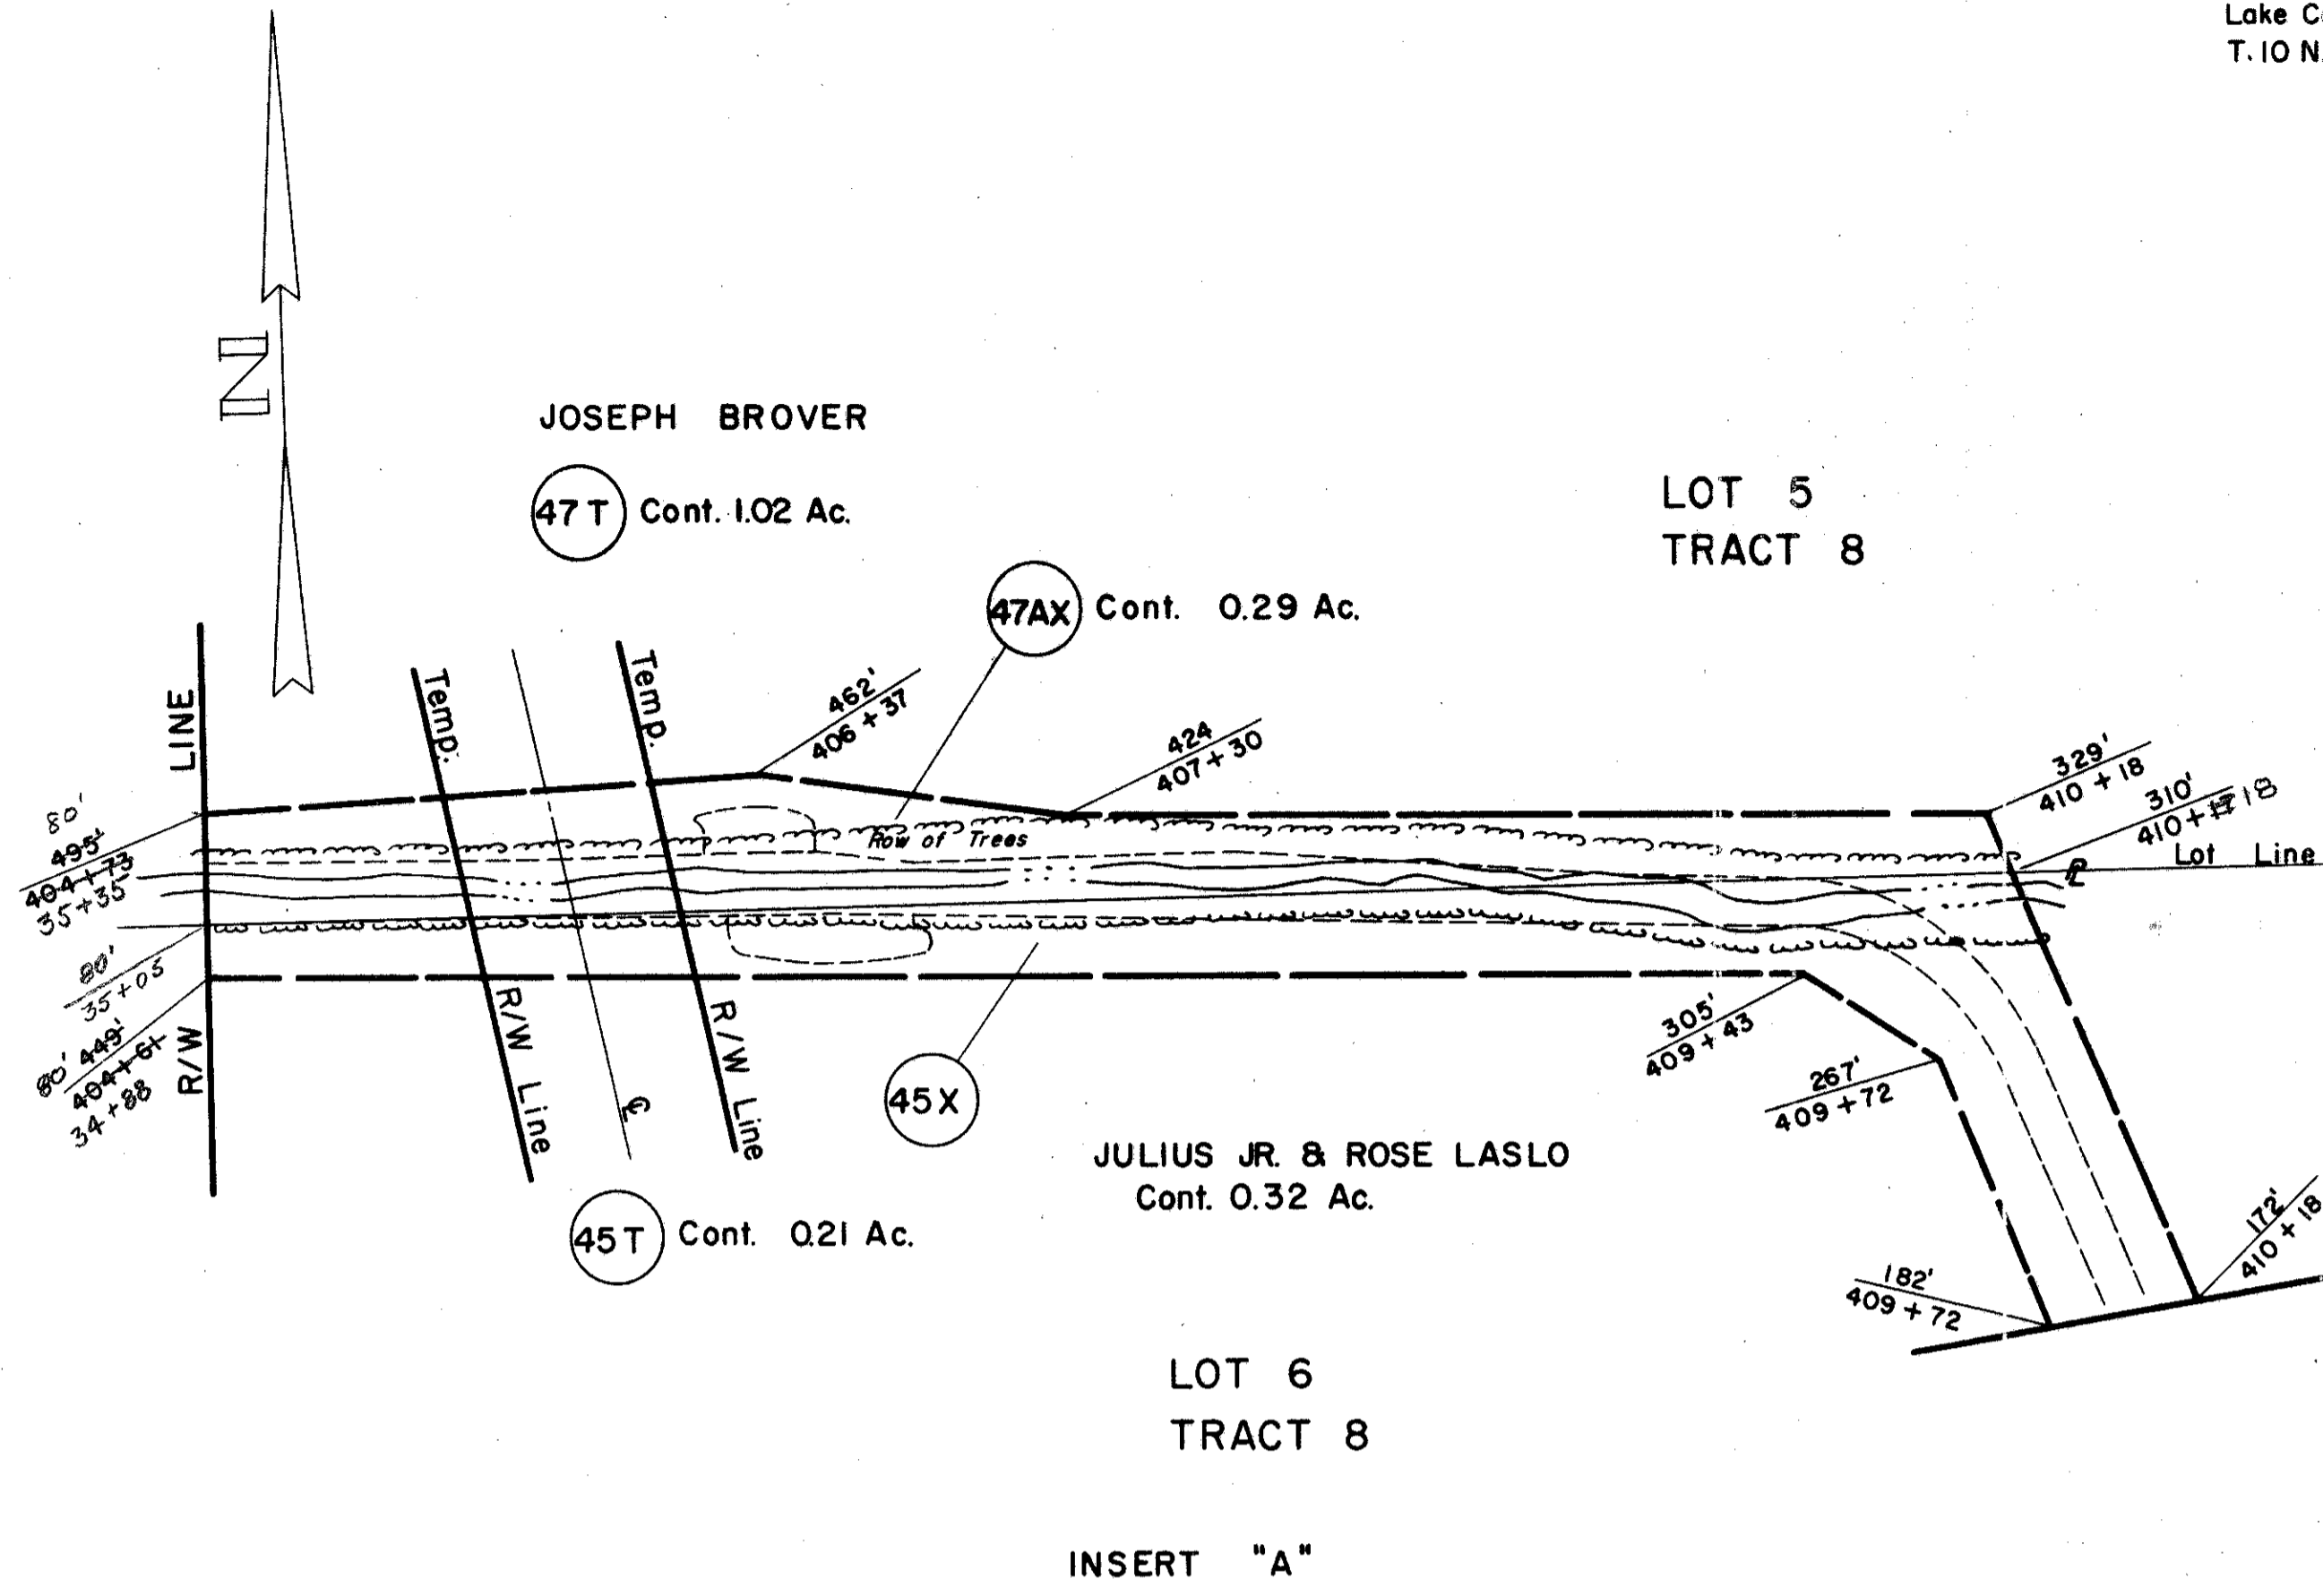

INSERT "A"