


CALC. BY:	LAKE/ASHTABULA COUNTY	OHIO
DATE:	LAK/ATB-20-24.89/0.00	F.H.W.A. 5 REGION
CHK.D BY:	R/W ONLY	
DATE:		
FEDERAL PROJECT	STATE PROJECT	


29

LAKE COUNTY  
MADISON TOWNSHIP  
TRACT 4  
LOT 6

NOTE:  
EXISTING RIGHT OF WAY LOCATION  
AND WIDTH DETERMINED FROM:  
- PRIOR RIGHT OF WAY PLAN, DATED 1940.  
- SURVEY BY: WESTERN RESERVE ENGINEERING  
& SURVEYING CO., 1992

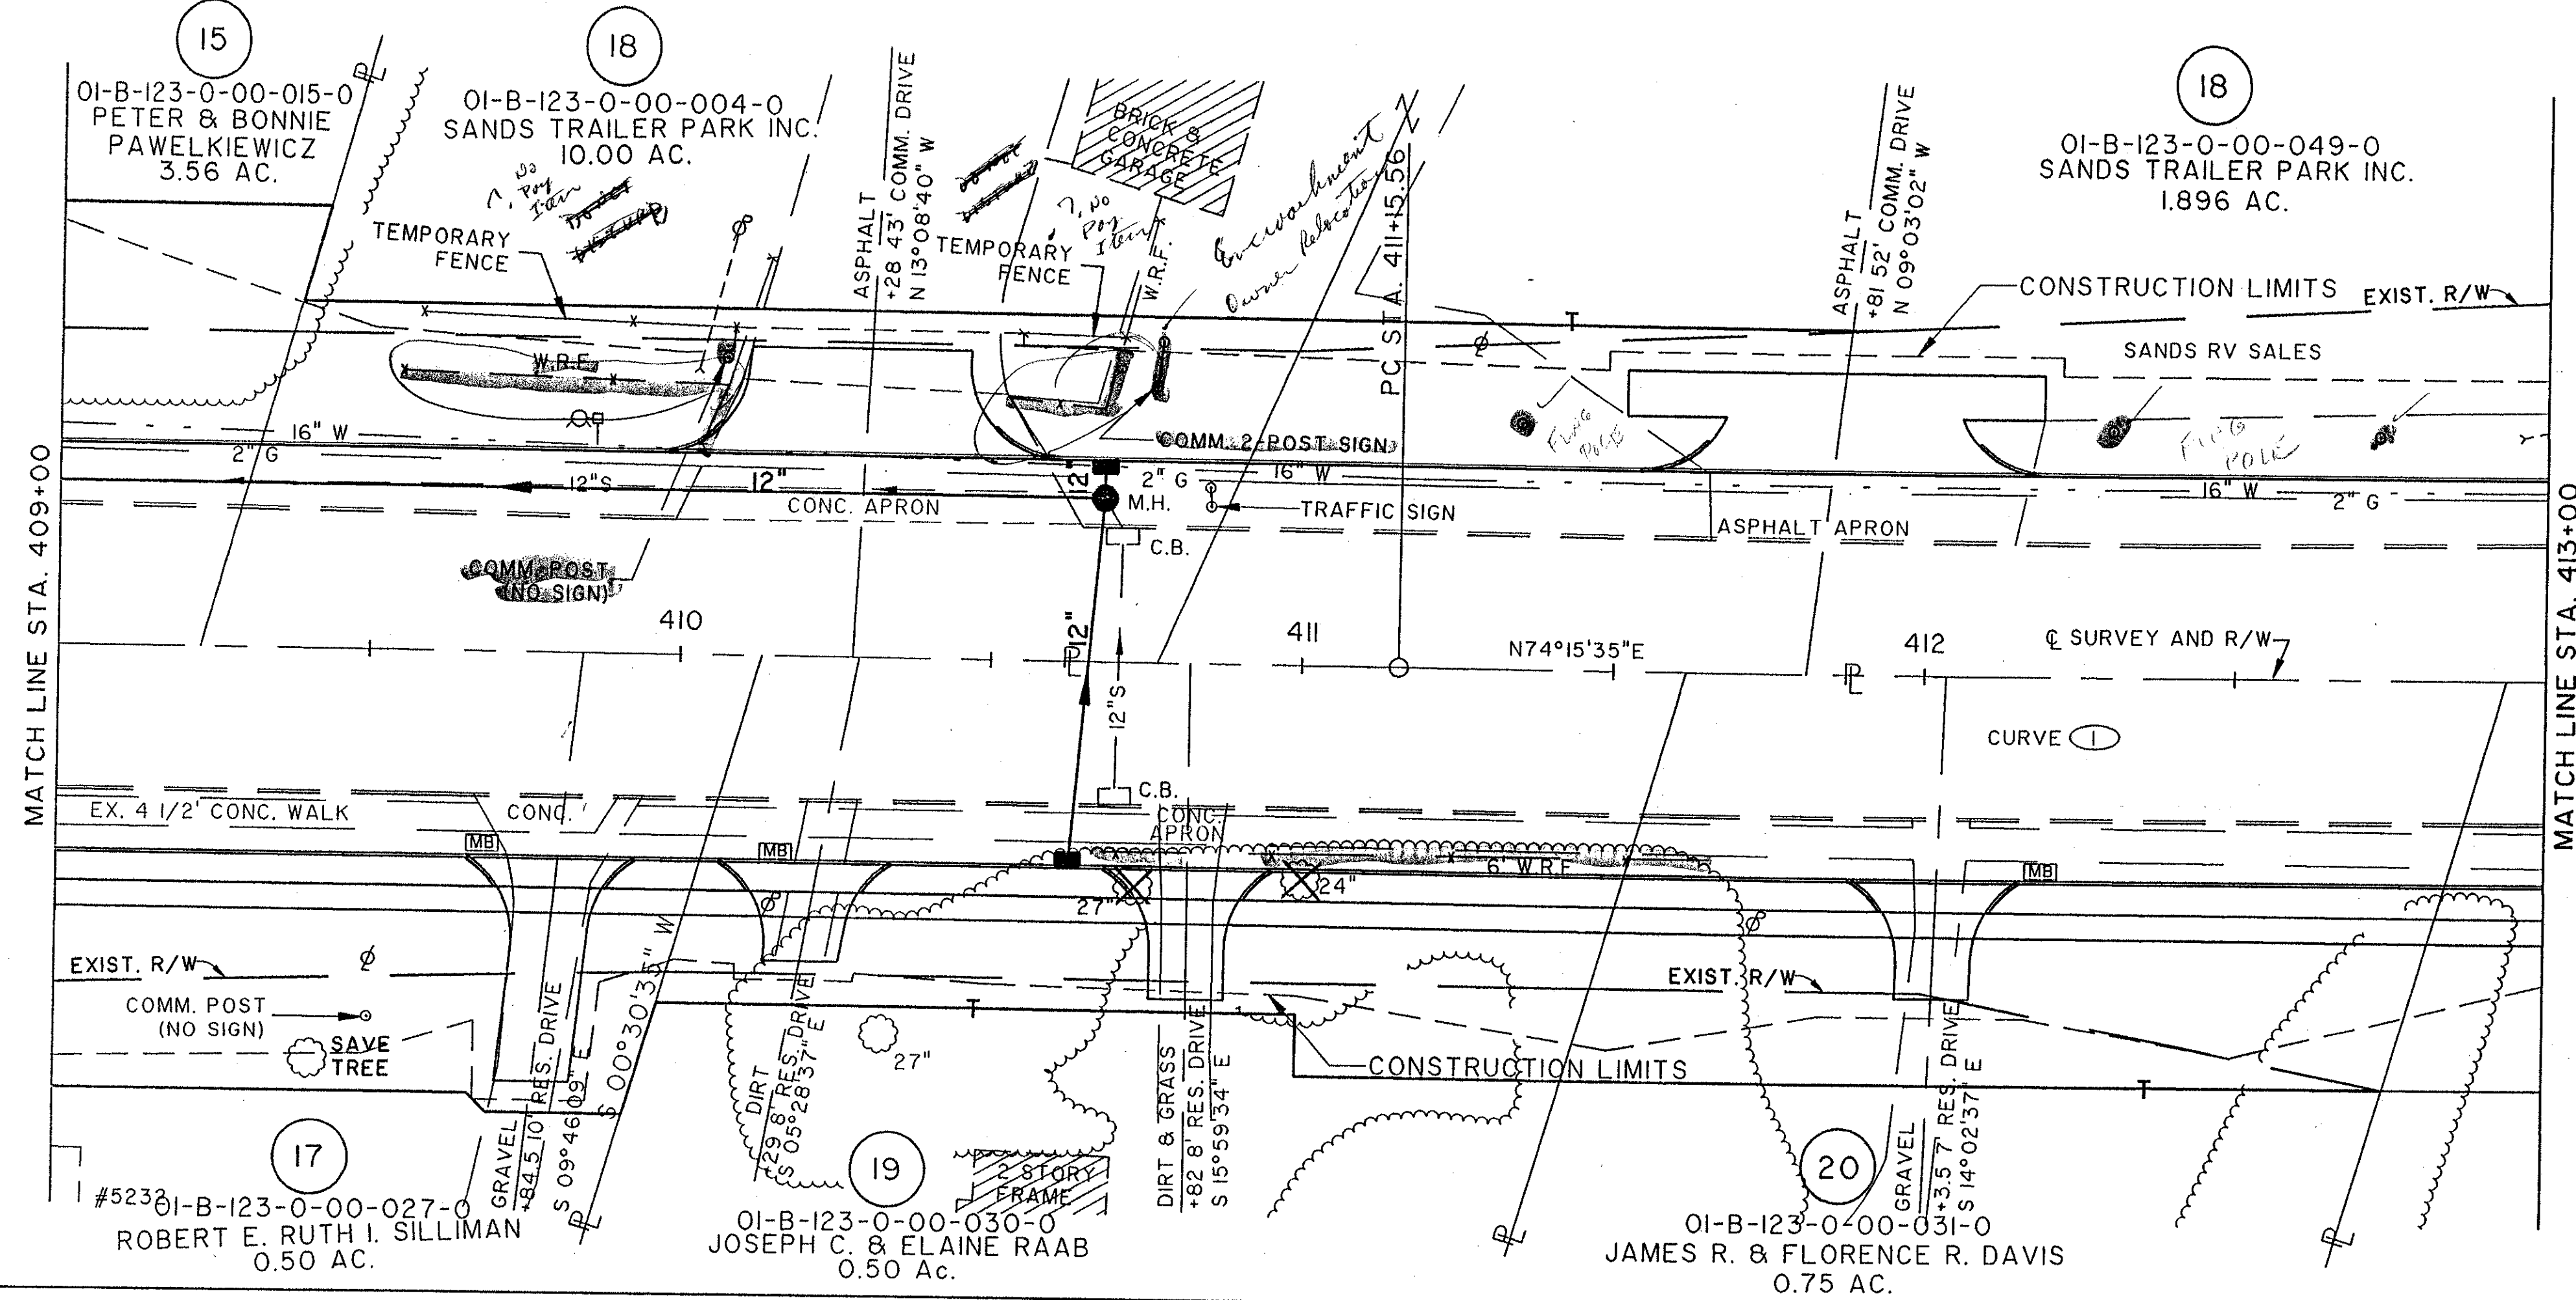

CURVE 1 DATA	
PI STA.	412+95.56
Δ	00°34'02"
R	36361.36'
D	00°09'27"
T	180.00'
L	360.00'
C	360.00'
S	NONE

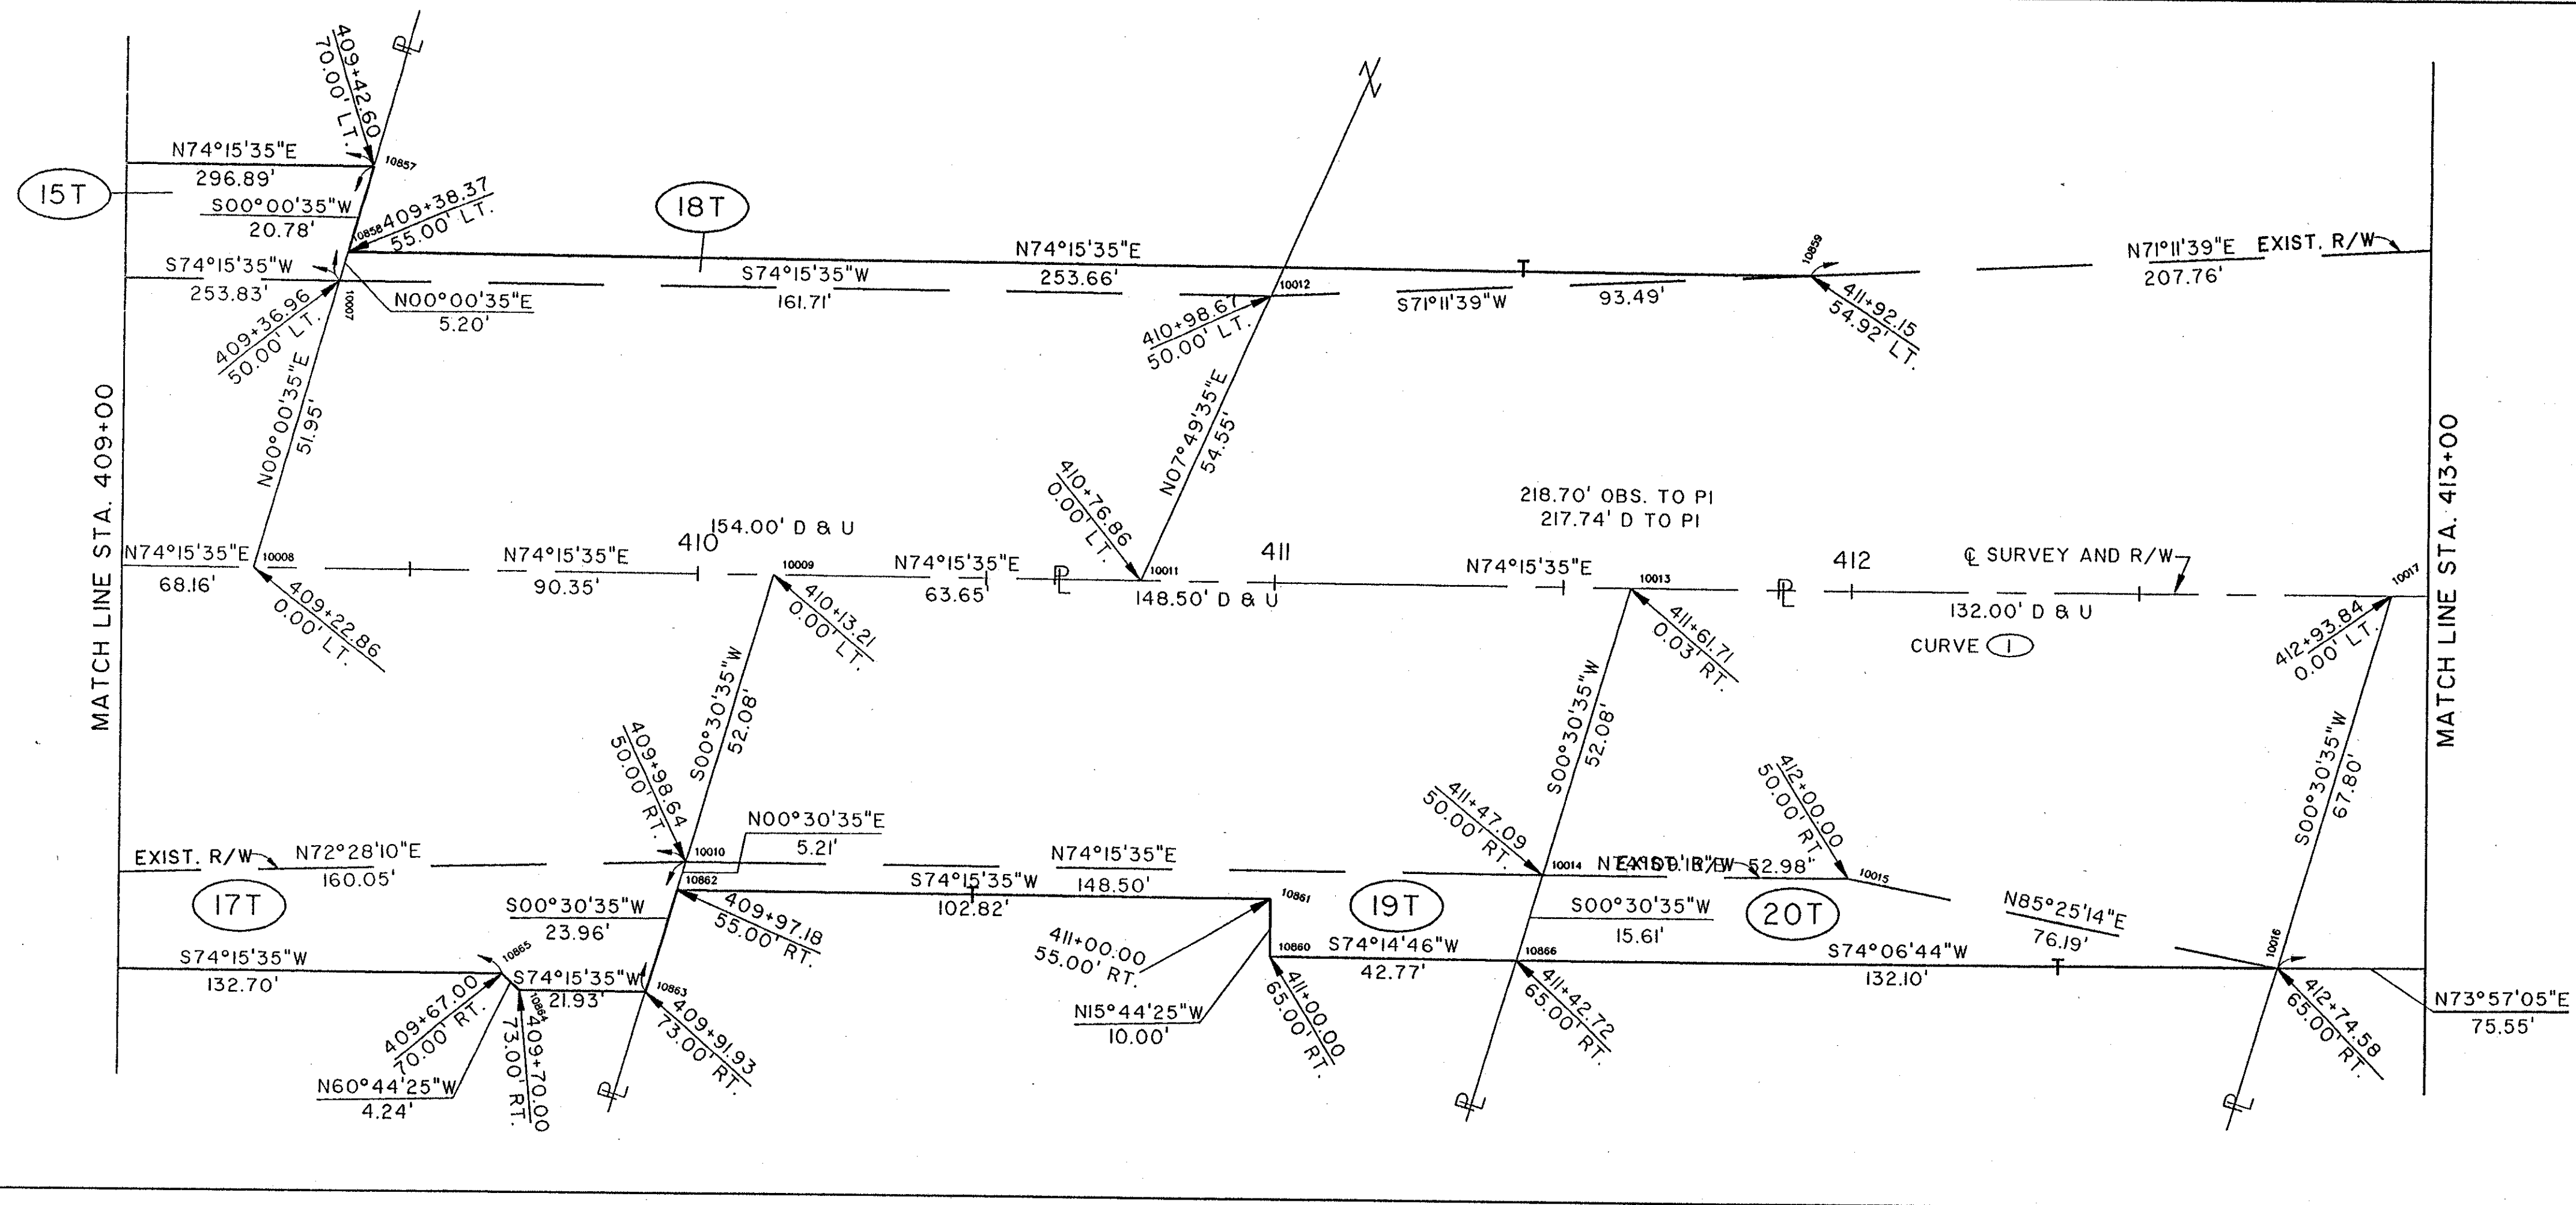

COMPLETION DATE:		
REV.	DATE	DESCRIPTION

File Name: K:\M\1\0001\9875\STRUCT\89755579  
Drawn By: Date: 2/02-28-94 (17)