
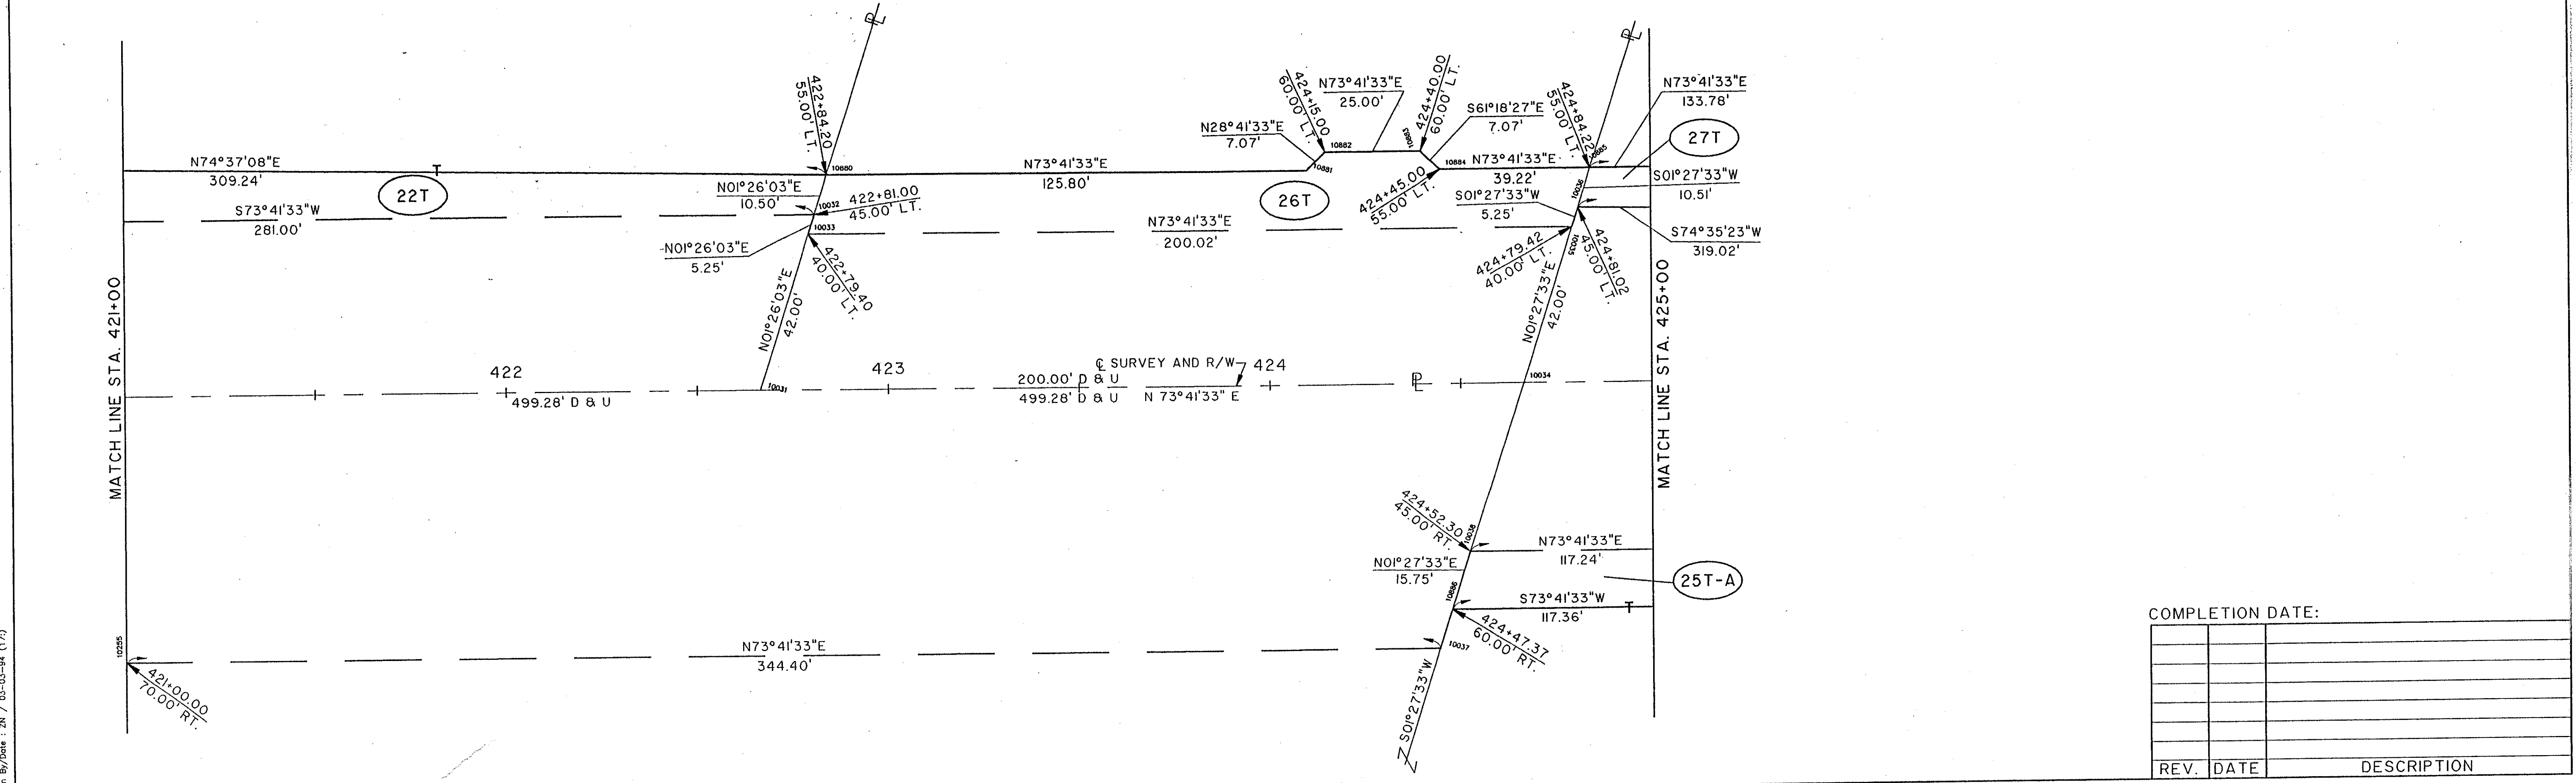


CALC. BY:	LAKE/ASHTABULA COUNTY	OHIO
DATE:	LAK/ATB-20-24.89/0.00	F.H.W.A. 5 REGION
CHK.D BY:	R/W ONLY	
DATE:		
FEDERAL PROJECT:	STATE PROJECT:	32

NOTE:
 EXISTING RIGHT OF WAY LOCATION AND WIDTH DETERMINED FROM:
 - PRIOR RIGHT OF WAY PLAN, DATED 1940.
 - SURVEY BY: WESTERN RESERVE ENGINEERING & SURVEYING CO., 1992

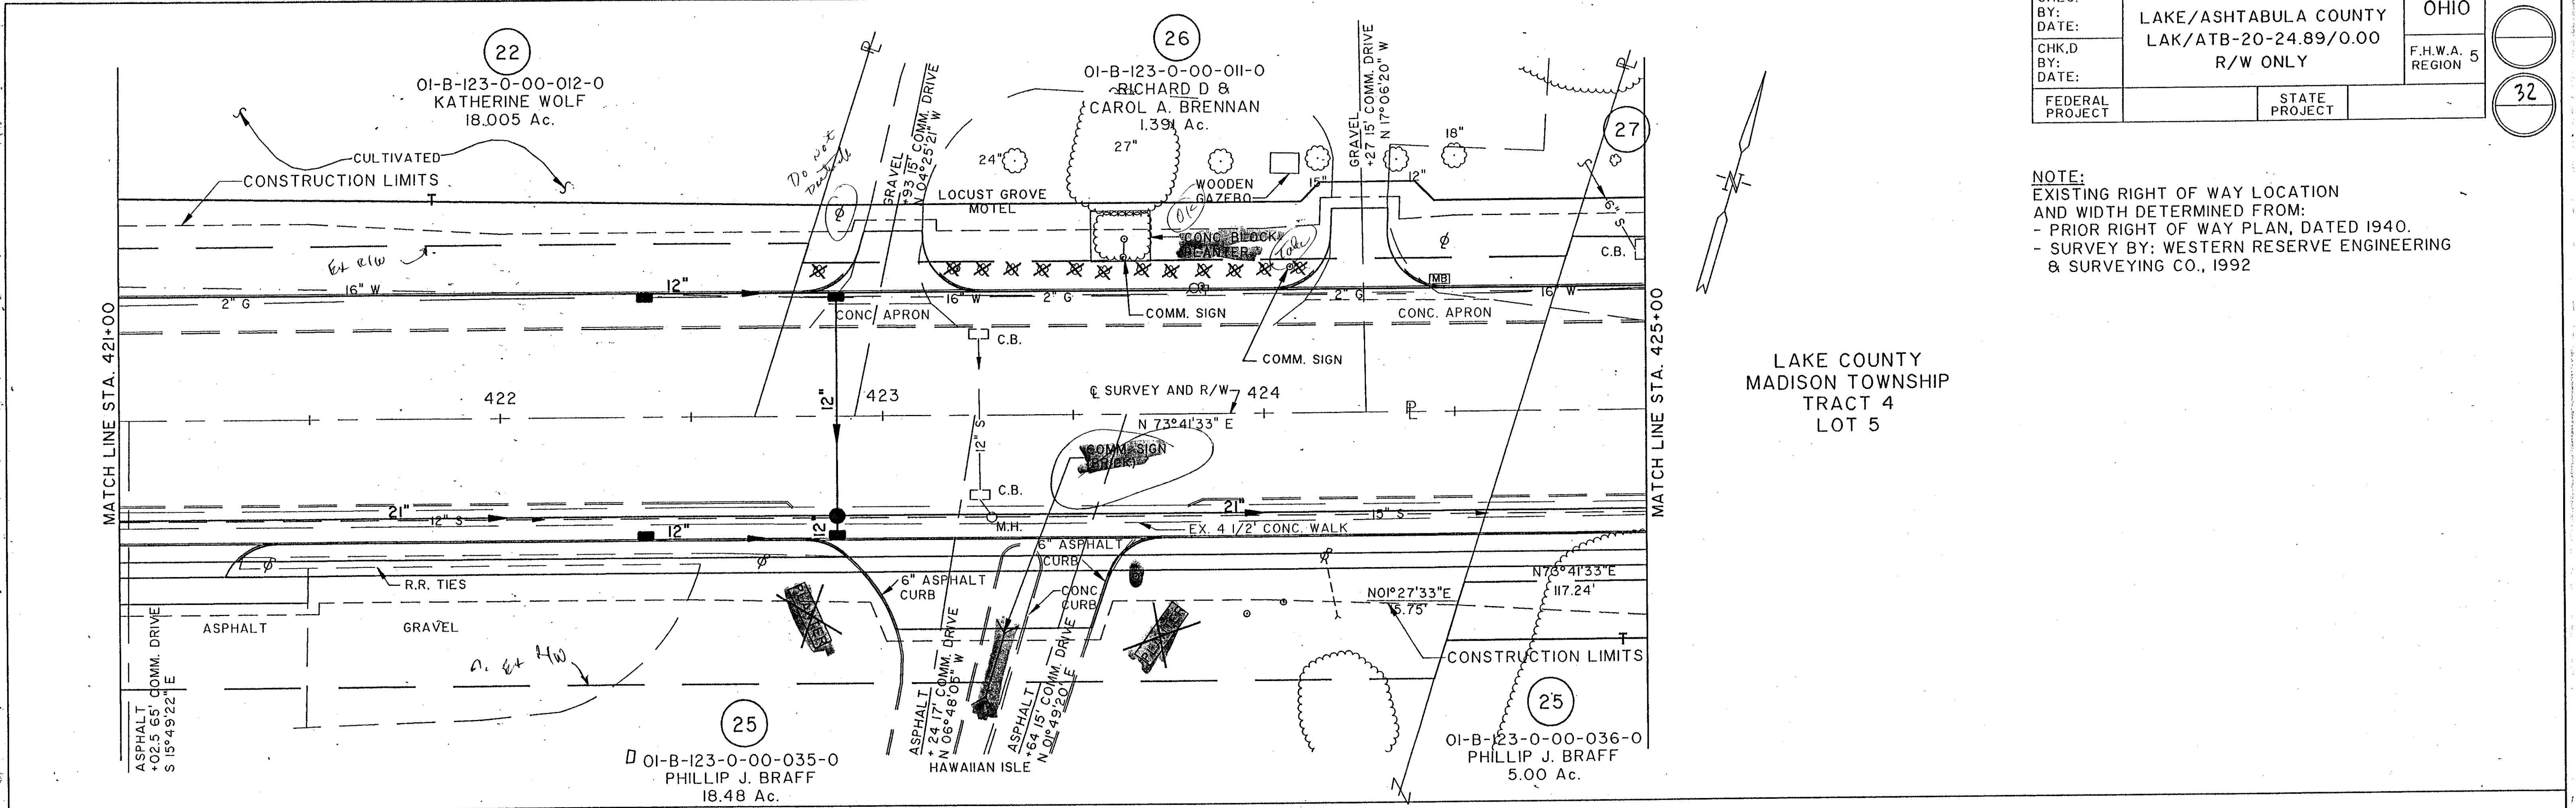

Drawn By/Date: TN / 03-03-94 (17)

COMPLETION DATE:

REV.	DATE	DESCRIPTION

RIGHT-OF-WAY PLAN U.S. 20 STA. 421+00 TO STA. 425+00