CALC. BY: DATE:	LAKE/ASHTABULA COUNTY LAK/ATB-20-24.89/0.00 R/W ONLY		OHIO
CHK,D BY: DATE:			F.H.W.A. REGION 5
FEDERAL PROJECT		STATE PROJECT	

40

NOTE:
EXISTING RIGHT OF WAY LOCATION
AND WIDTH DETERMINED FROM:
- PRIOR RIGHT OF WAY PLAN, DATED 1940.
- SURVEY BY: WESTERN RESERVE ENGINEERING & SURVEYING CO., 1992

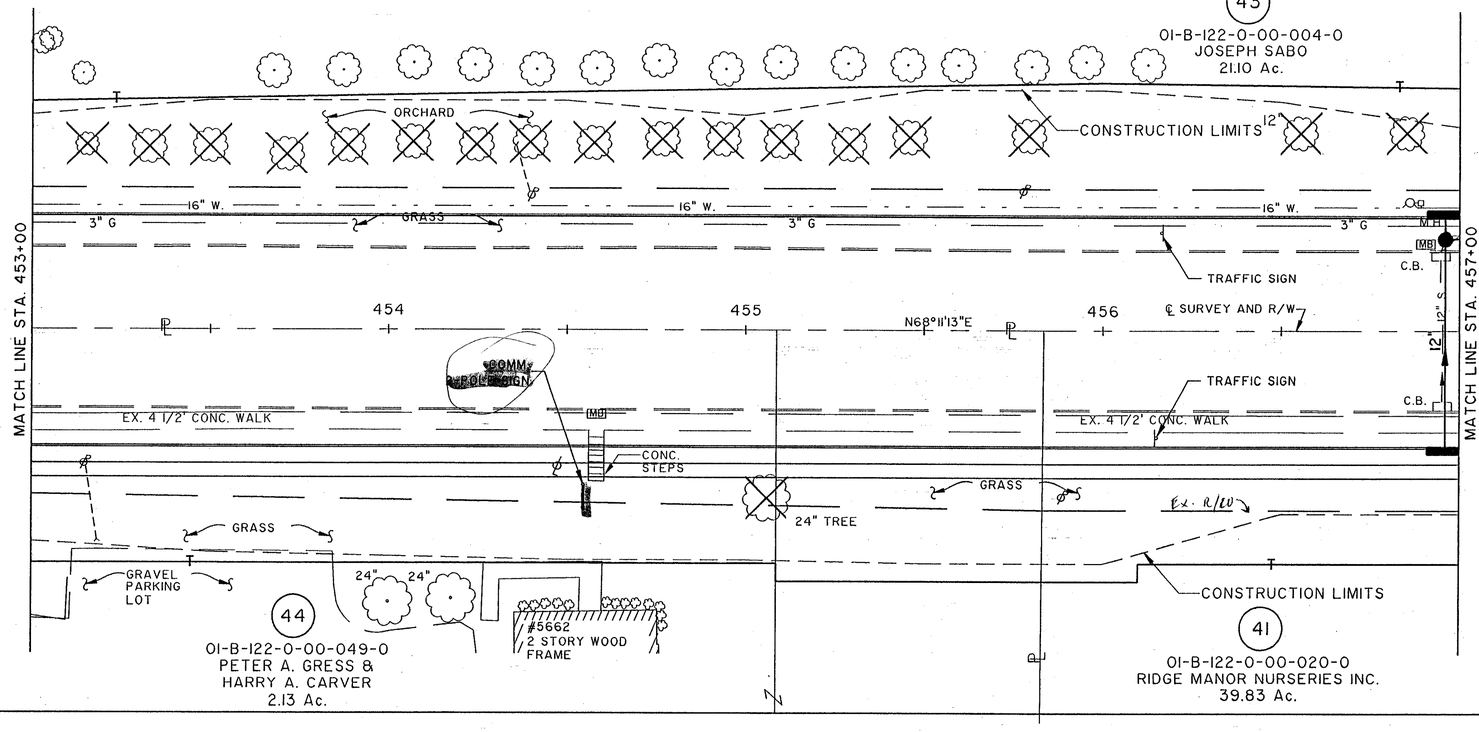

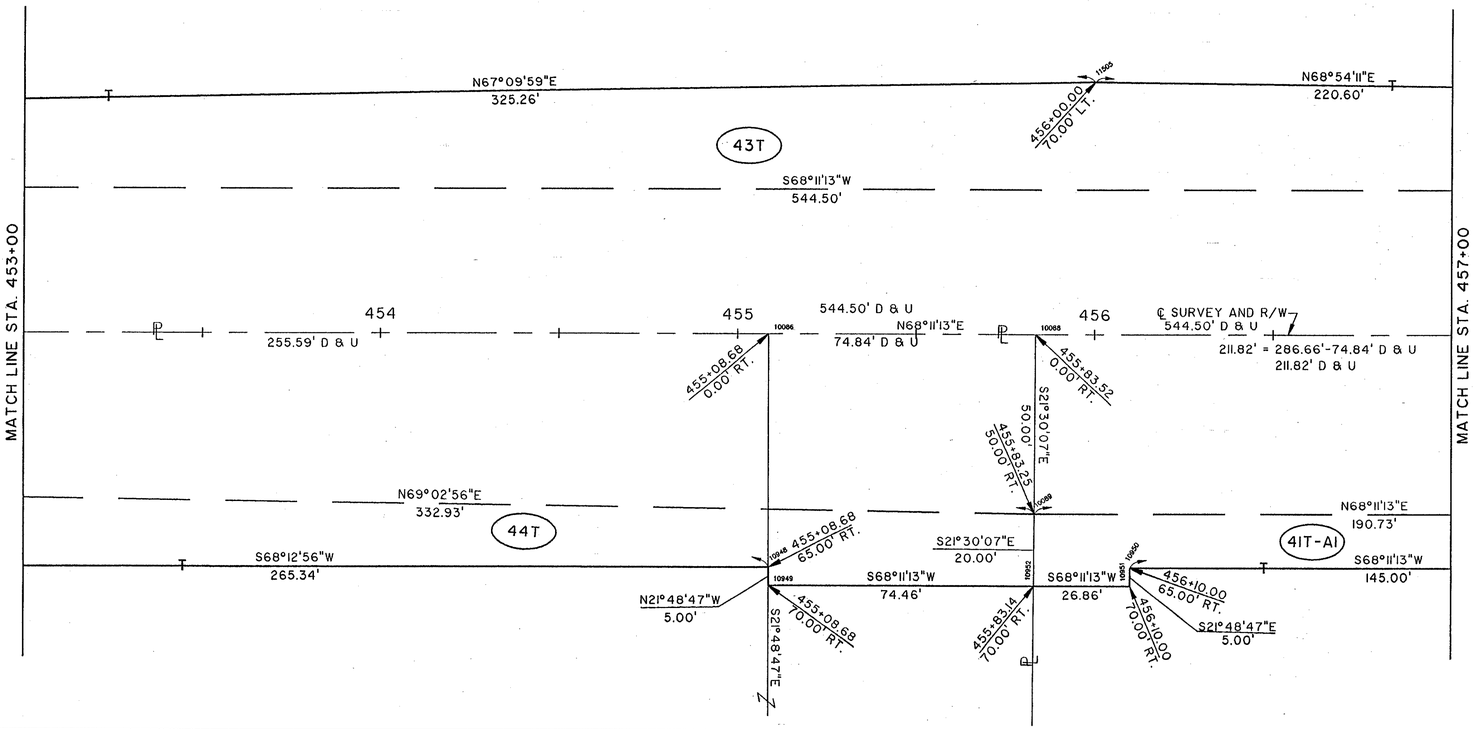

COMPLETION DATE:

REV.	DATE	DESCRIPTION

NORTH RIDGE ROAD (U.S. 20)

RIGHT-OF-WAY PLAN U.S. 20 STA. 453+00 TO STA 457+00

Filename : K:\ODOT\0007\9975\STRUCT\9975S950
Plot Scale : 1.000 '/ Inch
Drawn By/Date : ZN / 01-25-94 (10)