

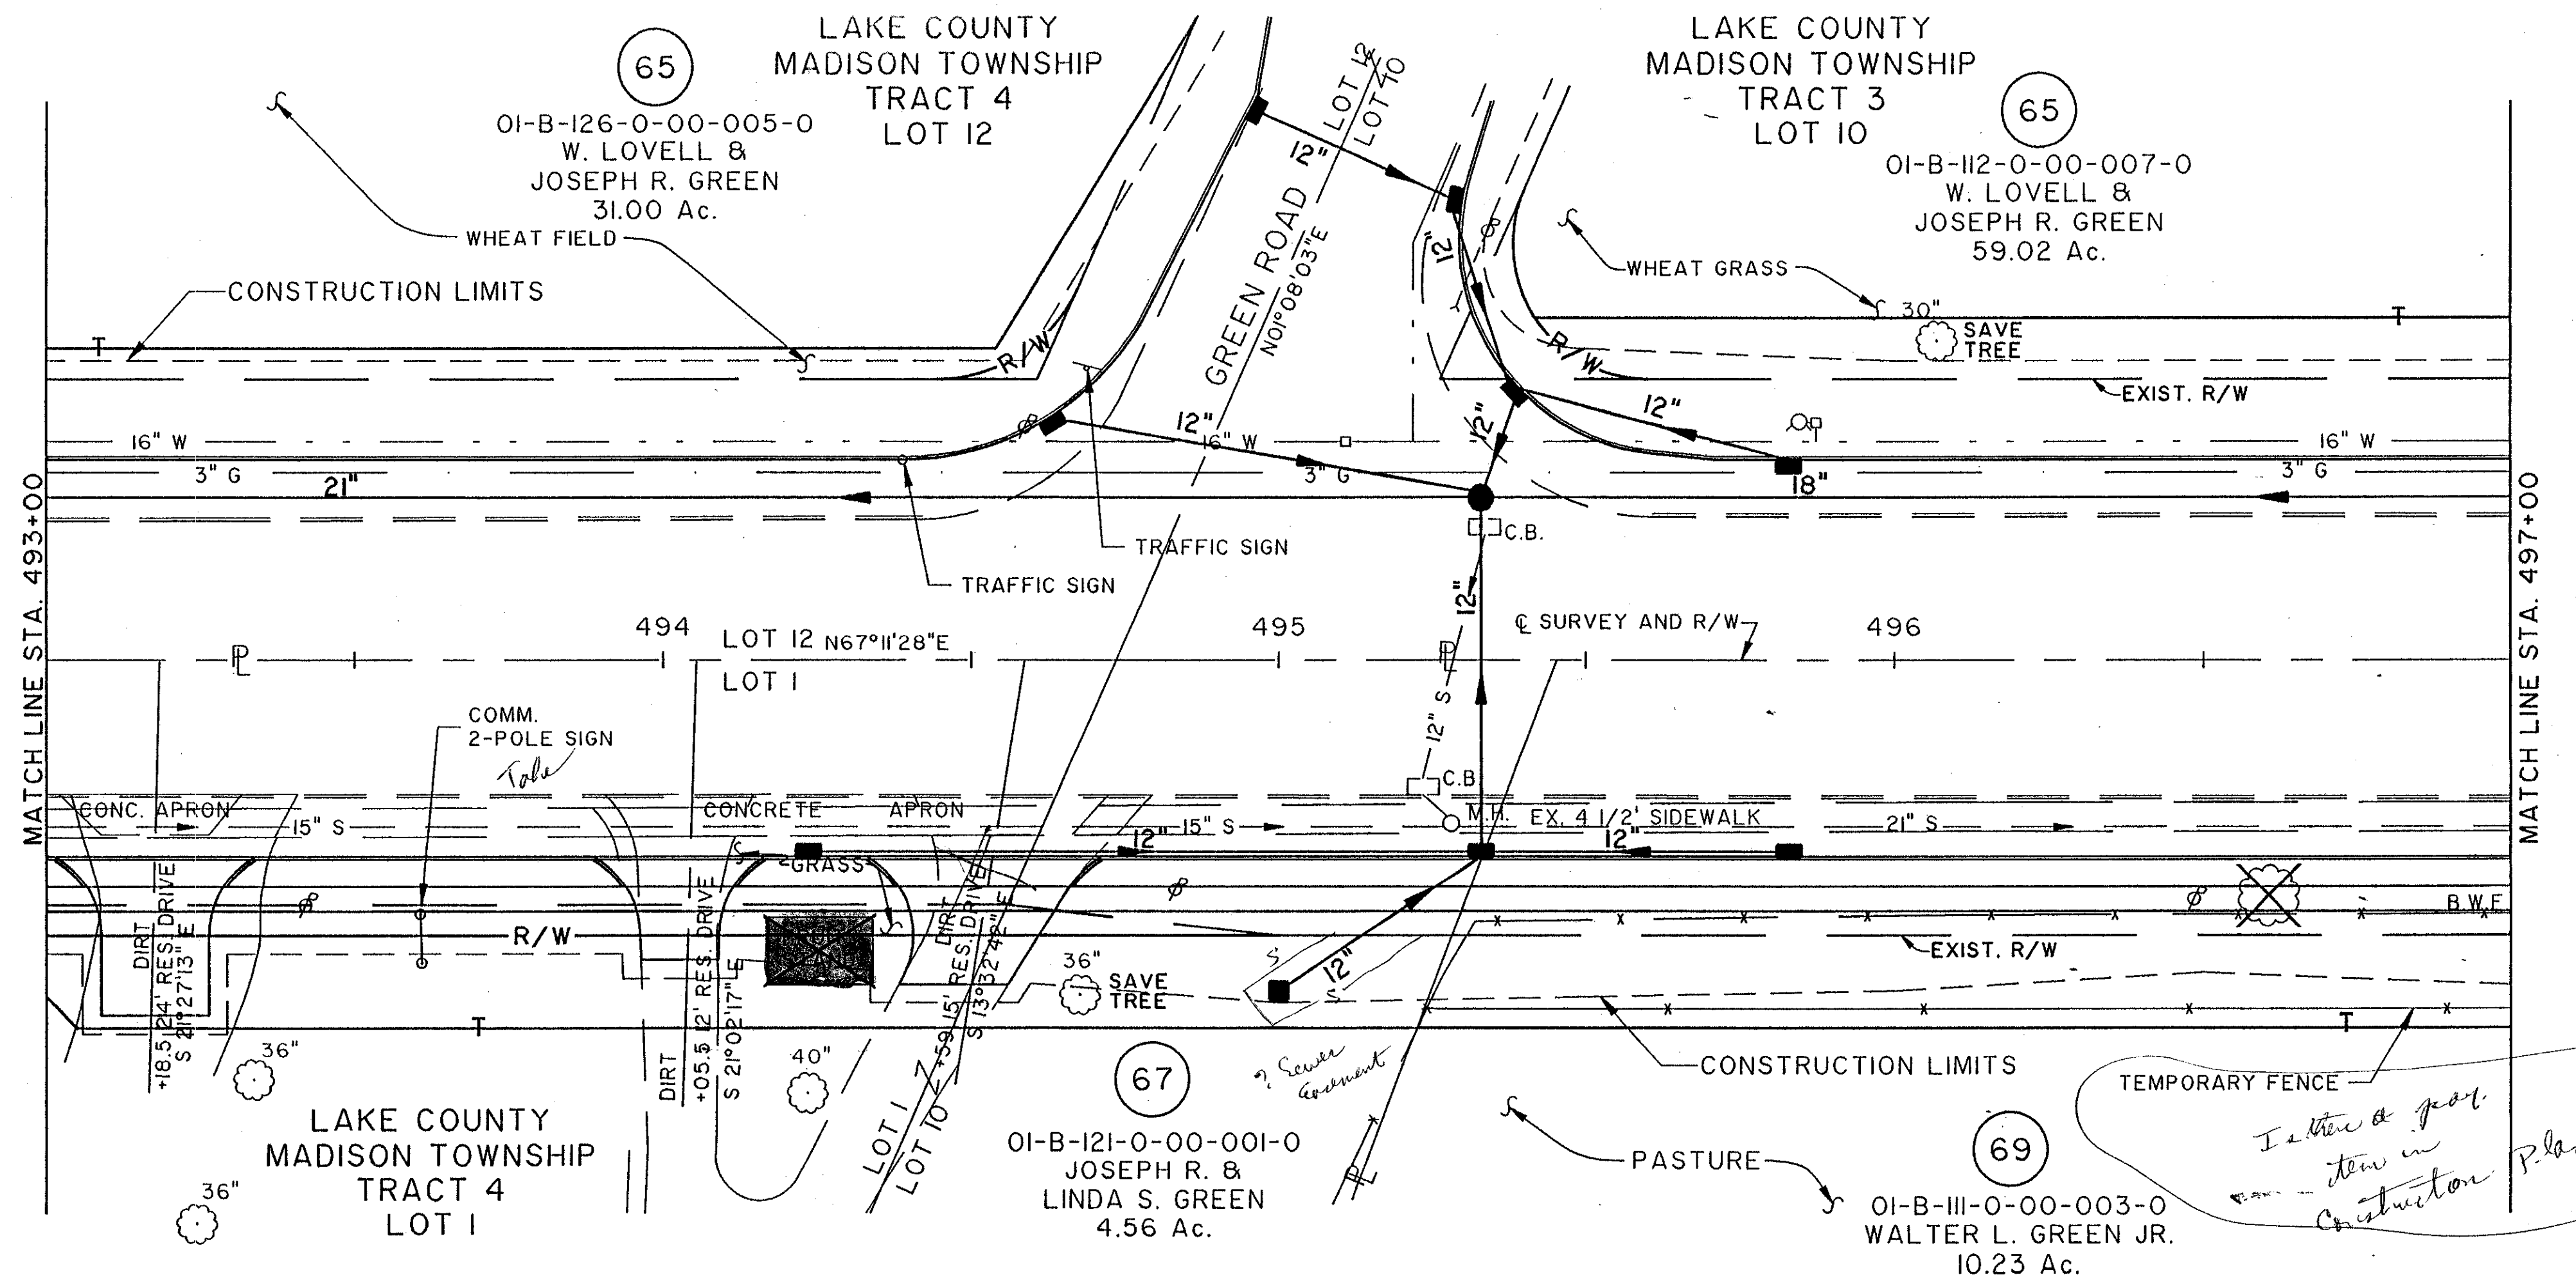


CALC. BY:	LAKE/ASHTABULA COUNTY	OHIO
DATE:	LAK/ATB-20-24.89/0.00	F.H.W.A. 5 REGION
CHK.D BY:	R/W ONLY	
DATE:		
FEDERAL PROJECT	STATE PROJECT	

NOTE:
 EXISTING RIGHT OF WAY LOCATION AND WIDTH DETERMINED FROM:
 - PRIOR RIGHT OF WAY PLAN, DATED 1940.
 - SURVEY BY: WESTERN RESERVE ENGINEERING & SURVEYING CO., 1992

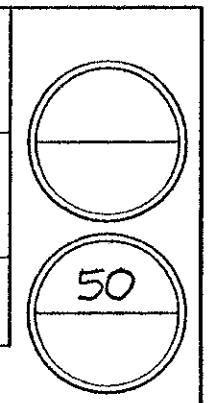

Letter & plot item in Construction Plan ??

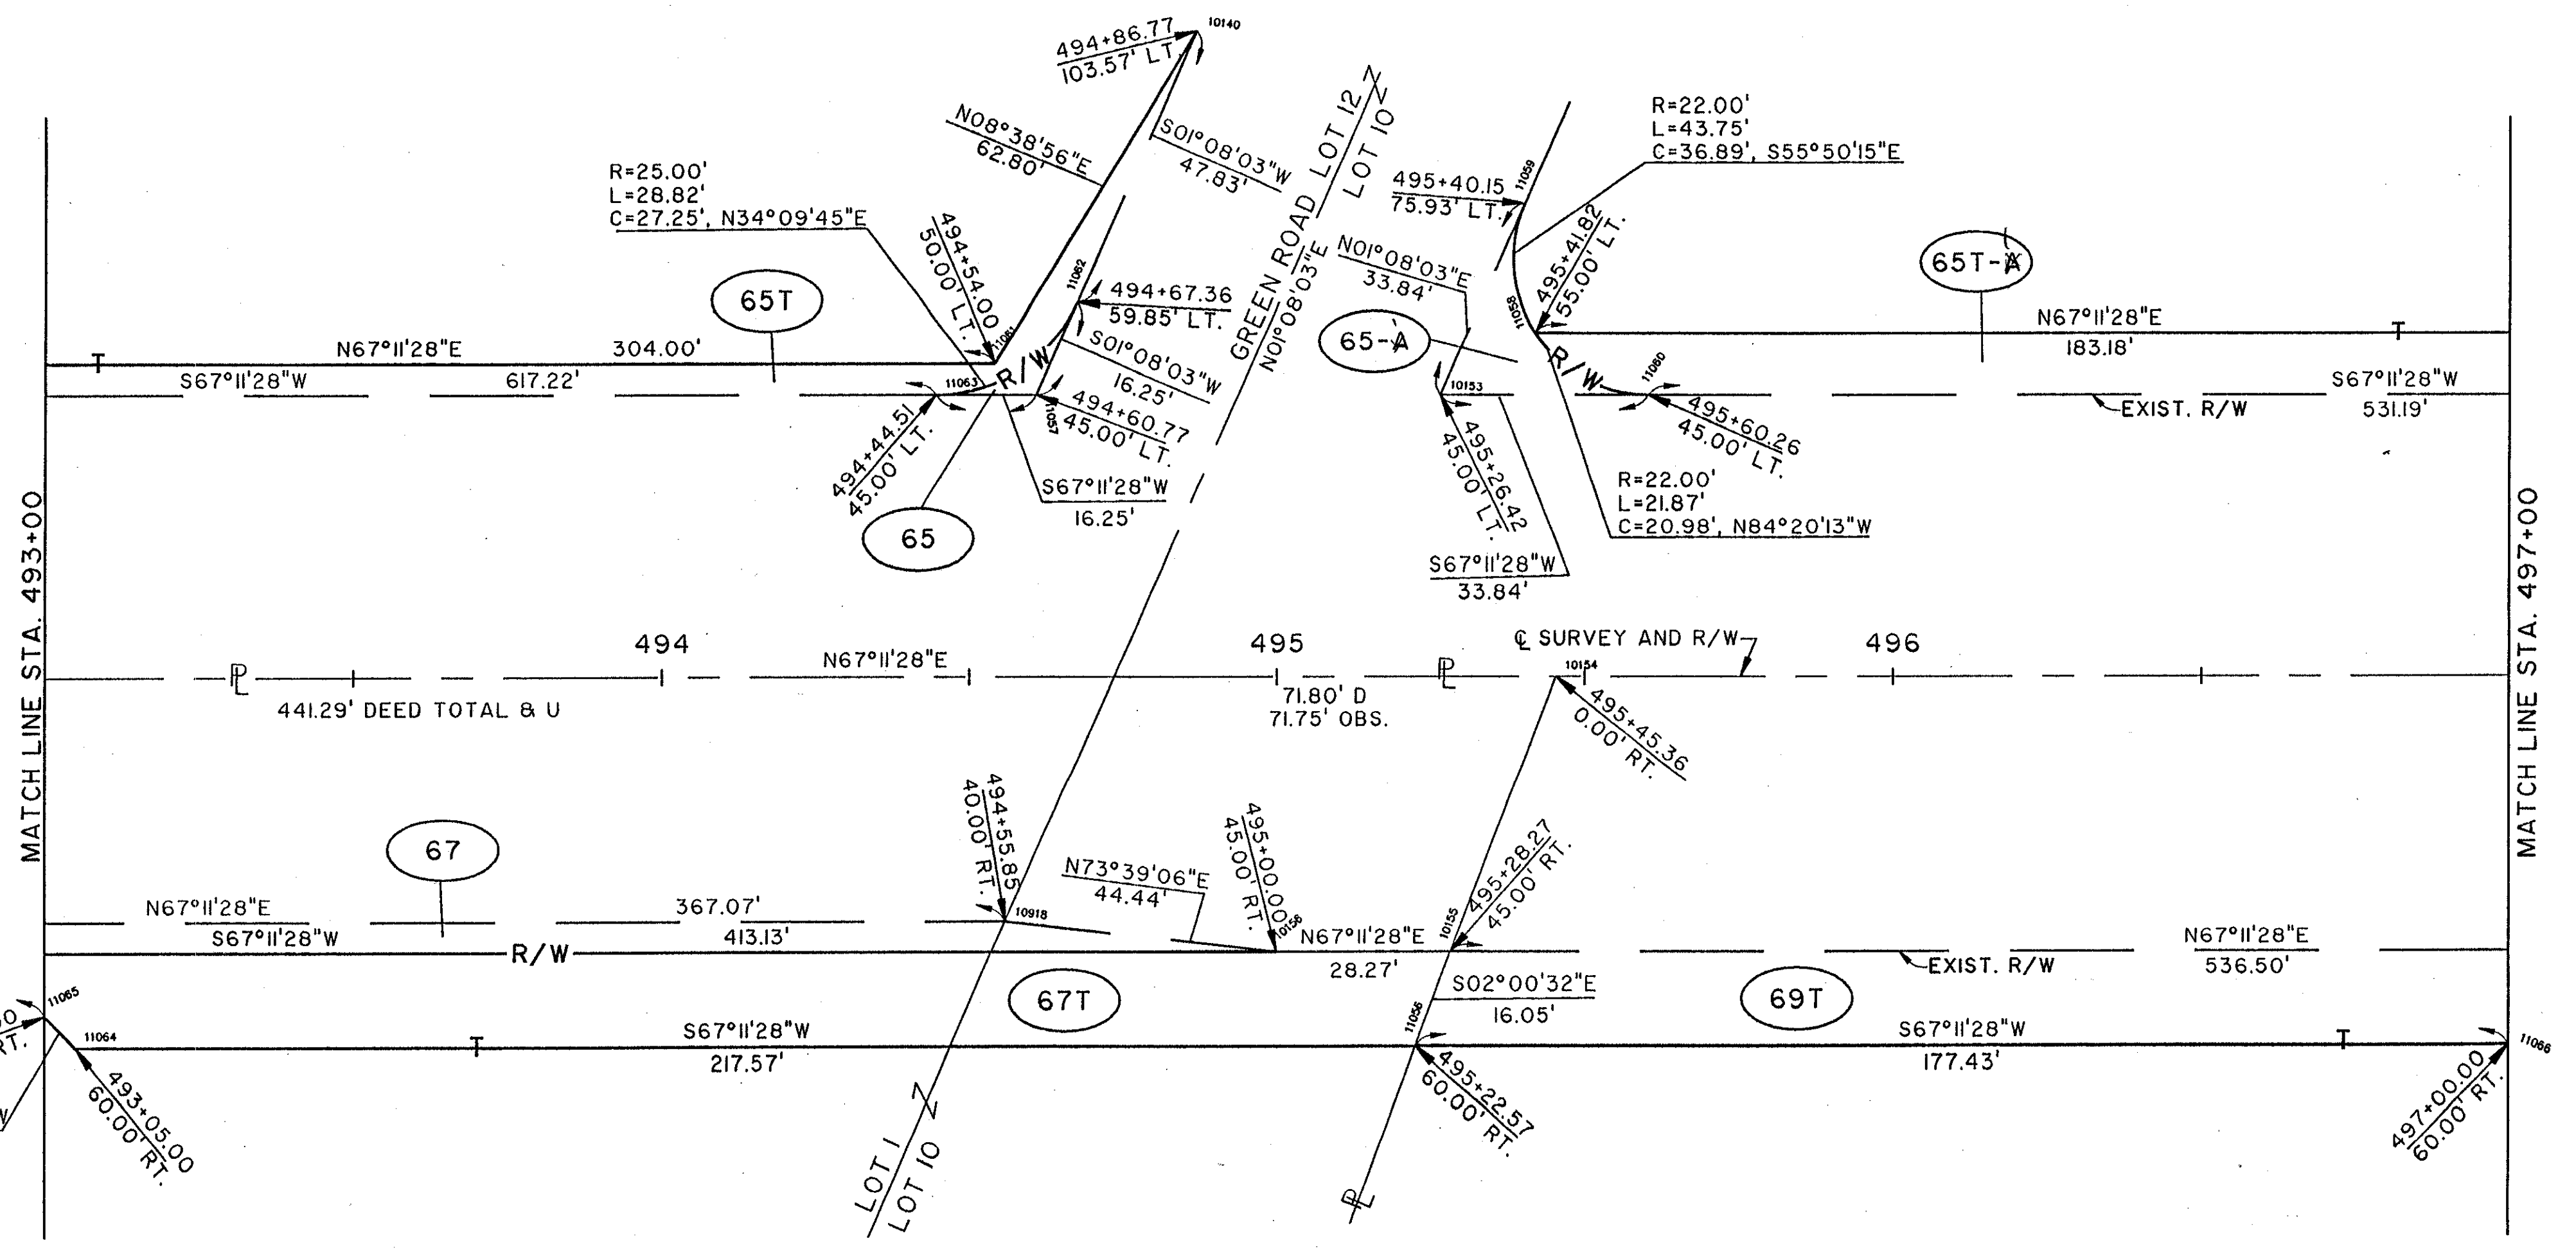

COMPLETION DATE:

REV.	DATE	DESCRIPTION

File name: K:\ADL\0007\9975\STRUC\99752570
 Plot Scale: 1"=40'
 Drawn BY: Date: 20/02/24/94 (11)

NORTH RIDGE ROAD (U.S. 20)