

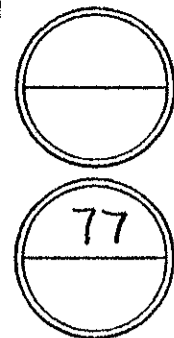


LAKE COUNTY  
MADISON TOWNSHIP  
TRACT 2  
ELY LOT

CALC. BY:	LAKE/ASHTABULA COUNTY	OHIO
CHK. D DATE:	LAK/ATB-20-24.89/0.00	F.H.W.A. REGION 5
BY:	R/W ONLY	
DATE:		
FEDERAL PROJECT	STATE PROJECT	

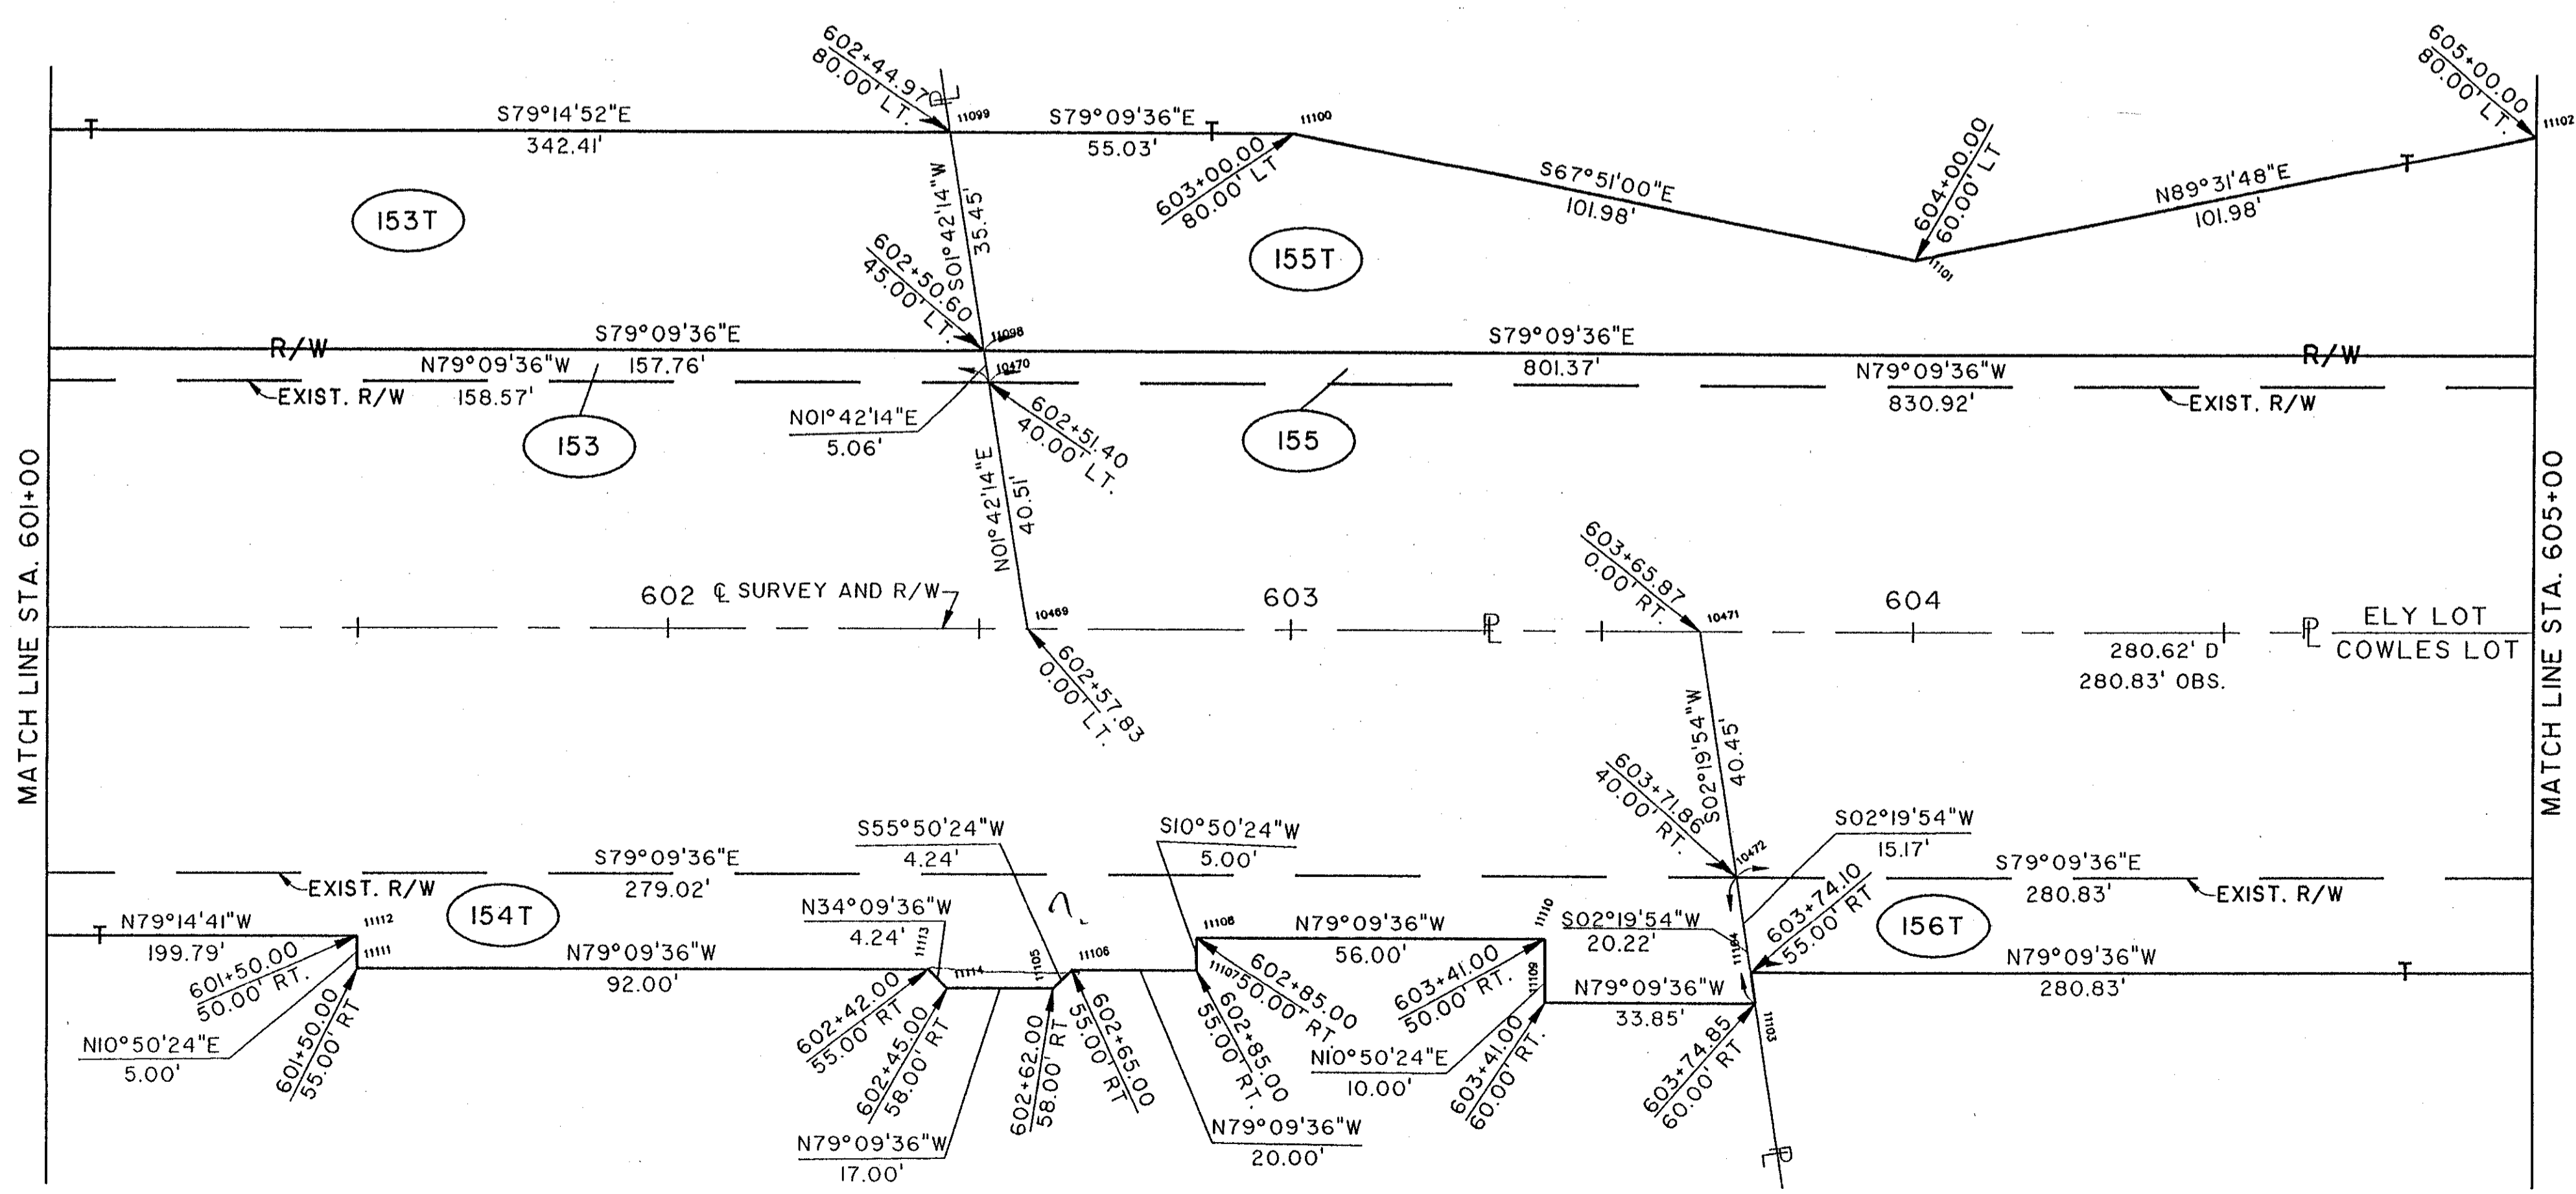

NOTE:  
EXISTING RIGHT OF WAY LOCATION  
AND WIDTH DETERMINED FROM:  
- PRIOR RIGHT OF WAY PLAN, DATED 1940.  
- SURVEY BY: WESTERN RESERVE ENGINEERING  
& SURVEYING CO., 1992

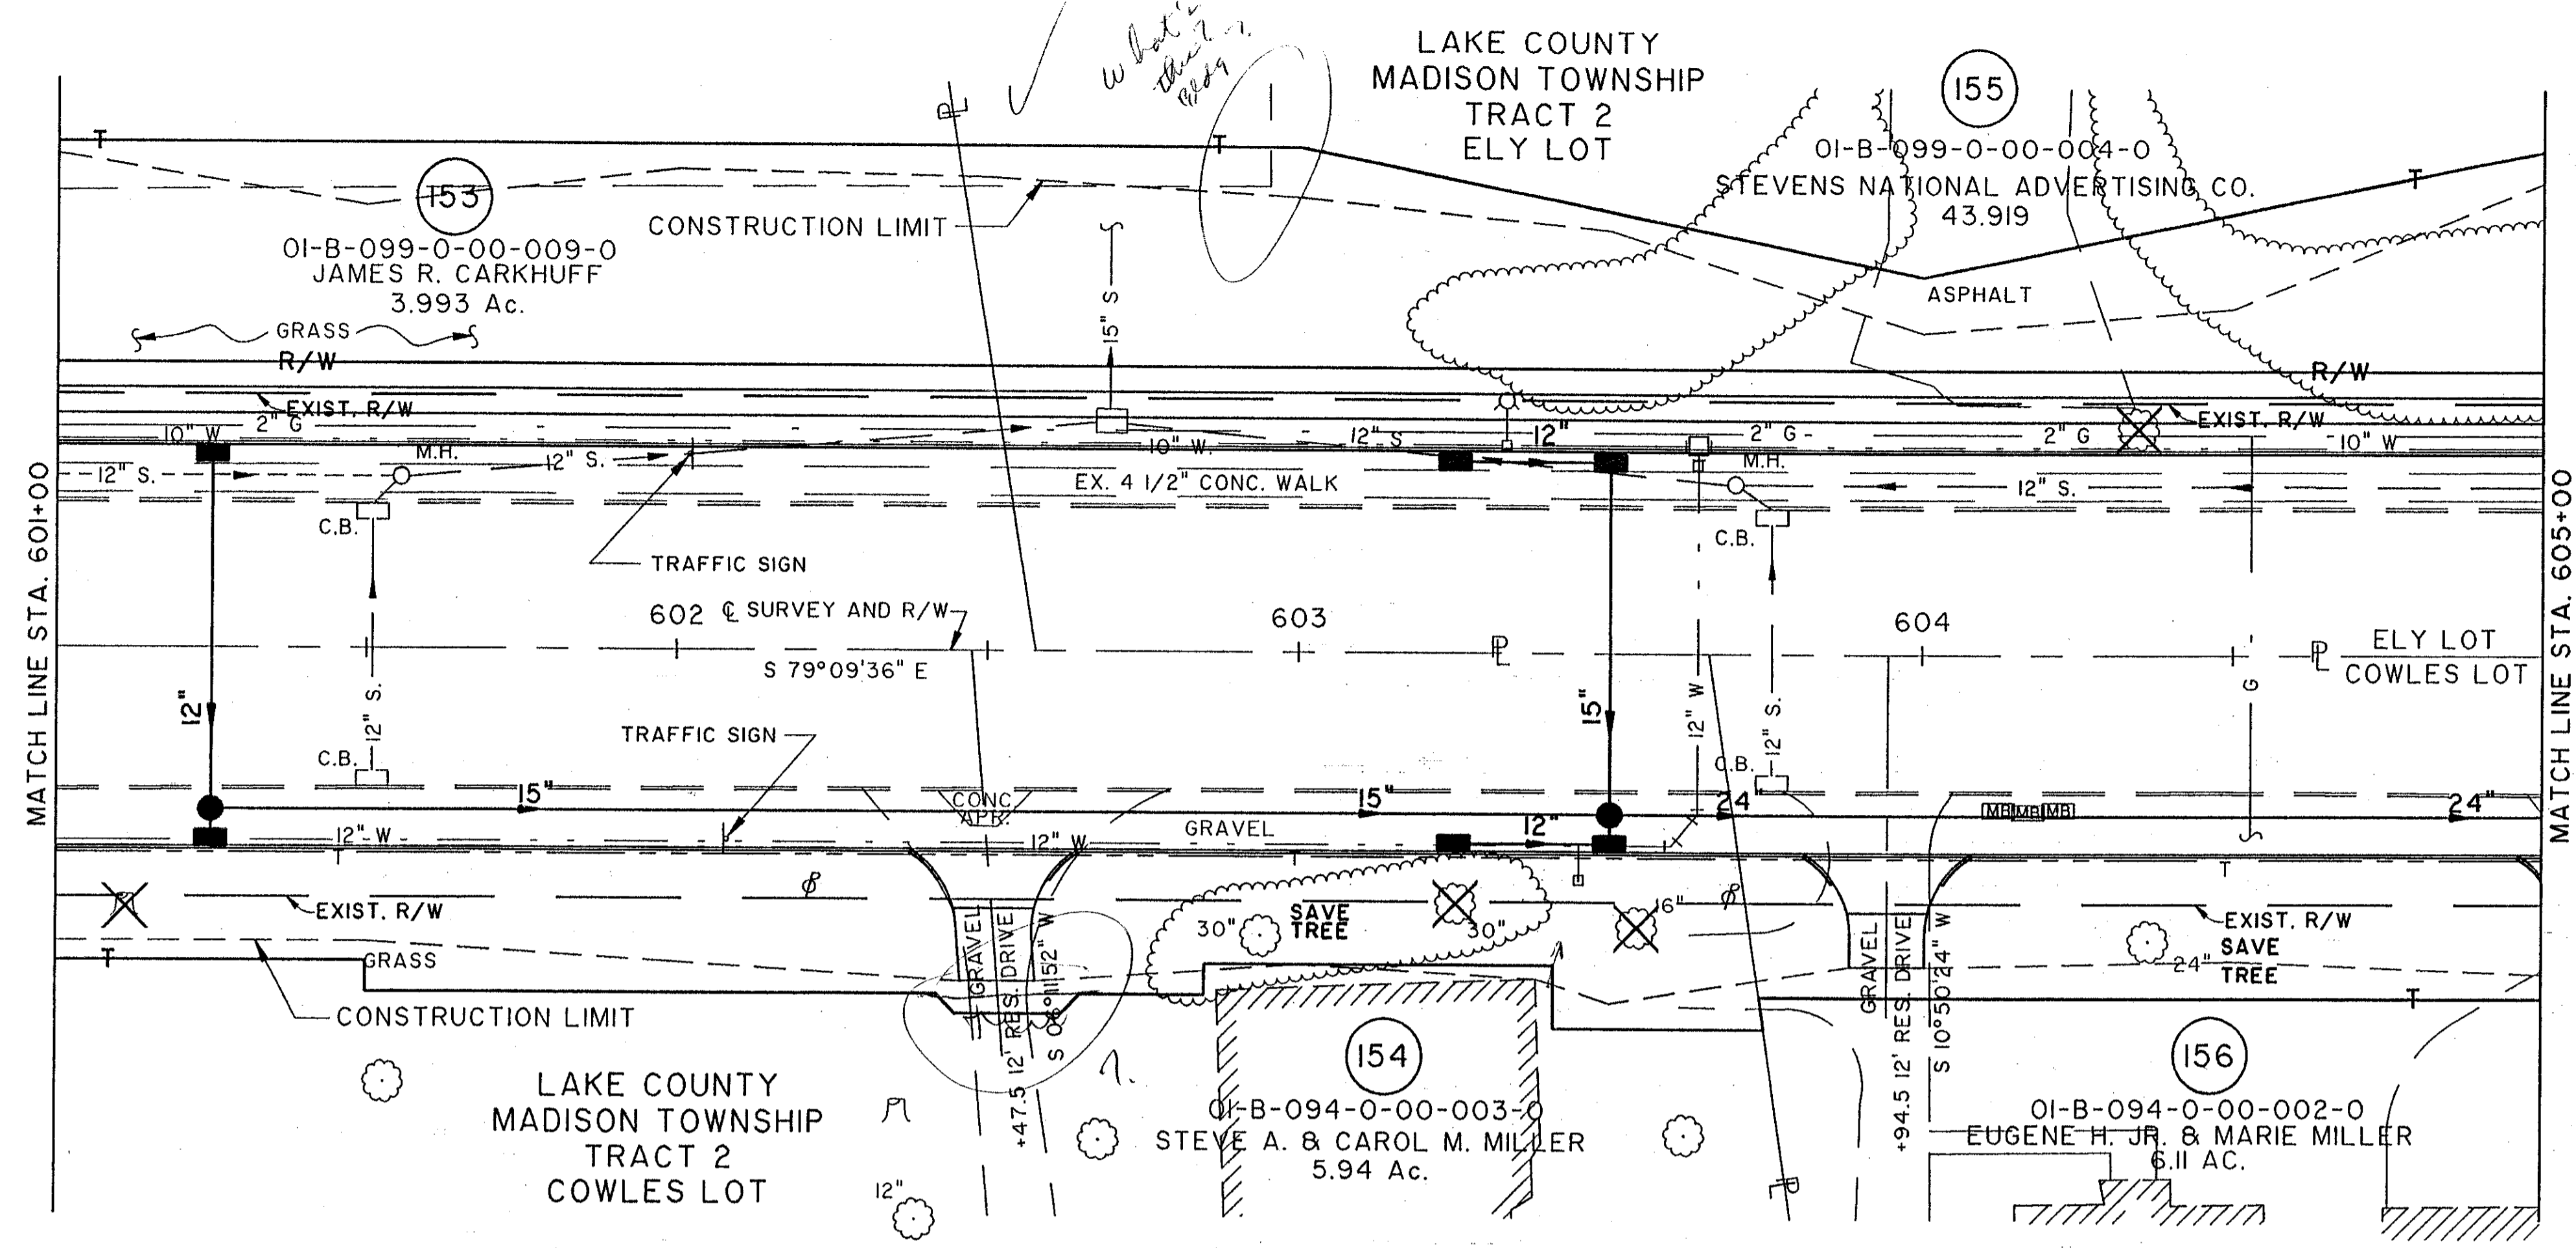

Elevation: K:\VOLI\ODOT\8875\STRUCT\88755653  
 File: Scale: 1" = 40'  
 Drawn By: Date: 10-25-94 (18)

COMPLETION DATE:

REV.	DATE	DESCRIPTION

RIGHT-OF-WAY PLAN U.S. 20 STA. 601+00 TO STA. 605+00

NORTH RIDGE ROAD (U.S. 20)