

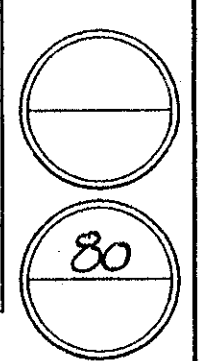


CALC. BY:	LAKE/ASHTABULA COUNTY	OHIO
DATE:	LAK/ATB-20-24.89/0.00	F.H.W.A. REGION 5
CHK.D BY:	R/W ONLY	
DATE:		
FEDERAL PROJECT	STATE PROJECT	

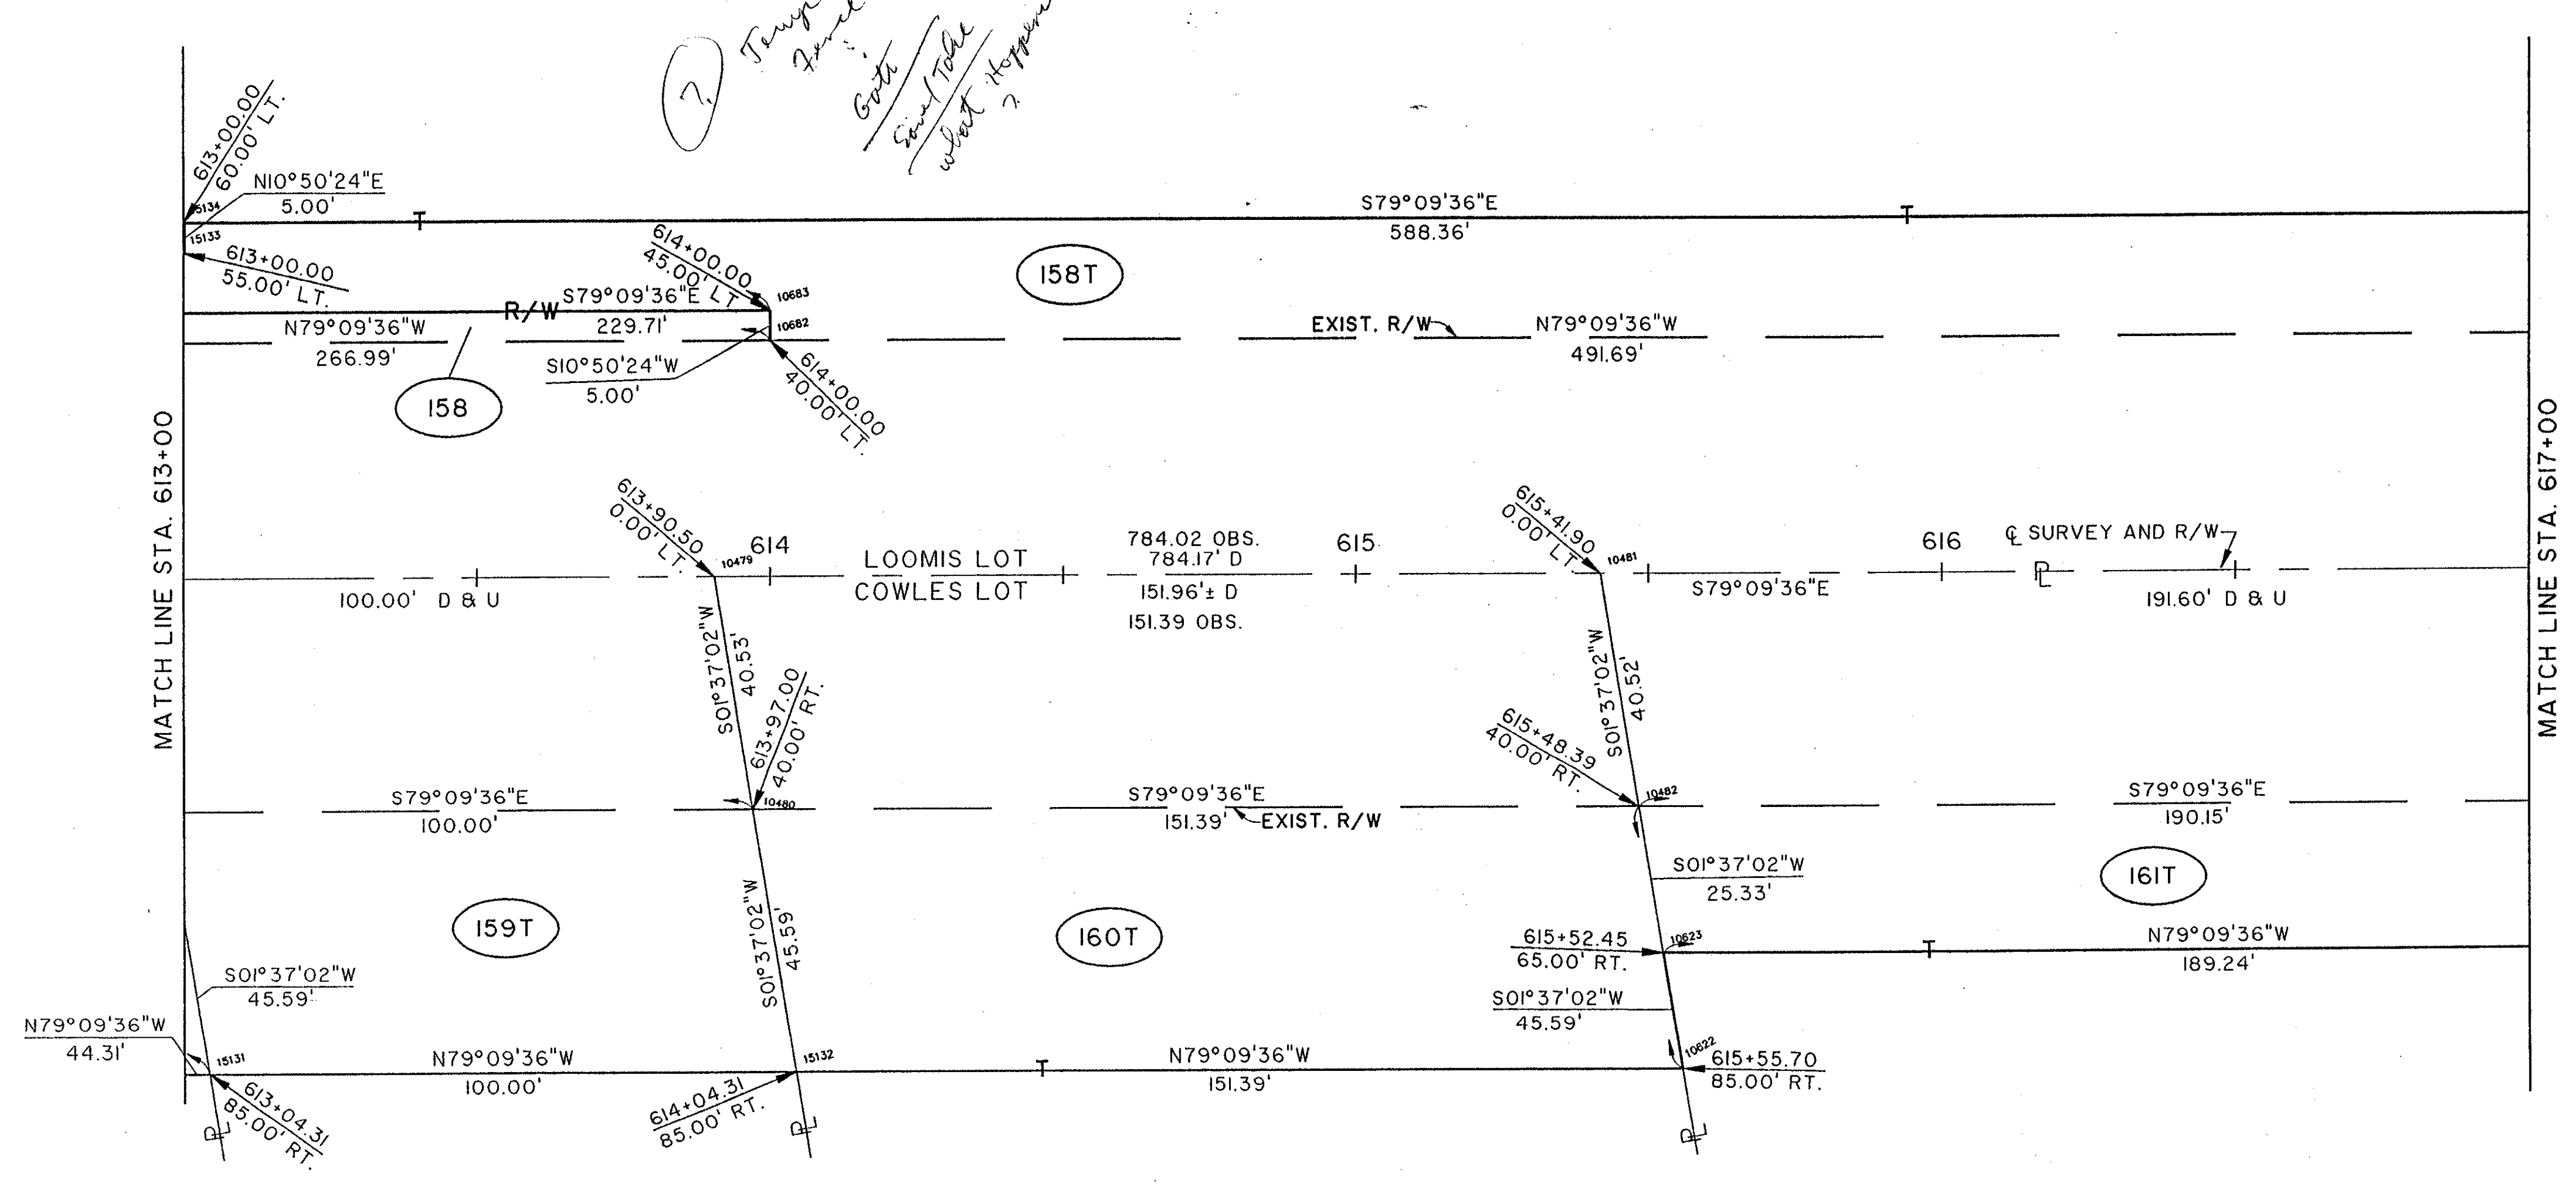

NOTE:  
 EXISTING RIGHT OF WAY LOCATION  
 AND WIDTH DETERMINED FROM:  
 - PRIOR RIGHT OF WAY PLAN, DATED 1940.  
 - SURVEY BY: WESTERN RESERVE ENGINEERING  
 & SURVEYING CO., 1992

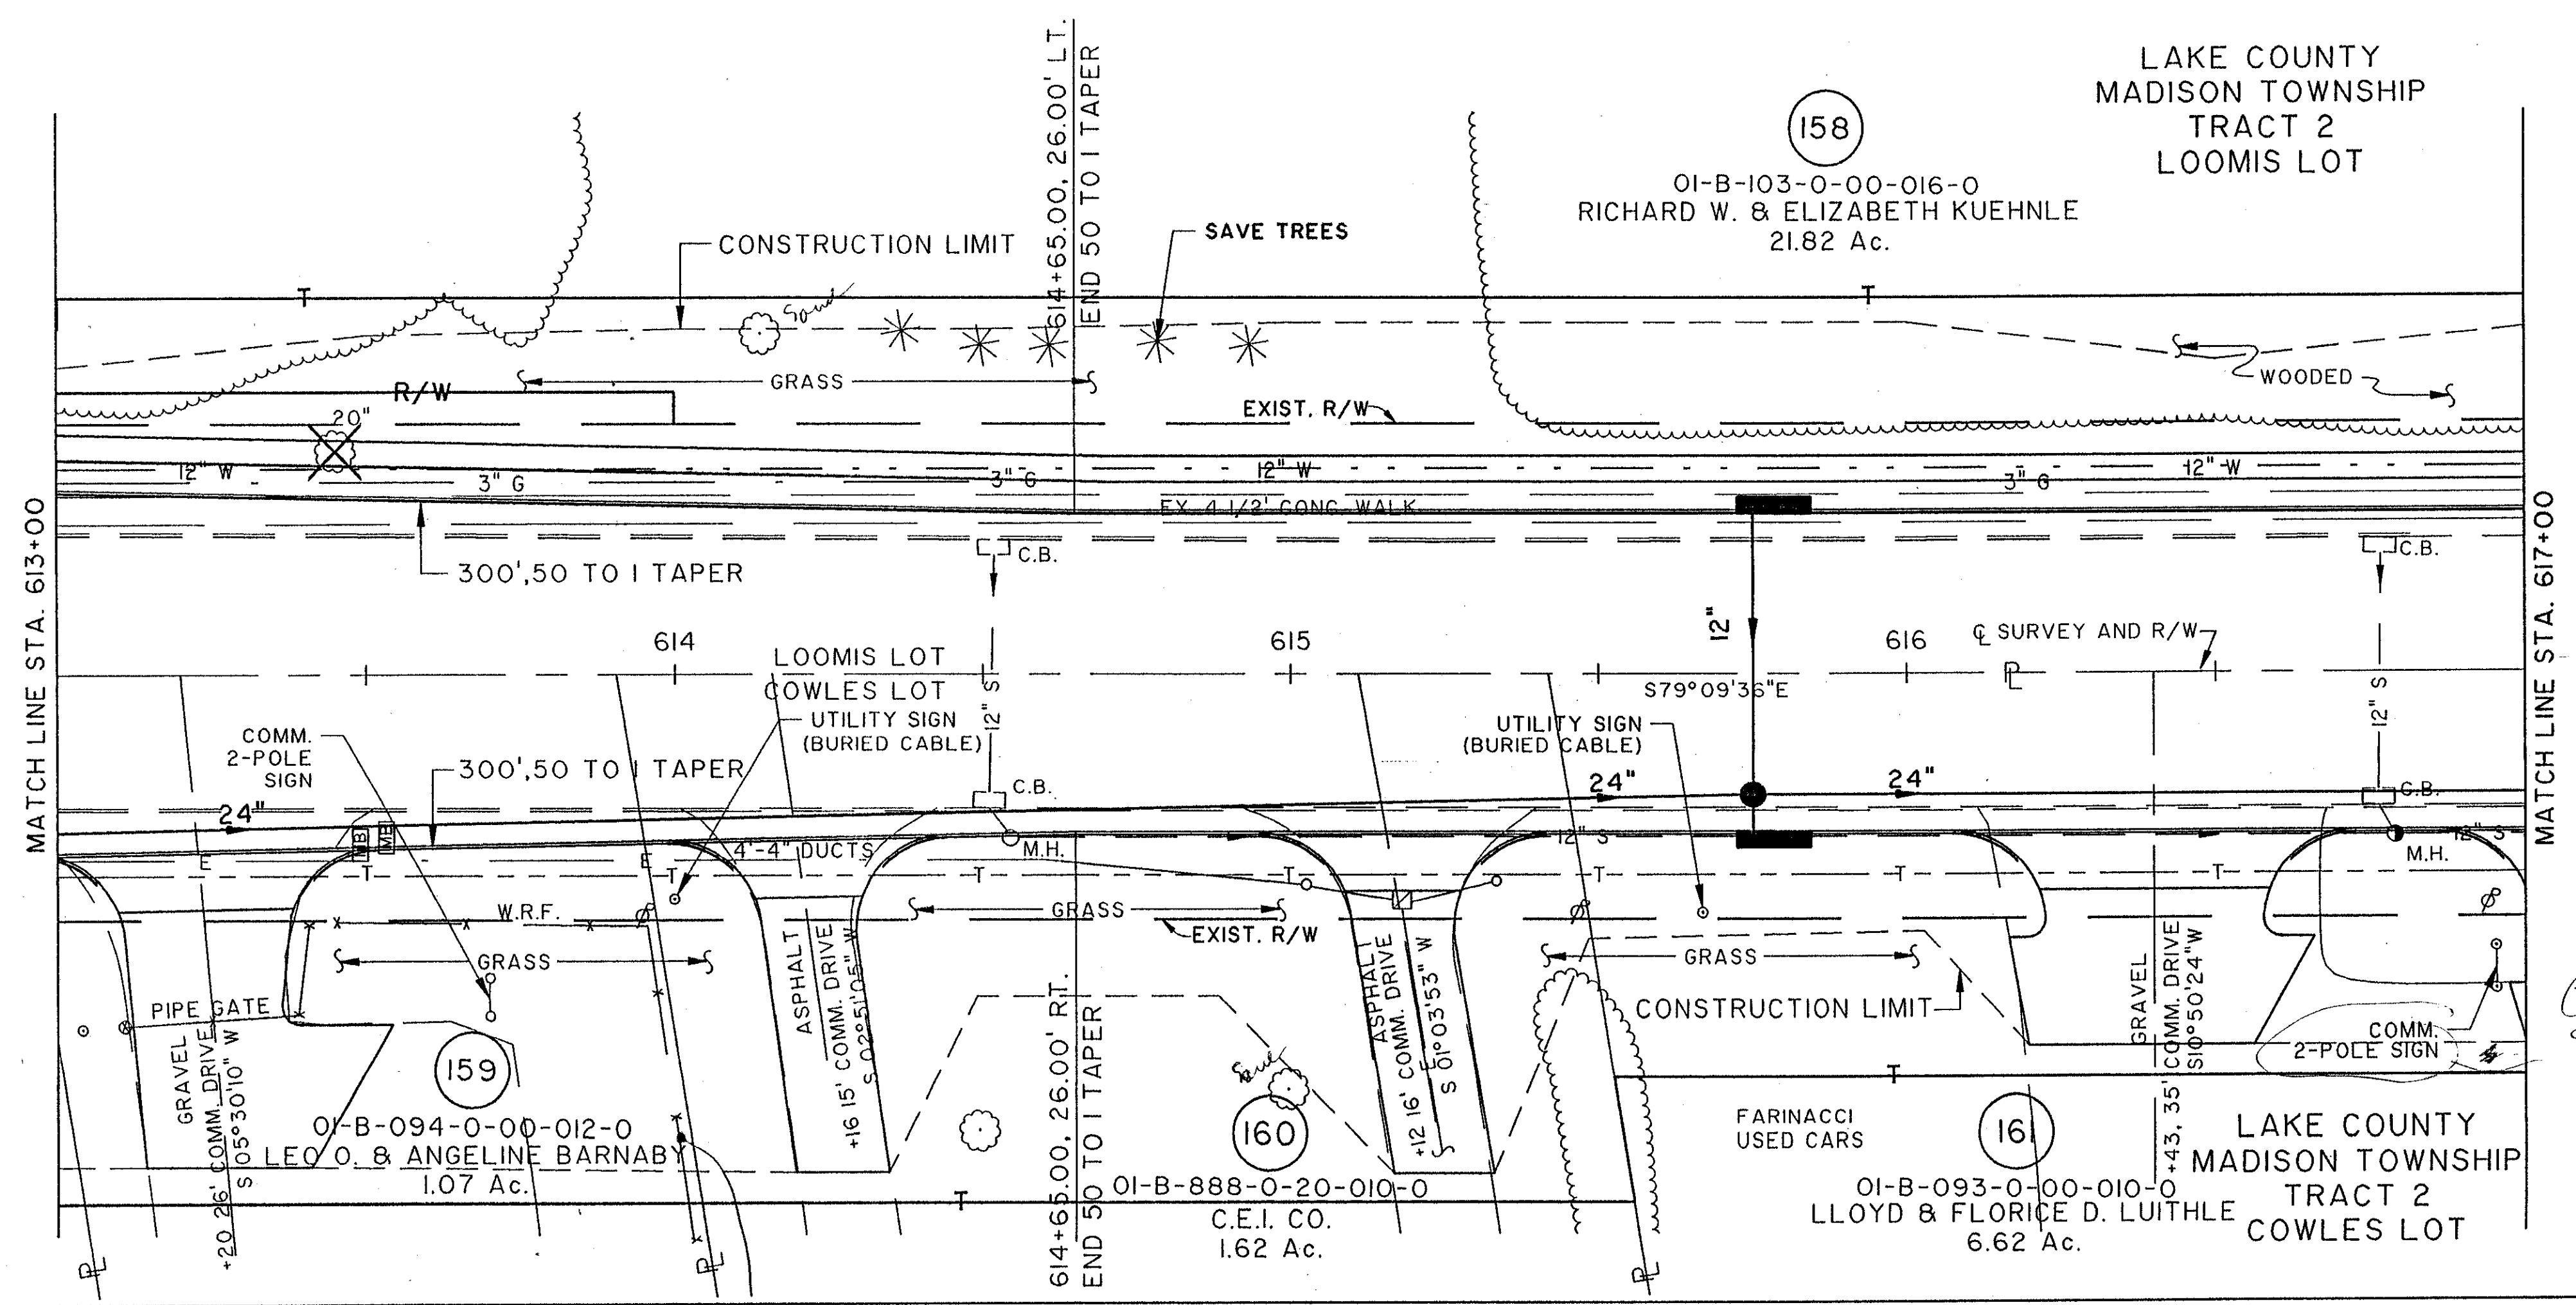

COMPLETION DATE:

REV.	DATE	DESCRIPTION

RIGHT-OF-WAY PLAN U.S. 20 STA. 613+00 TO STA. 617+00

Filename: K:\MUL\0007\8975\STRUCT\8975566  
 Plot Size: 11x17  
 Date: 02-26-94 (10)  
 User: jg

NORTH RIDGE ROAD (U.S. 20)