

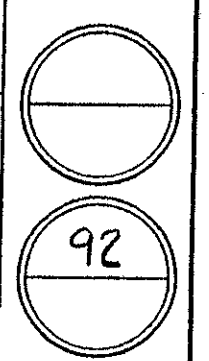


CALC. BY:	LAKE/ASHTABULA COUNTY	OHIO
DATE:	LAK/ATB-20-24.89/0.00	F.H.W.A. REGION 5
CHK. D BY:	R/W ONLY	
DATE:		
FEDERAL PROJECT	STATE PROJECT	

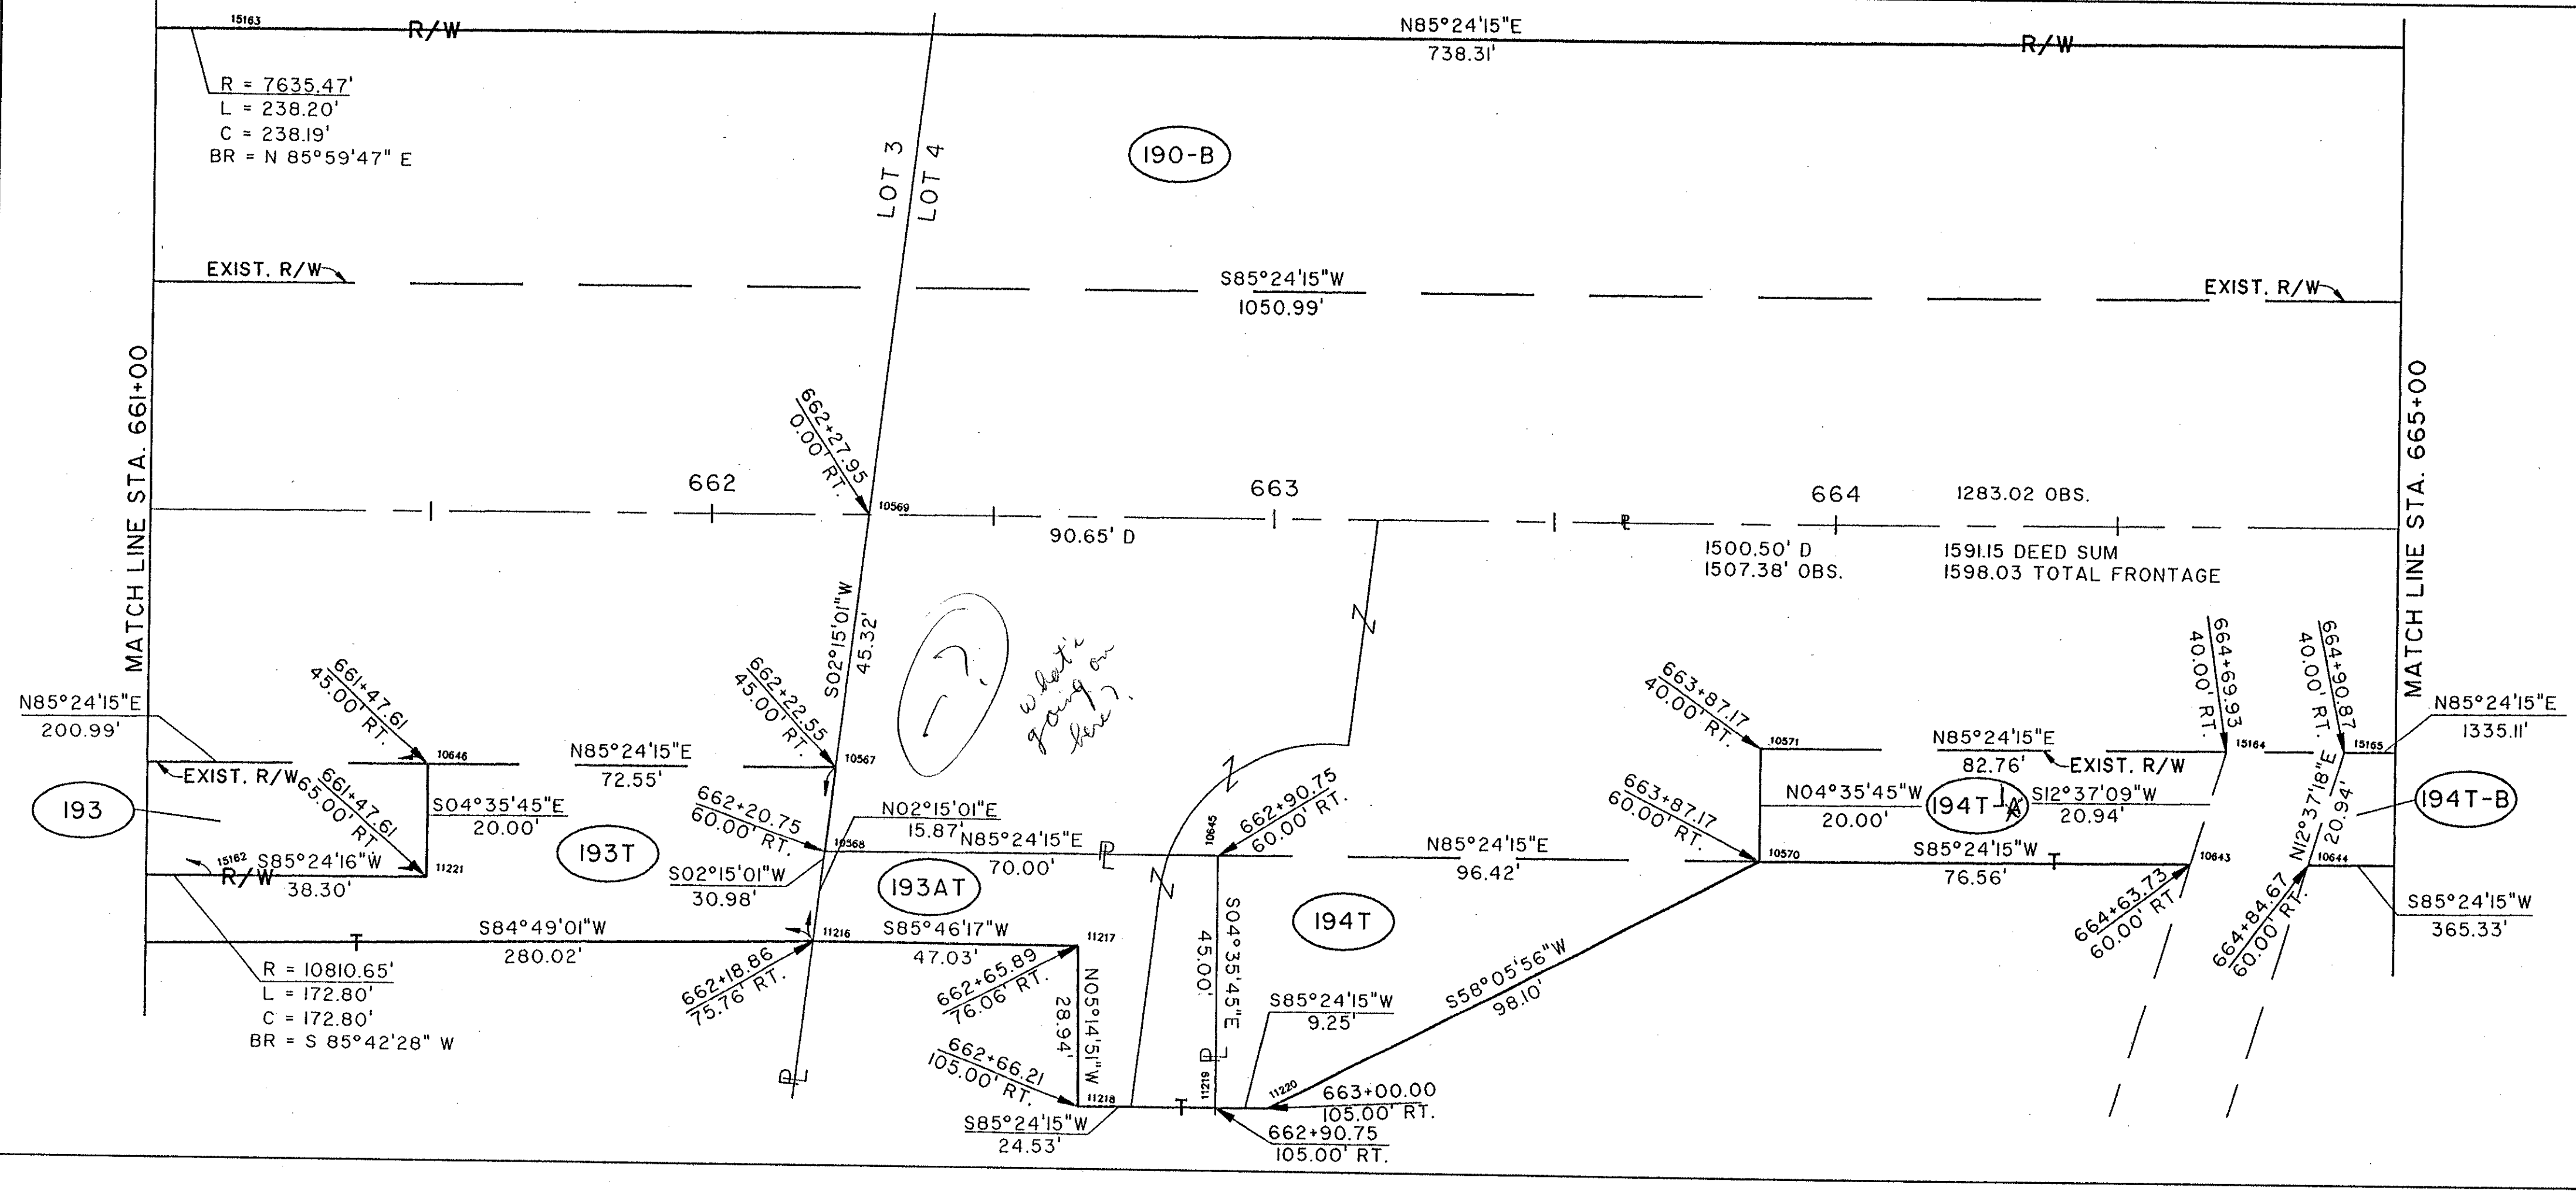

NOTE:
 EXISTING RIGHT OF WAY LOCATION AND WIDTH DETERMINED FROM:
 - PRIOR RIGHT OF WAY PLAN, DATED 1940.
 - SURVEY BY: WESTERN RESERVE ENGINEERING & SURVEYING CO., 1992

PI STA.	= 655+63.18
Δ	= 15°26'09"
Dc	= 2°00'05"
R	= 2862.89'
Ls	= 325.00'
Os	= 03°15'08"
LT	= 216.70'
ST	= 108.37'
x	= 324.90'
y	= 6.15'
k	= 162.48'
p	= 1.54'
Δc	= 08°55'54"
Lc	= 446.28'
Ts	= 548.14'
Es	= 27.72'
emax	= 0.039%

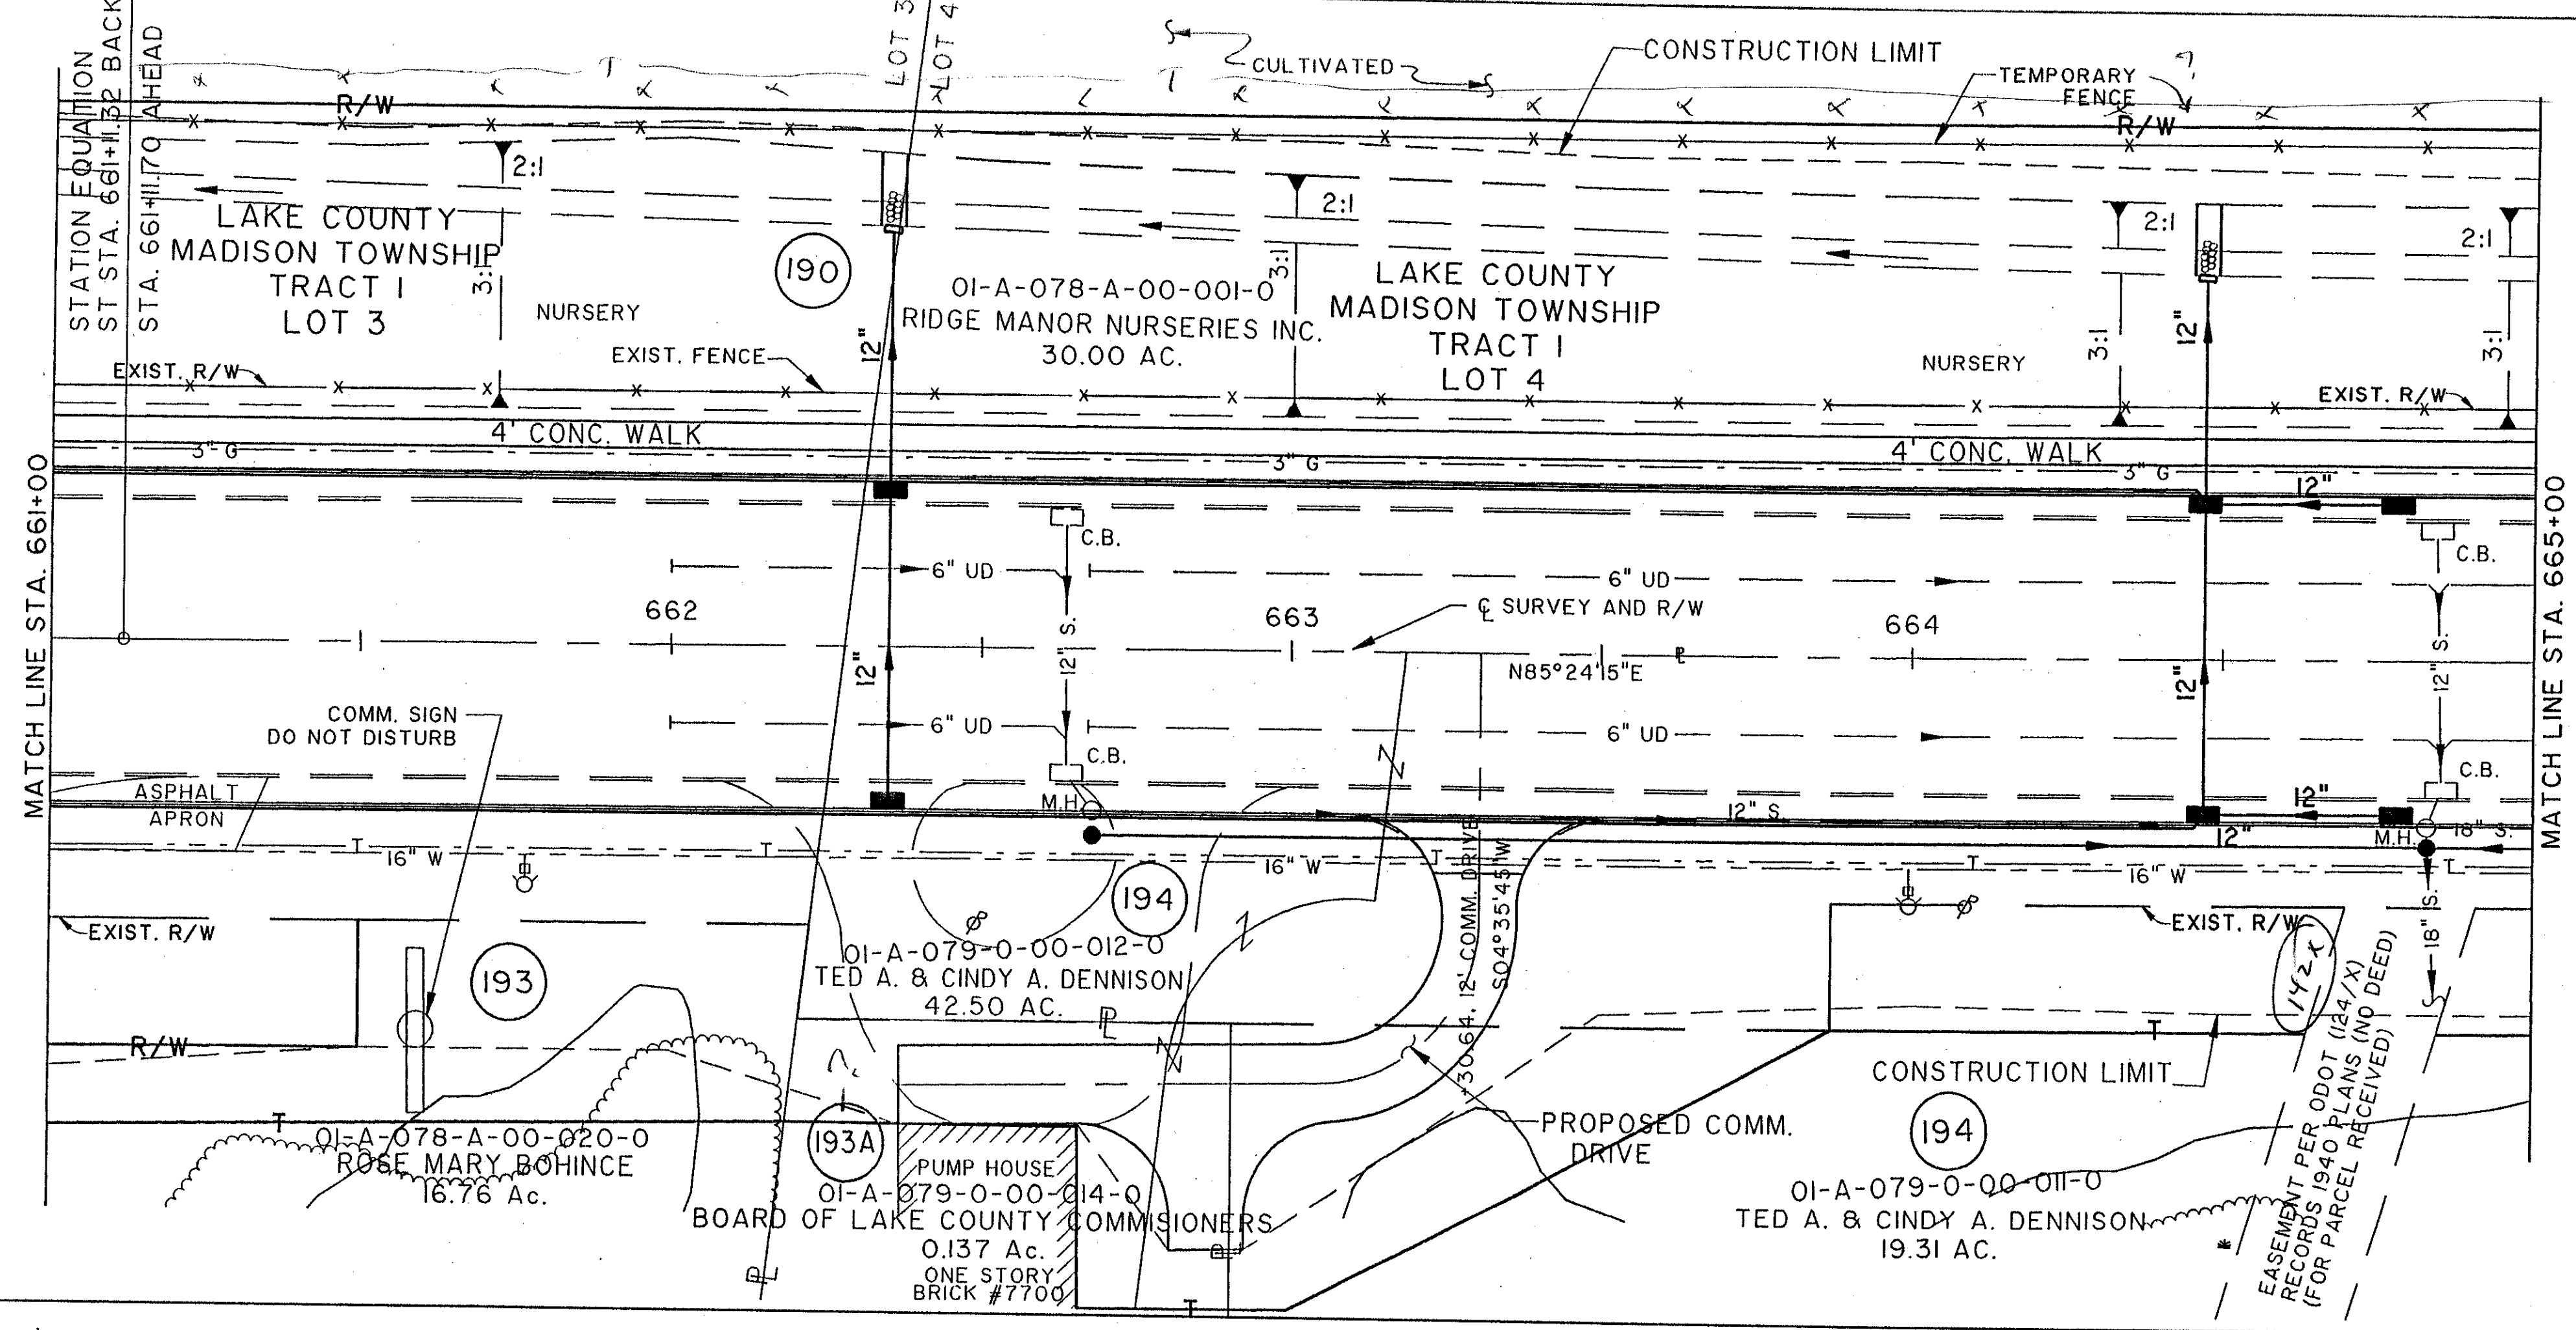

COMPLETION DATE:		
REV.	DATE	DESCRIPTION

RIGHT-OF-WAY PLAN U.S. 20 STA. 661+00 TO STA. 665+00

Files: K:\CL\1007\9975\STRUCT\9975568
 Plot Scale: 1"=40'
 Drawn By/Date: ROK / 03-04-94 (12)