



CALC. BY:	LAKE/ASHTABULA COUNTY	OHIO
DATE:	LAK/ATB-20024.89/0.00	F.H.W.A. 5
CHK. BY:	R/W ONLY	REGION
DATE:		
FEDERAL PROJECT	STATE PROJECT	

98

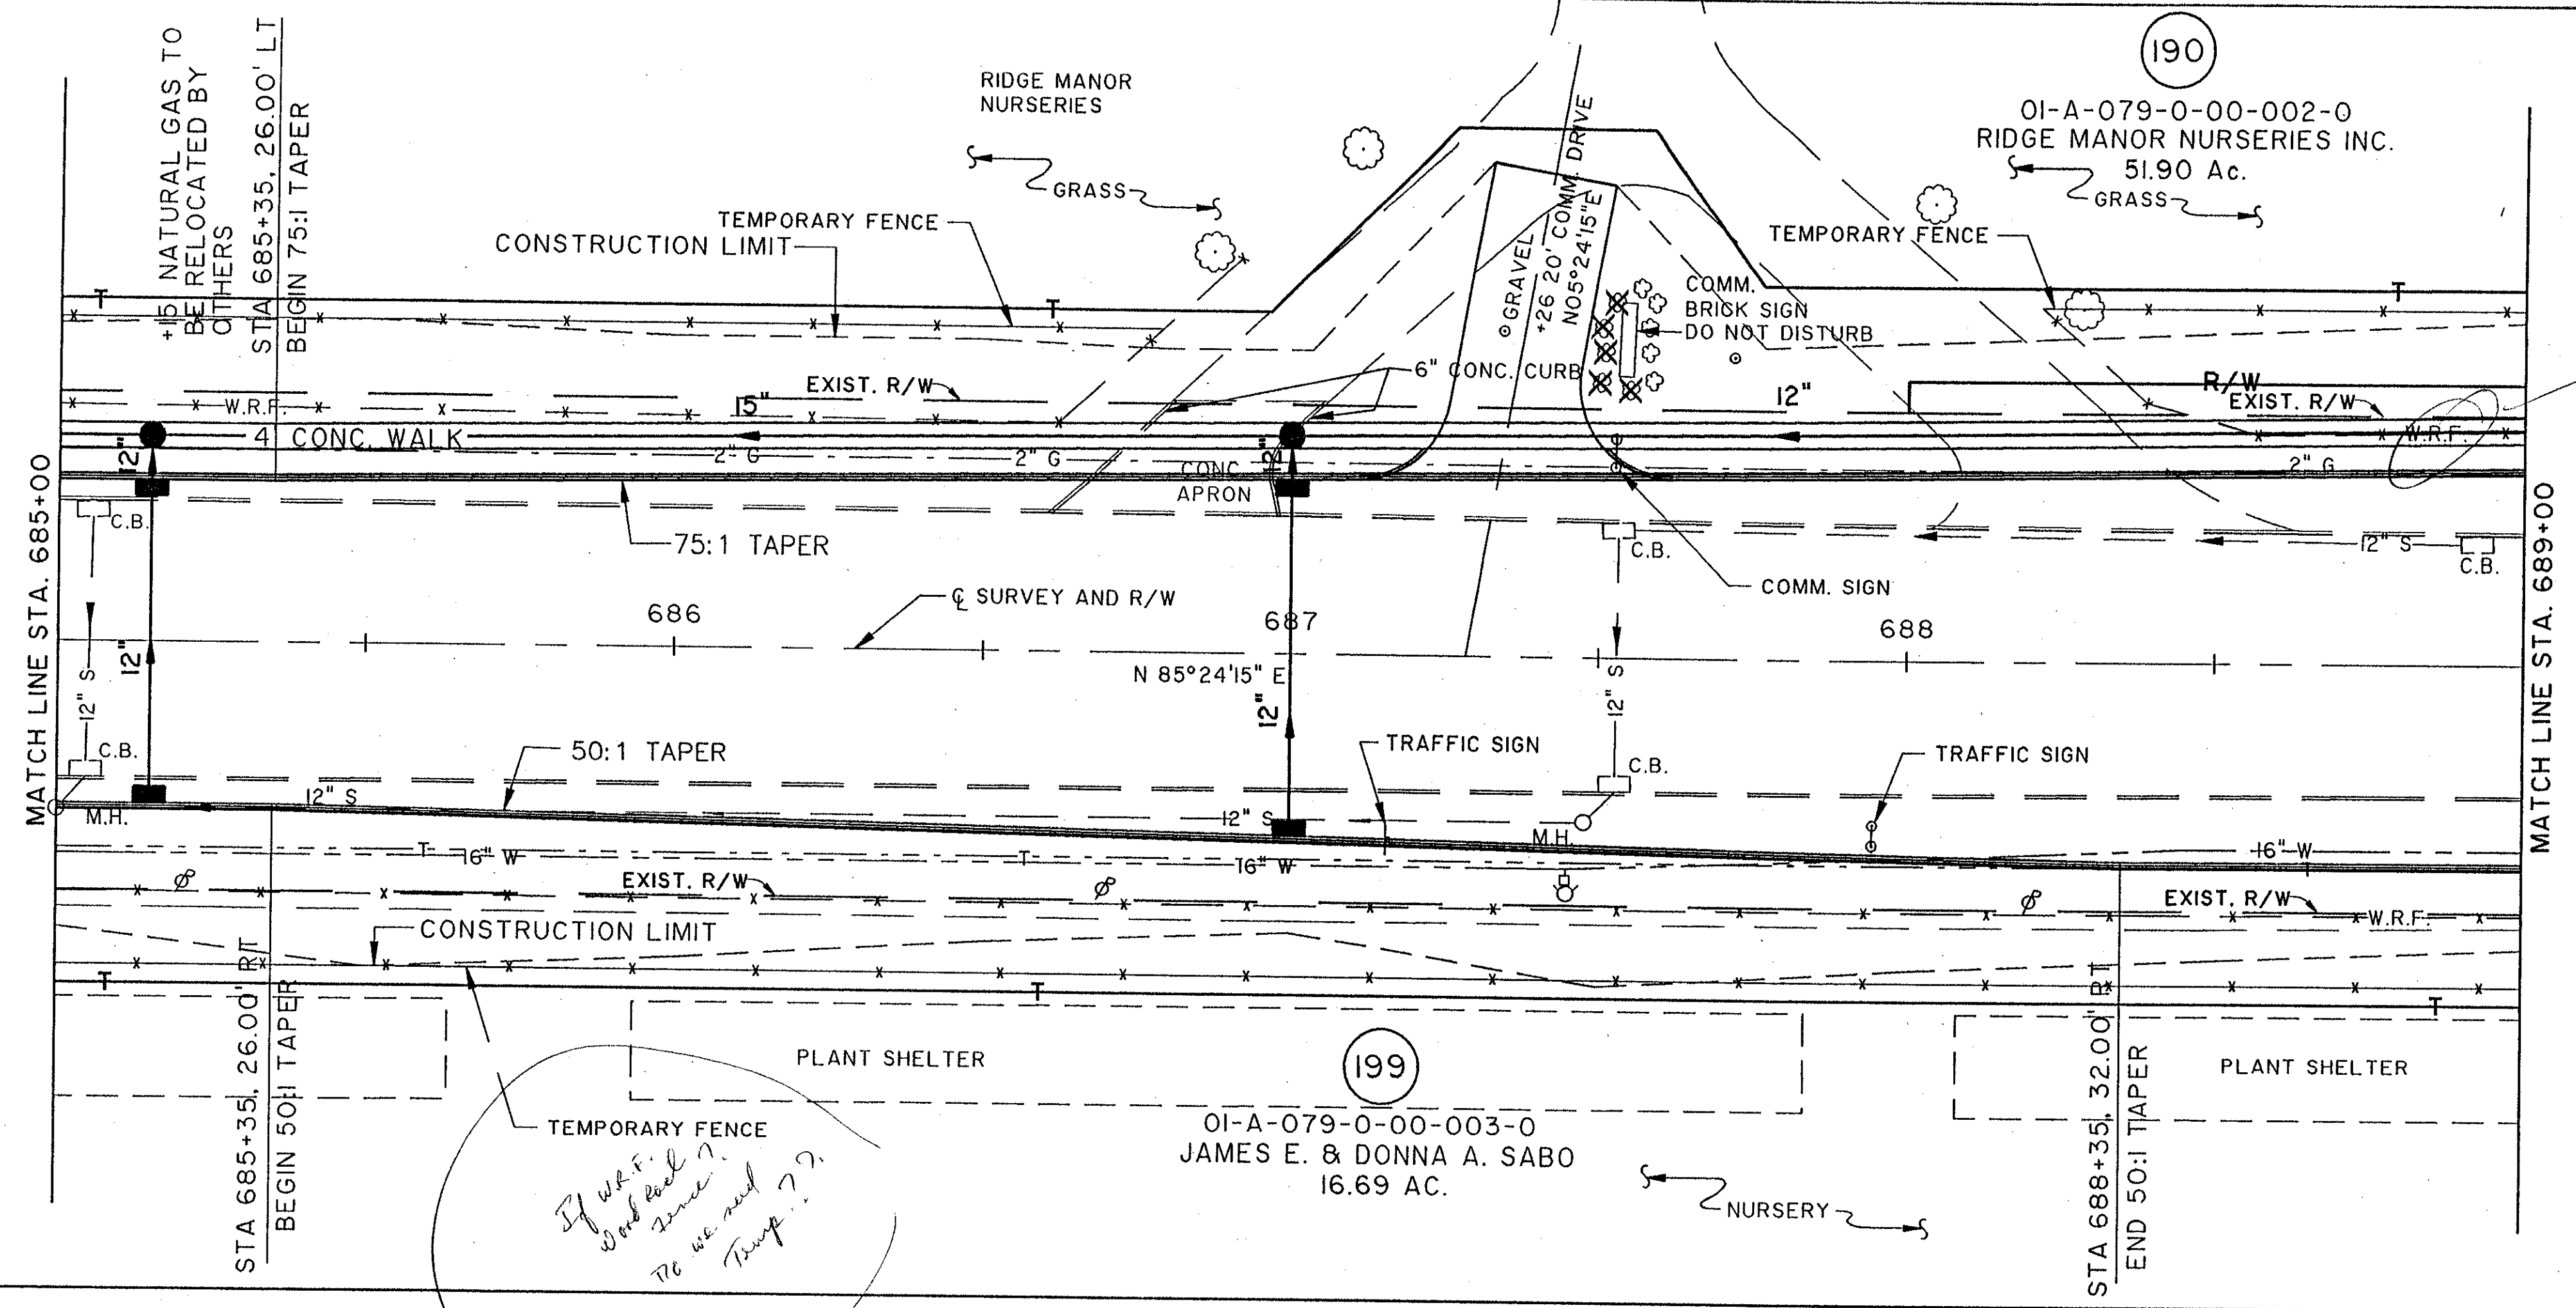

LAKE COUNTY
MADISON TOWNSHIP
TRACT I
LOT 4

NOTE:
EXISTING RIGHT OF WAY LOCATION
AND WIDTH DETERMINED FROM:
- PRIOR RIGHT OF WAY PLAN, DATED 1940.
- SURVEY BY: WESTERN RESERVE ENGINEERING
& SURVEYING CO., 1992

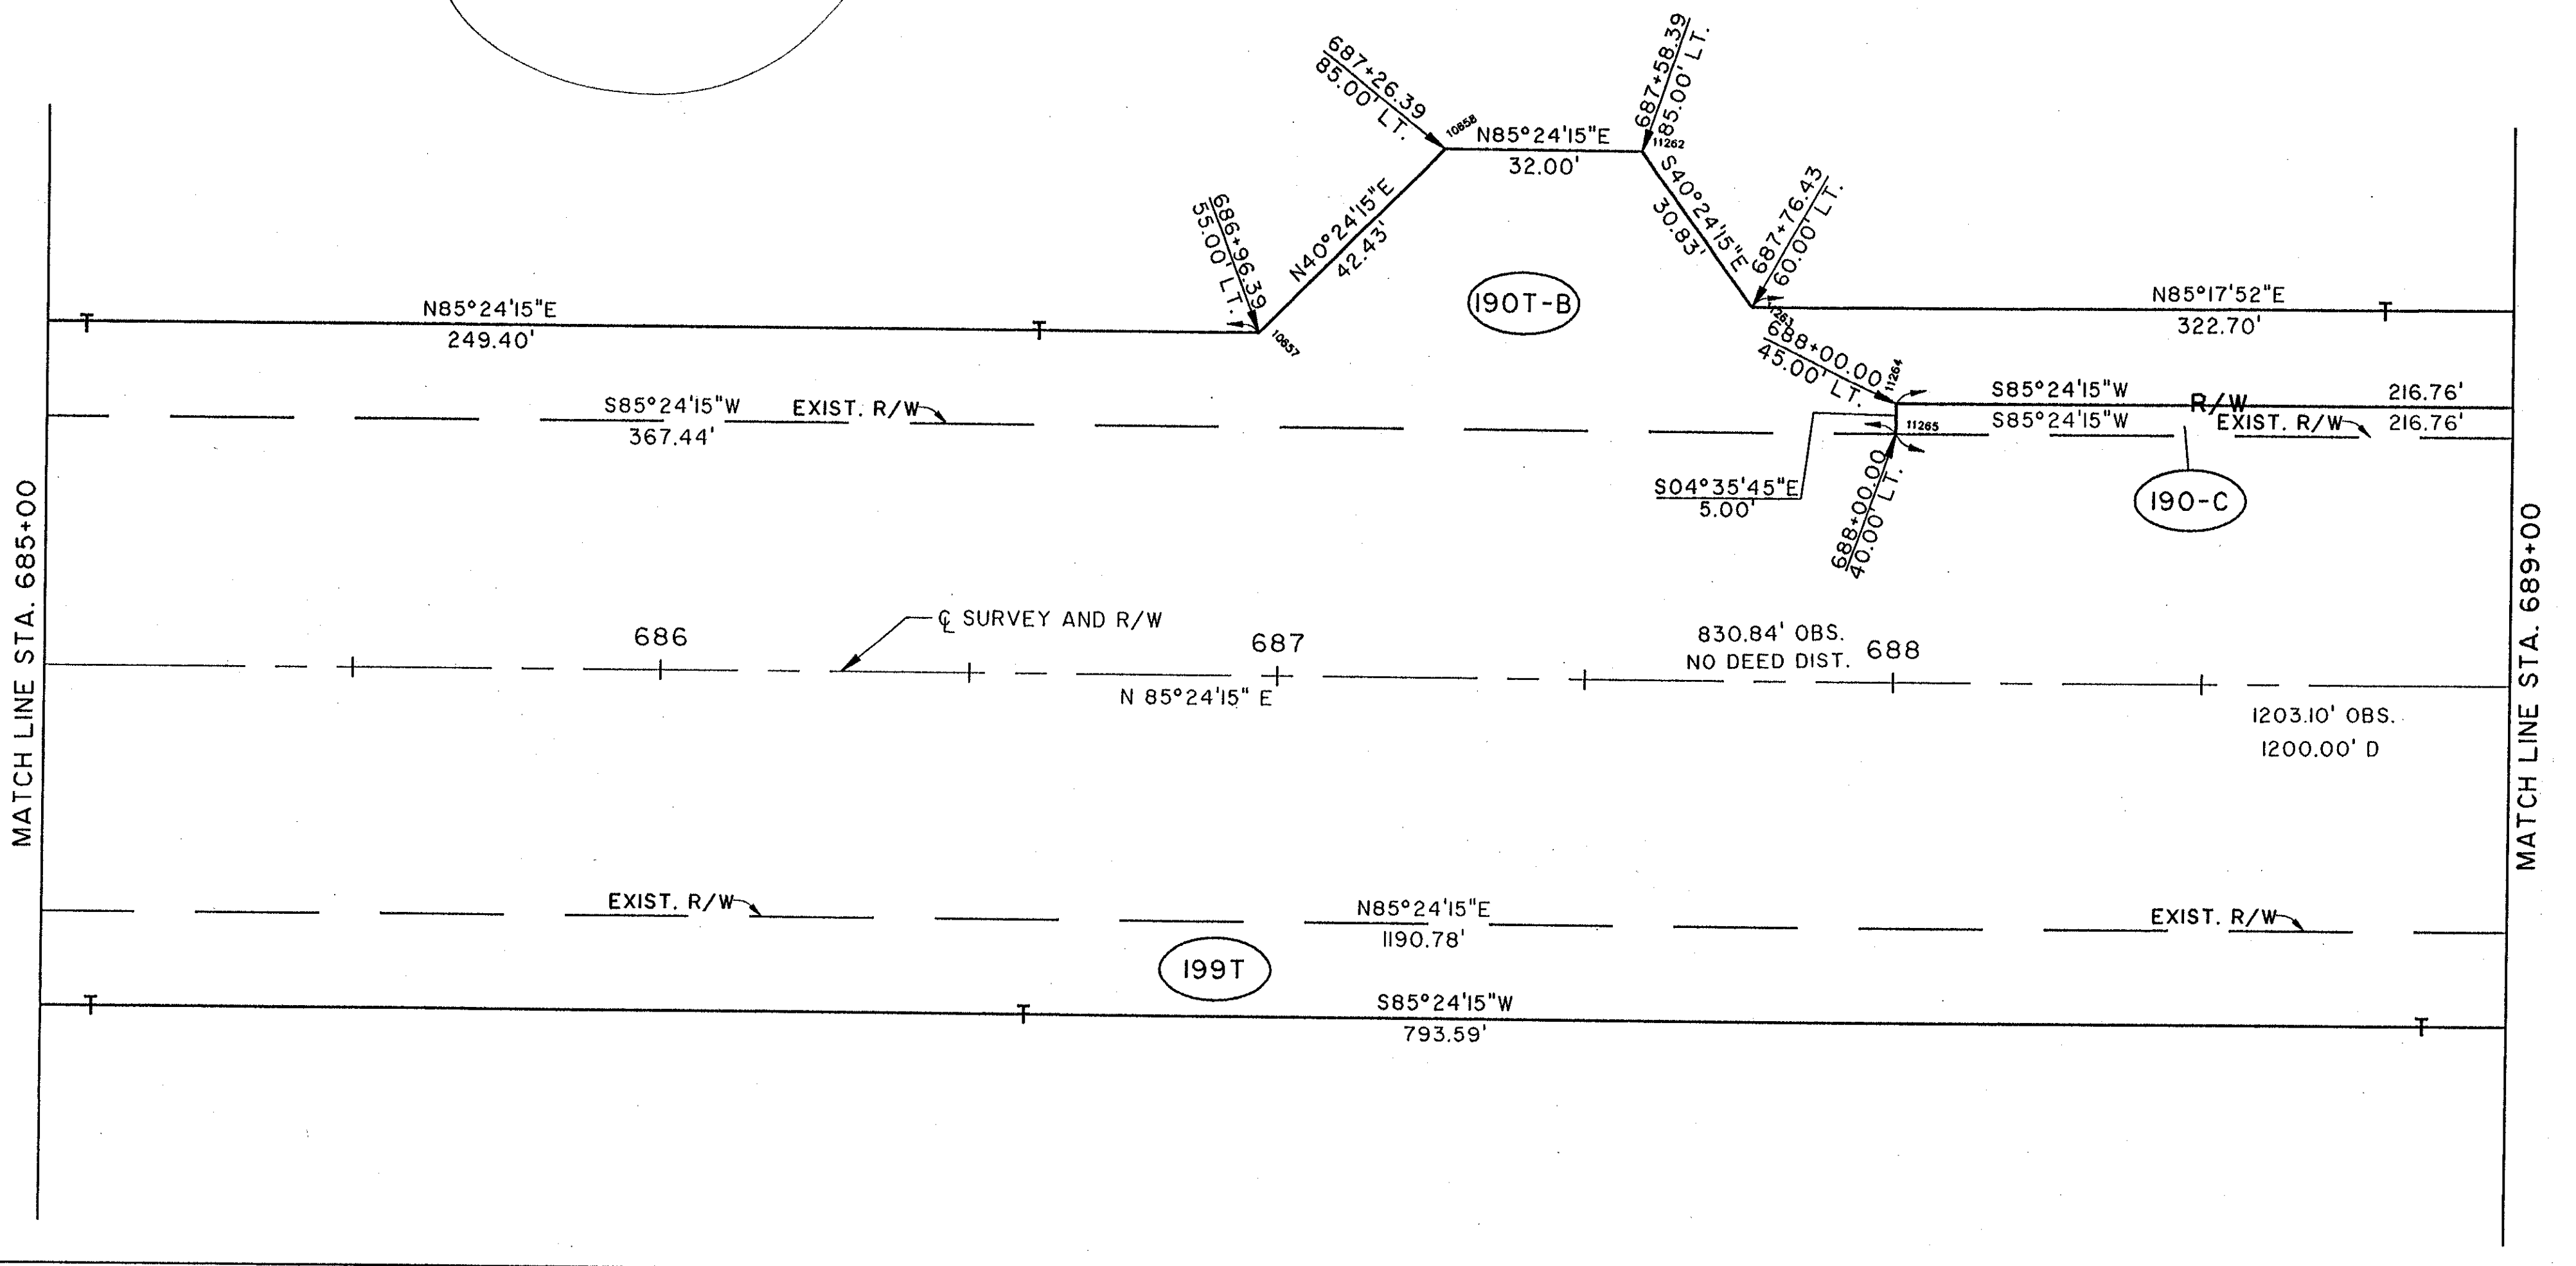

COMPLETION DATE:		
REV.	DATE	DESCRIPTION

RIGHT OF WAY PLAN STA. 685+00 TO STA. 689+00

Filename: K:\A\1\0007\9975\STRUCT\99755874
Plot Scale: 1"=40'
Drawn By/Date: RCK / 03-03-94 (12)

NORTH RIDGE ROAD (U.S. 20)