


- B.M. #1 Sta. 63+65
x on S.E. cor. of stone step to store
33' to L. of R.
Elev. = 686.48
- B.M. #2 Sta. 68+25
Spike in root 15" poplar
35' to L. of R.
Elev. = 684.64
- B.M. #3 Sta. 73+62
Spike in root 12" H. cherry
38' to L. of R.
Elev. = 683.74
- B.M. #4 Sta. 79+17
Spike in side 12" buckeye
34' to R. of R.
Elev. = 683.84
- B.M. #5 Sta. 83+98
Spike in root of 15" buckeye
33' to R. of R.
Elev. = 683.05
- B.M. #6 Sta. 88+85
Spike in root 12" Maple
35' to R. of R.
Elev. = 684.32

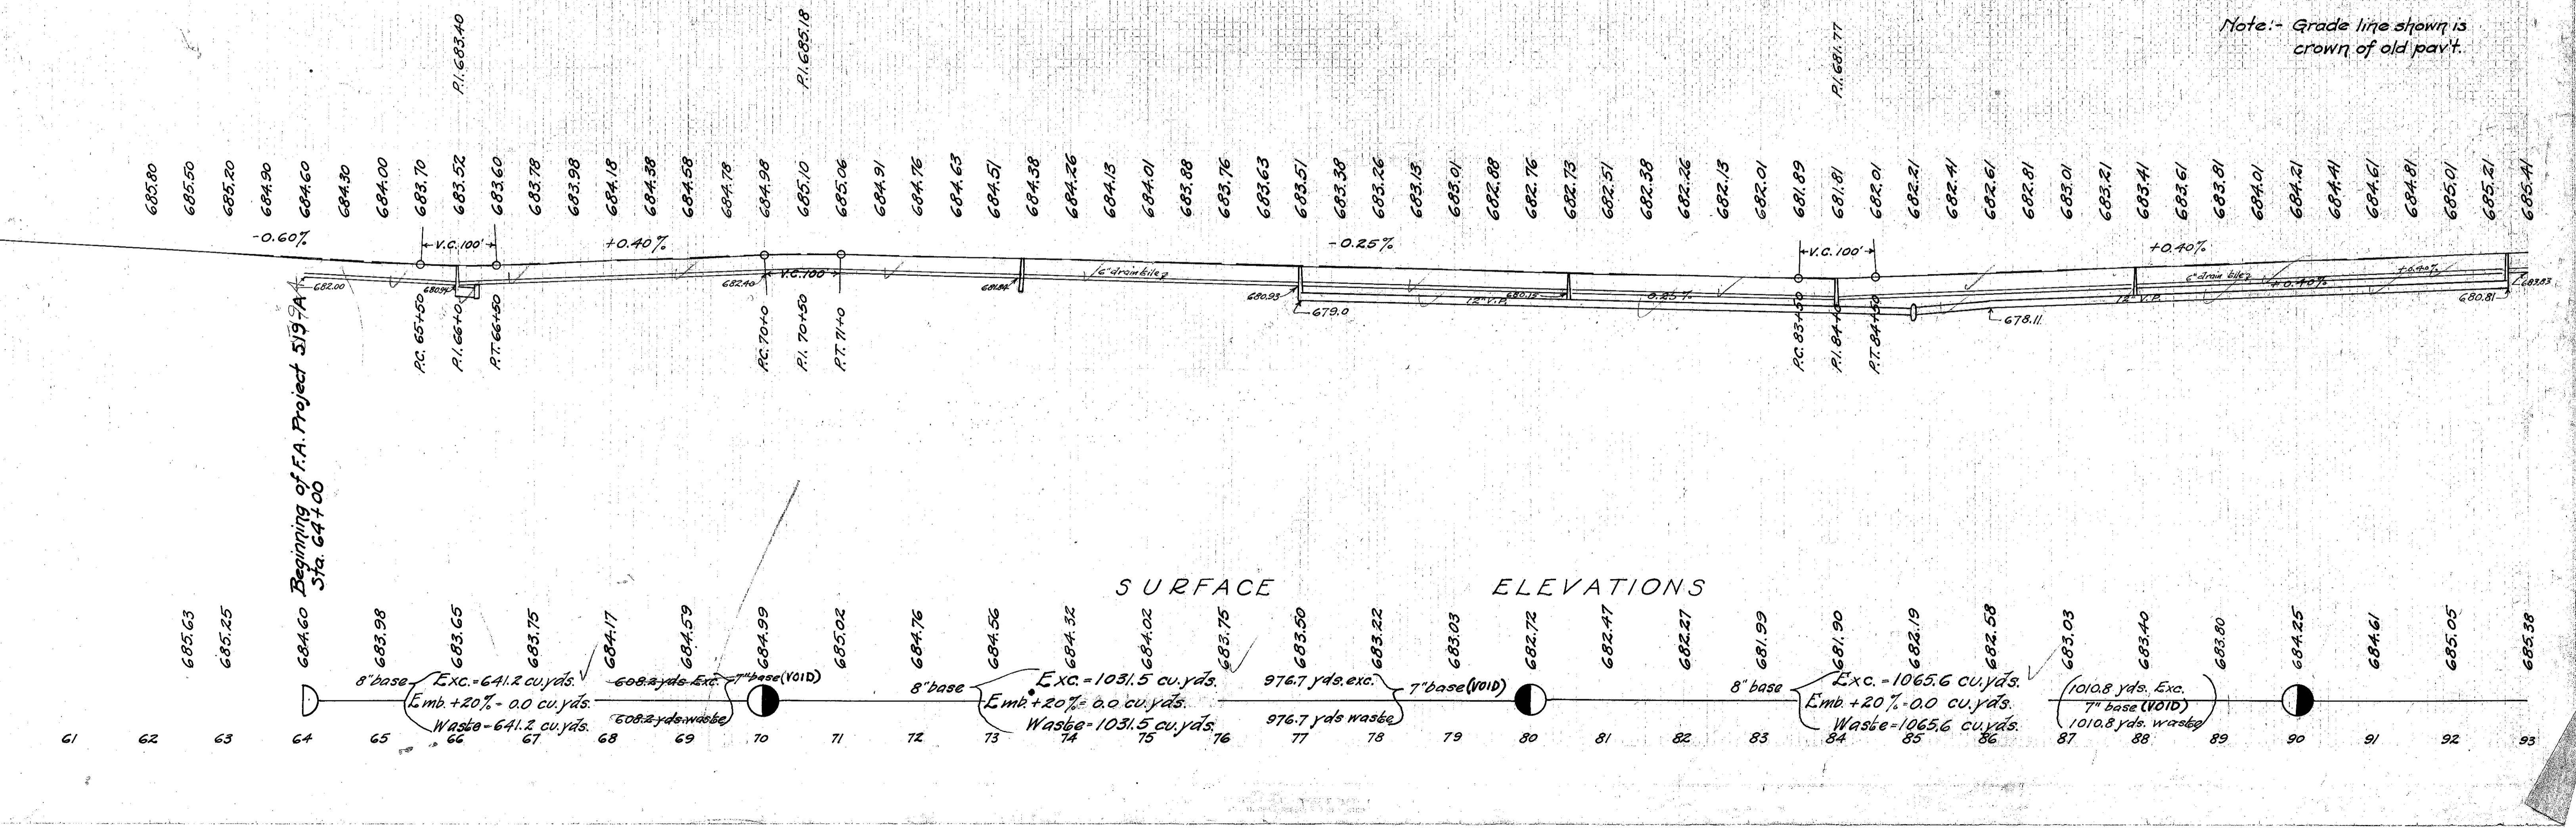

Note: - Grade line shown is crown of old pavt.