FED. AID PROJECT	STATE	FED. RD DIST. No	FISCAL YEAR
E-a 2nd Rd	OHIO	10	1932

9
31

S.H. No. 2 Sec. J Pt. Widening
LAKE COUNTY

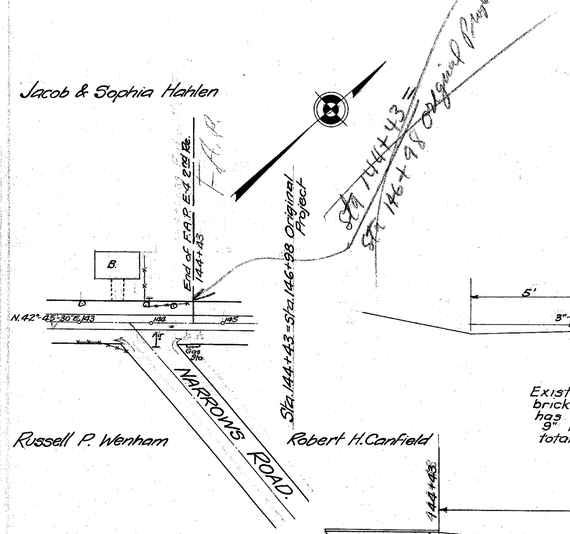

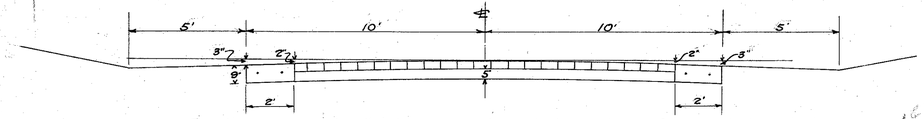

Existing pavement adjoining end of project consists of a monolithic brick pavement 16' wide ("4" lug brick on a 5" 1-7½ conc base) which has been widened on both edges with 2' strips of 1:5½ concrete 9" in thickness and including 2 - 1/2" ϕ longitudinal bars, making a total width of road metal of 20'.

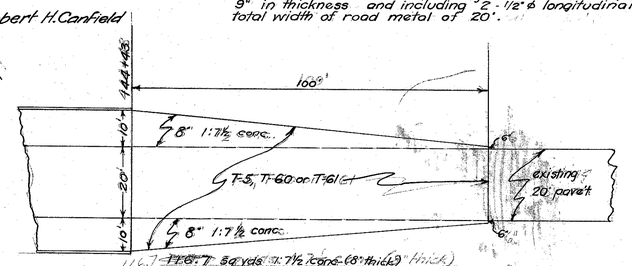

Detail of Transition at end of Project

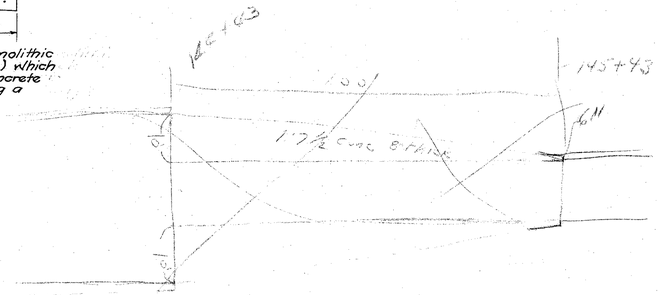

122.2 Sq yds 1:7½ conc
122.2 Sq yds T-5, T-60 or T-61

Detail of transition at end of project

Grade line shown is crown of finished pavement

687.76 687.80 687.84 687.88 687.82 687.76 687.68 687.59 687.51 687.34 687.177 687.000

+0.16% -0.24% -0.34%

End of F.A.P. E-a 2nd Rd. Sta. 144+43

SURFACE ELEVATIONS

687.58 687.62 687.67 687.74 687.63 687.62 687.49 687.43 687.33 687.177 687.00 686.855

143 144 145